



1. SEE SHEET E001 FOR GENERAL NOTES AND E002 FOR SYMBOL LEGEND.
2. SEE CONTRACT DETAILS AND CONTRACT SPECIFICATIONS FOR ADDITIONAL INFORMATION REGARDING INSTALLATION OF LIGHT FIXTURES, SIGNS, ASSOCIATED CONDUIT, CABLE AND APPURTENANCES.
3. AIRFIELD LIGHTING FIXTURES SHALL BE CONNECTED IN THE SERIES CIRCUIT IN THE SEQUENCE SHOWN IN THE CONTRACT DOCUMENTS. THE "RETURN" CONDUCTOR SHALL NOT BE CONNECTED TO ANY AIRFIELD LIGHTING FIXTURES. SEE SPECIFICATION L-111 FOR FURTHER DETAILS.
4. EACH FIXTURE SHALL BE INDIVIDUALLY BONDED TO THE BASE CAN WITH A #6 AWG STRANDED COPPER, GREEN THWN-2 INSULATED BONDING JUMPER. THE WIRE SHALL CONFORM TO ASTM B3, ASTM B8 AND ASTM B33

5. EACH FIELD LIGHTNING ARRESTOR ASSEMBLY SHALL BE INDIVIDUALLY BONDED TO THE BASE CAN WITH A #2 AWG STRANDED COPPER, GREEN THWN-2 INSULATED BONDING JUMPER. THE WIRE SHALL CONFORM TO ASTM B3, ASTM B8 AND ASTM B33.
6. EACH SIGN SHALL BE BONDED TO THE SIGN GROUND ROD WITH A #2 AWG STRANDED COPPER GREEN THWN-2 INSULATED BONDING JUMPER. THE WIRE SHALL CONFORM TO ASTM B3, ASTM B8 AND ASTM B33. THE SIGN BONDING JUMPER SHALL BE SIX INCHES LONGER THAN THE SIGN TETHERS TO ALLOW THE TETHERS TO PROPERLY OPERATE.
7. THE CONTRACTOR SHALL MANDREL EACH INDIVIDUAL NEW CONDUIT AND EACH EXISTING CONDUIT TO BE UTILIZED IN THE PROJECT.
8. THE CONTRACTOR SHALL SWAB OUT ALL CONDUITS/DUCTS AND CLEAN ALL BASE CAN, MANHOLE, PULL BOXES, ETC. INTERIORS IMMEDIATELY PRIOR TO PULLING CABLE. ONCE CLEANED AND SWABBED THE BASE CANS, MANHOLE, PULL BOXES, ETC. AND ALL ACCESSIBLE POINTS OF ENTRY TO THE DUCT/CONDUIT SYSTEM SHALL BE KEPT CLOSED EXCEPT WHEN INSTALLING CABLES. CLEANING OF DUCTS, BASE CANS, MANHOLES, ETC. IS INCIDENTAL TO THE CABLE INSTALLATION PAY ITEM. RACEWAY SYSTEMS LEFT OPEN, AFTER INITIAL CLEANING, FOR ANY REASON SHALL BE RECLEANED AT THE CONTRACTOR'S EXPENSE. ALL ACCESSIBLE POINTS SHALL BE KEPT CLOSED WHEN NOT INSTALLING CABLE. THE CONTRACTOR SHALL VERIFY EXISTING DUCTS PROPOSED FOR USE IN THIS PROJECT AS CLEAR AND OPEN. THE CONTRACTOR SHALL NOTIFY THE ENGINEER OF ANY BLOCKAGE IN THE EXISTING DUCTS.
9. SPECIFICATION SECTION L-111 REQUIRES SPECIFIC TESTING TO BE PERFORMED, RECORDED AND SUBMITTED AS PART OF THE CLOSE OUT DOCUMENTS. SEE SPECIFICATION L-106 AND L-111 FOR DETAILS OF TESTING AND SUBMITTAL REQUIREMENTS.

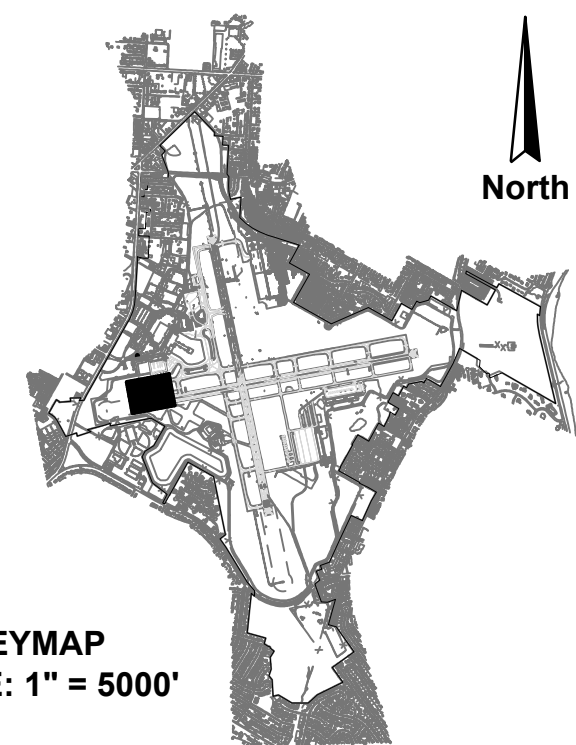

KEYMAP
SCALE: 1" = 5000'

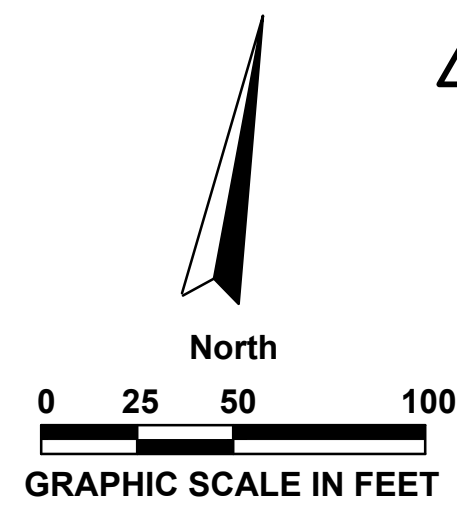

MATCH LINE - SEE SHEET E302

AVCON, INC.
ENGINEERS & PLANNERS

3298 SUMMIT BLVD., SUITE 26
PENSACOLA, FL. 32503
OFFICE: (850) 698-3526

CORPORATE CERTIFICATE OF
AUTHORIZATION NUMBER: 5057

www.avconinc.com

**TRANSFORMING TODAY'S IDEAS
INTO TOMORROW'S REALITY**

[illegible]

**AIRFIELD
LIGHTING
CIRCUITING PLAN
(SHEET 1 OF 11)**

ISSUED FOR BID DRAWINGS

RUNWAY 8-26 REHABILITATION


PREPARED FOR
PENSACOLA INTERNATIONAL AIRPORT

DESIGNED BY: SAH
DRAWN BY: KJF
CHECKED BY: MAG
APPROVED BY: VCL
PROJECT NO: 24.0359.01
DATE: MARCH 28, 2025

SHEET NUMBER
E301

N:\359 CITY OF PENSACOLA-AIRPORT\2024.0359.01-PNS RUNWAY 8-26\000 CAD\24035901_E301-E311.DWG 4/11/2025 10:22 AM

MATCH LINE - SEE SHEET E301

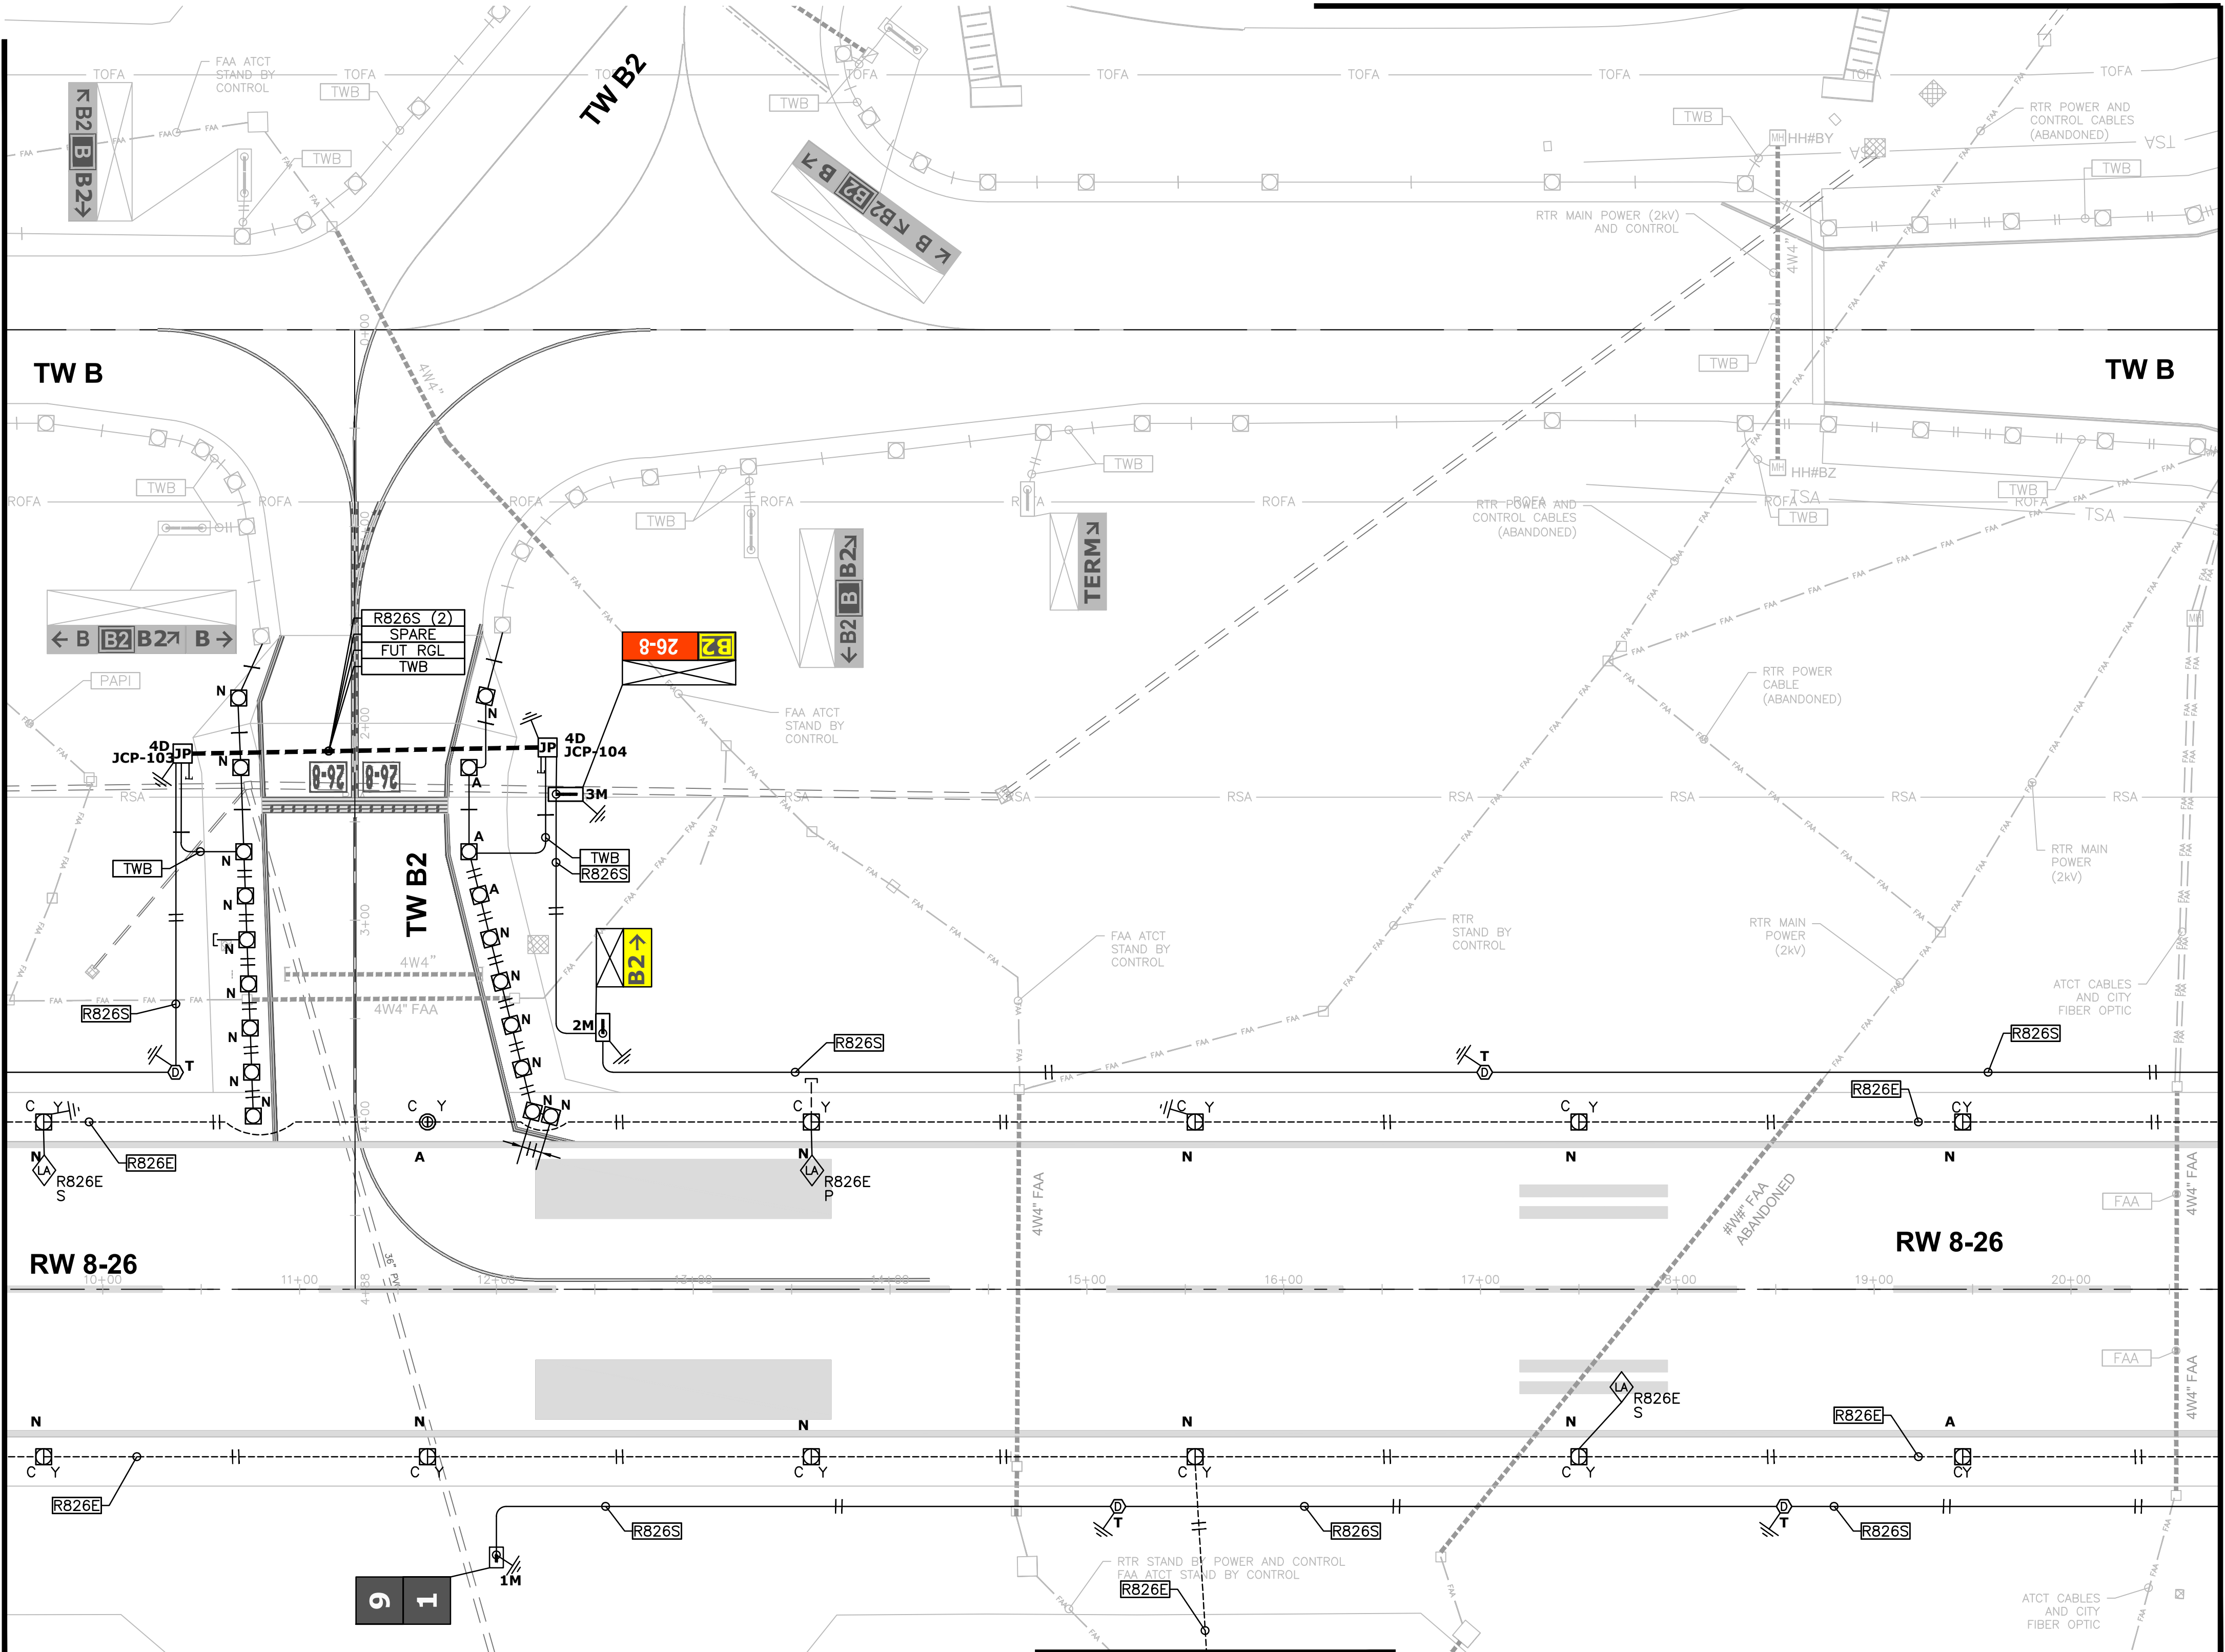




NOTES:

1. SEE SHEET E301 FOR GENERAL CIRCUITING NOTES.

MATCH LINE - THIS SHEET

MATCH LINE - SEE SHEET E303

MATCH LINE - THIS SHEET

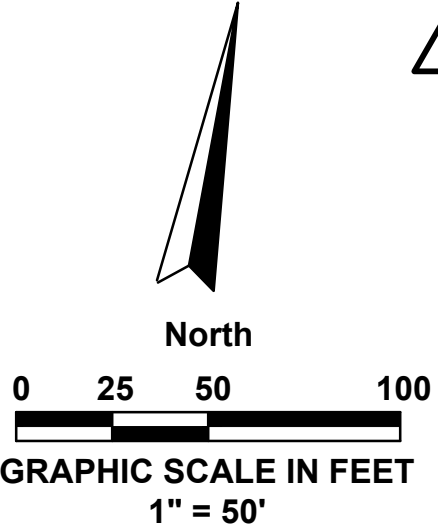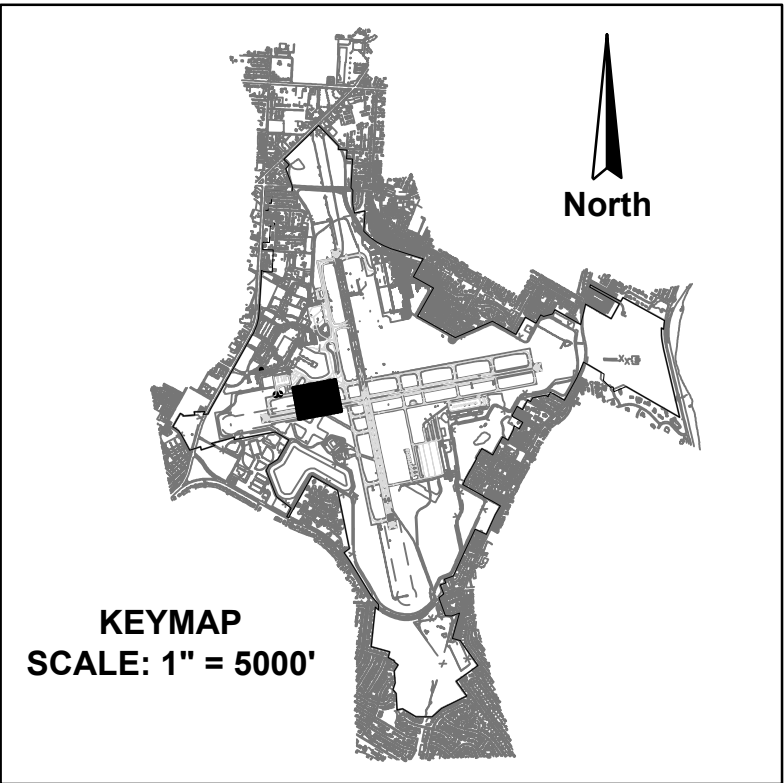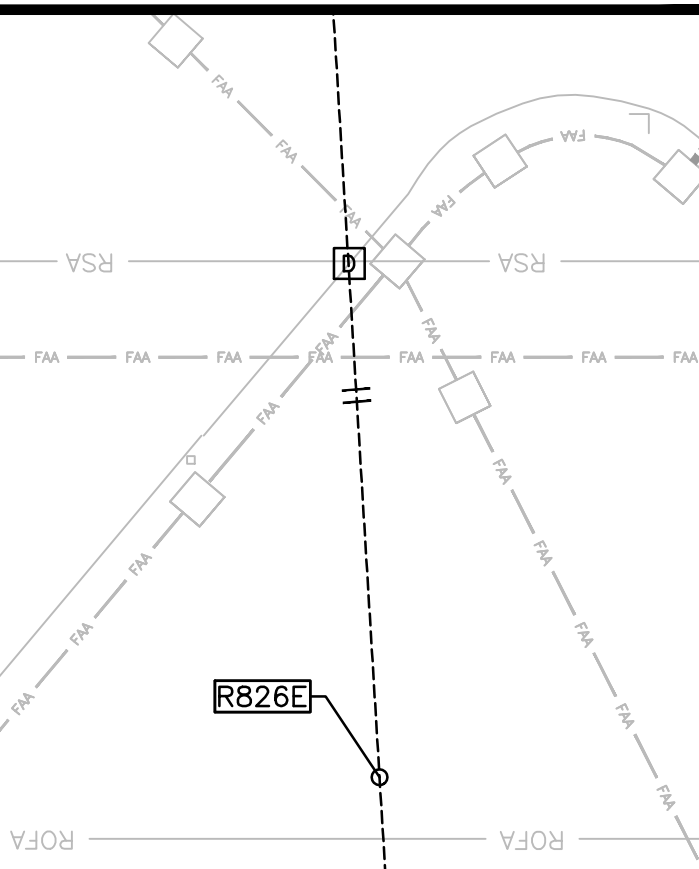

AIRFIELD
LIGHTING
CIRCUITING PLAN
(SHEET 2 OF 11)
ISSUED FOR BID DRAWINGS

RUNWAY 8-26
REHABILITATION
PREPARED FOR
PENSACOLA INTERNATIONAL AIRPORT

DESIGNED BY: SAH
DRAWN BY: KJF
CHECKED BY: MAG
APPROVED BY: VCL
PROJECT NO: 24.0359.01
DATE: MARCH 28, 2025

SHEET NUMBER
E302

AVCON, INC.
ENGINEERS & PLANNERS
3298 SUMMIT BLVD., SUITE 26
PENSACOLA, FL 32503
OFFICE: (850) 688-5526
CORPORATE CERTIFICATE OF
AUTHORIZATION NUMBER: 5057
WWW.AVCONINC.COM

TRANSFORMING TODAY'S IDEAS
INTO TOMORROW'S REALITY

NO.	DATE	REVISION	BY
1			
2			
3			
4/25 ADDENDUM 3

SAH

BY

REVISION

NO.

DATE

REVISION

BY

NO.

DATE

REVISION

BY



NO.

DATE


REVISION

N:\359 CITY OF PENSACOLA-AIRPORT\2024.0359.01-PNS RUNWAY 8-26\000 CAD\24035901_E301-E311.DWG 4/11/2025 10:22 AM

MATCH LINE - SEE SHEET E302

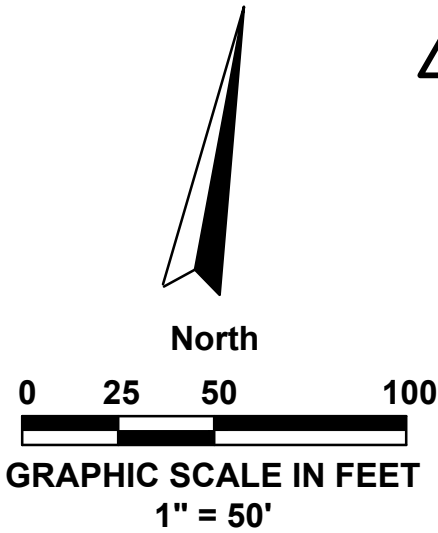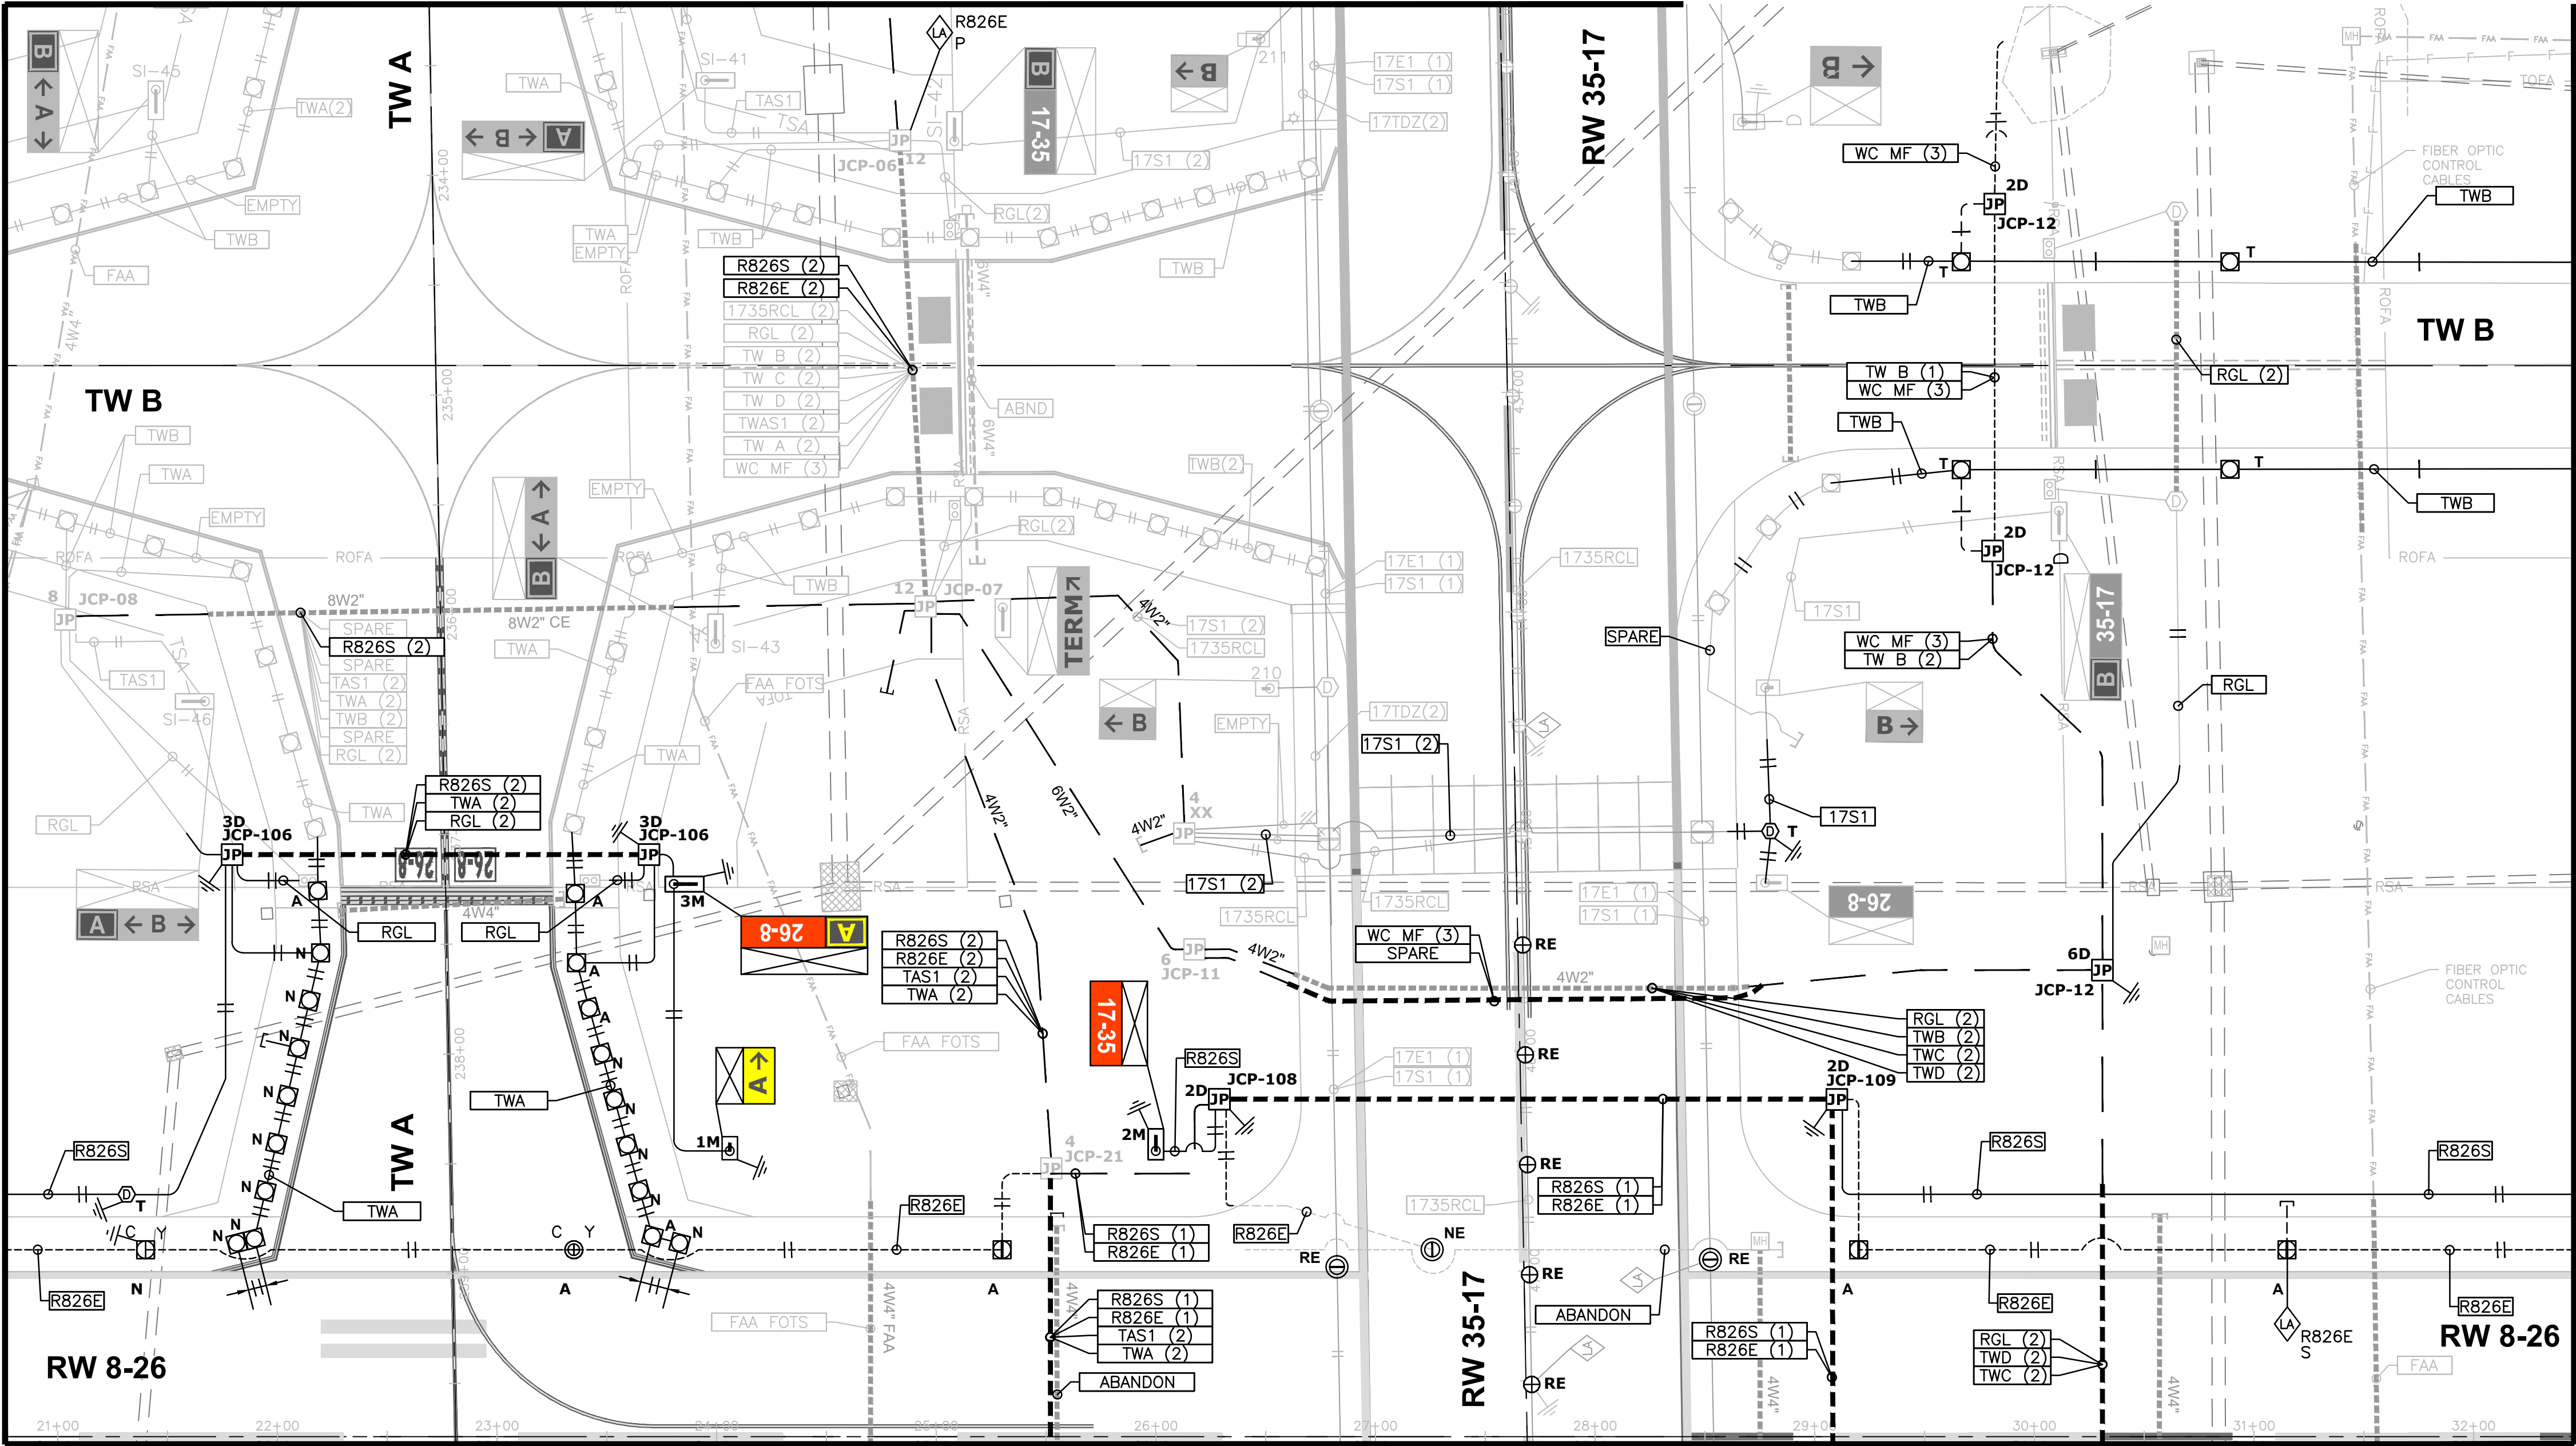

NOTES:
1. SEE SHEET E301 FOR GENERAL CIRCUITING NOTES.

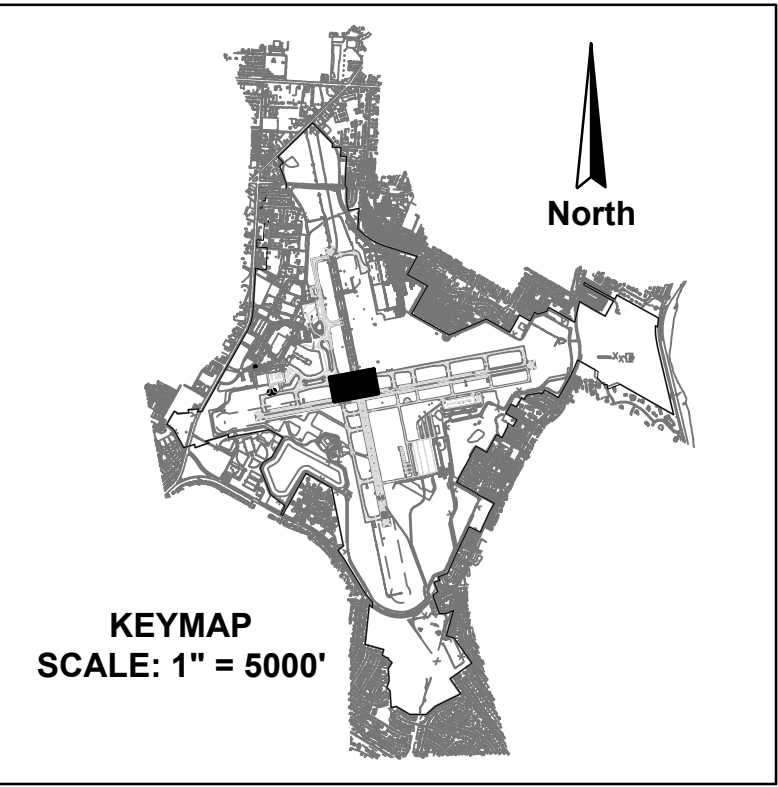

MATCH LINE - SEE SHEET E309

**RUNWAY 8-26
REHABILITATION**
PREPARED FOR
PENSACOLA INTERNATIONAL AIRPORT

**AIRFIELD
LIGHTING
CIRCUITING PLAN
(SHEET 3 OF 11)**
ISSUED FOR BID DRAWINGS

NO.	DATE	REVISION	BY
1	4/25	ADDENDUM 3	SAH
2			
3			
4			
5			
6			
7			
8			
9			
10			

AVCON, INC.
ENGINEERS & PLANNERS
3298 SUMMIT BLVD., SUITE 26
PENSACOLA, FL 32503
OFFICE: (850) 688-5526
CORPORATE CERTIFICATE OF
AUTHORIZATION NUMBER: 5057
WWW.AVCONINC.COM

TRANSFORMING TODAY'S IDEAS
INTO TOMORROW'S REALITY

DESIGNED BY: SAH
DRAWN BY: KJF
CHECKED BY: MAG
APPROVED BY: VCL
PROJECT NO: 24.0359.01
DATE: MARCH 28, 2025


**SHEET NUMBER
E303**

N:\359 CITY OF PENSACOLA-AIRPORT\2024.0359.01-PNS RUNWAY 8-26\000 CAD\24035901_E301-E311.DWG 4/11/2025 10:23 AM



NOTES:

1. SEE SHEET E301 FOR GENERAL CIRCUITING NOTES.

MATCH LINE - SEE SHEET E302

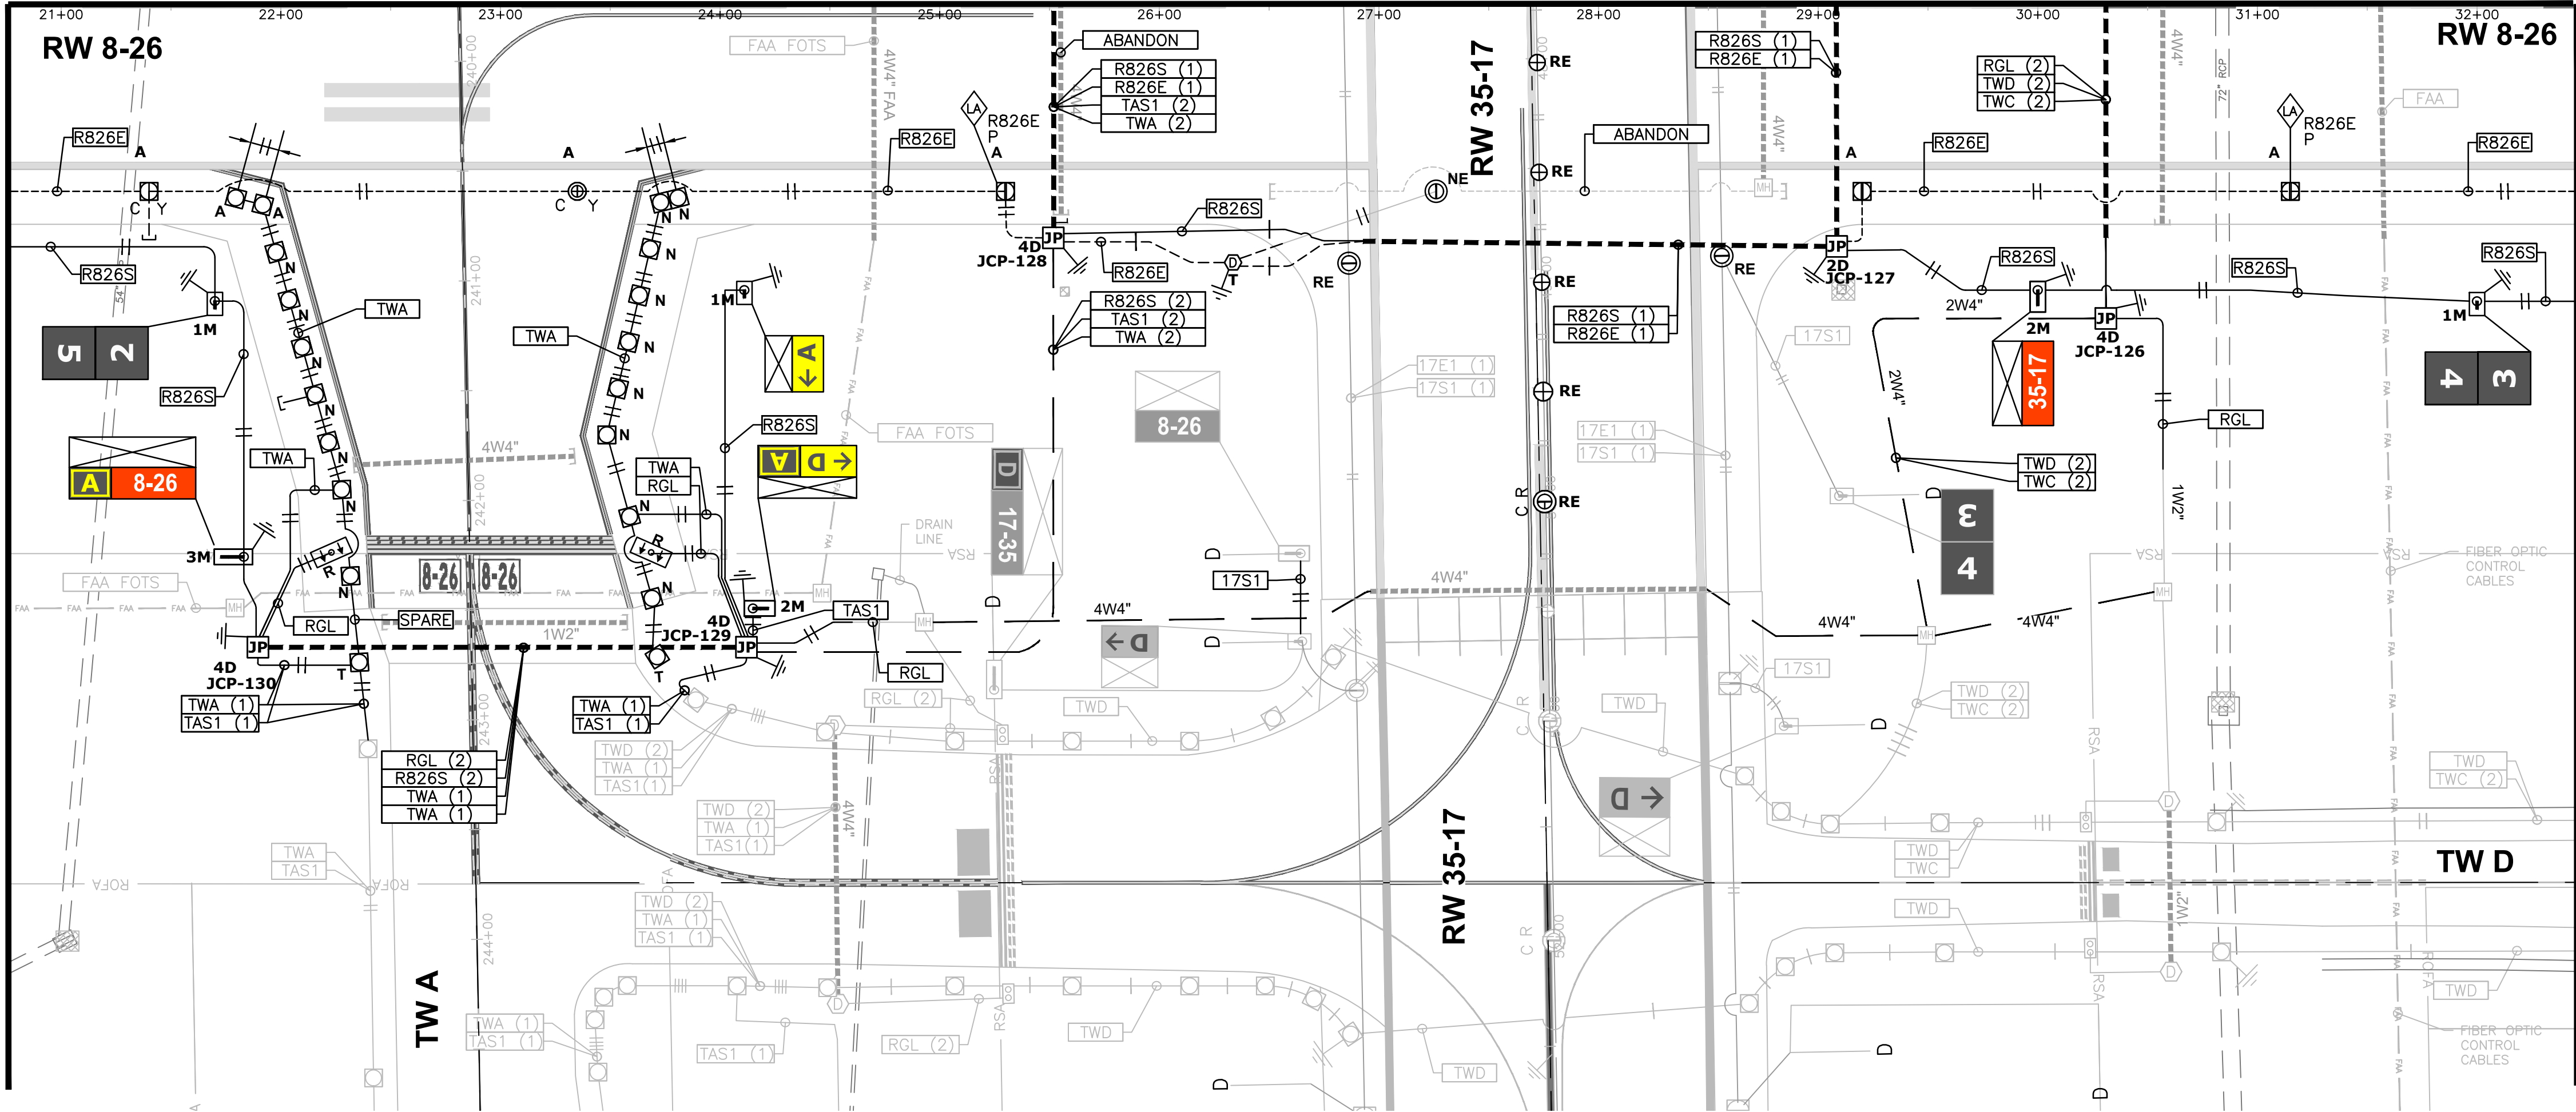

MATCH LINE - SEE SHEET E309

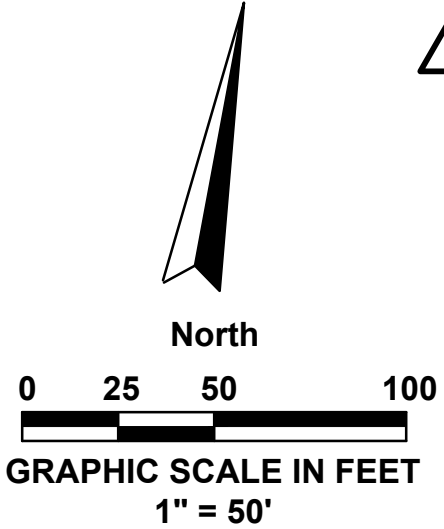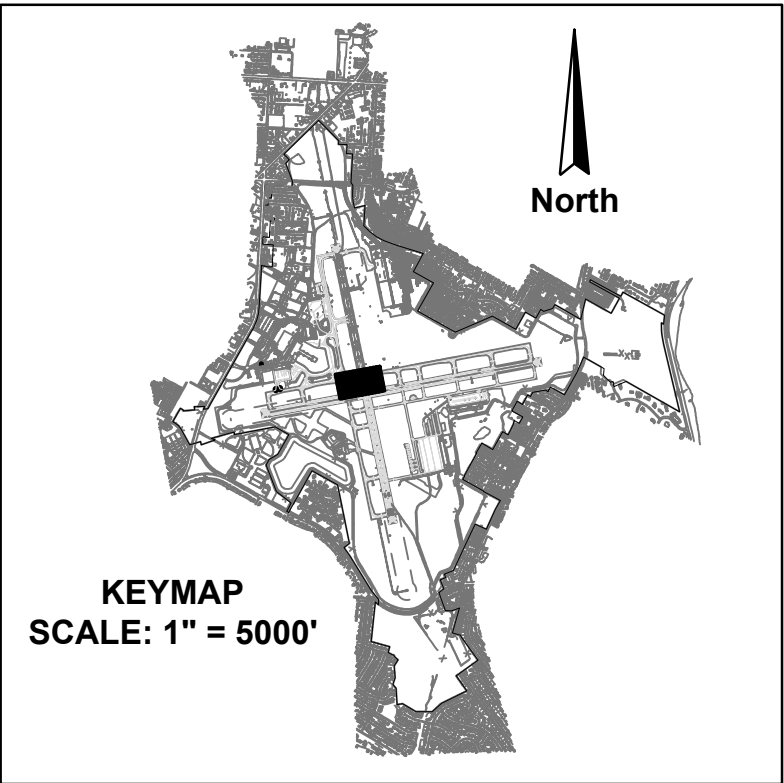

RUNWAY 8-26
REHABILITATION

PREPARED FOR
PENSACOLA INTERNATIONAL AIRPORT

AIRFIELD
LIGHTING
CIRCUITING PLAN
(SHEET 4 OF 11)
ISSUED FOR BID DRAWINGS

NO.	DATE	REVISION	BY
1	4/25	ADDENDUM 3	SAH
2			
3			
4			
5			
6			
7			
8			
9			
10			

DESIGNED BY: SAH
DRAWN BY: KJF
CHECKED BY: MAG
APPROVED BY: VCL
PROJECT NO: 24.0359.01
DATE: MARCH 28, 2025

SHEET NUMBER
E304

AVCON, INC.
ENGINEERS & PLANNERS
3298 SUMMIT BLVD., SUITE 26
PENSACOLA, FL 32503
OFFICE: (850) 688-5526
CORPORATE CERTIFICATE OF
AUTHORIZATION NUMBER: 5057
WWW.AVCONINC.COM

TRANSFORMING TODAY'S IDEAS
INTO TOMORROW'S REALITY




THIS DOCUMENT CONTAINS PRIVILEGED AND PROPRIETARY INFORMATION, ALL OF WHICH IS EXPRESSLY PROVIDED BY AVCON, INC., FOR USE BY THE INTENDED RECIPIENT, AND FOR A SPECIFIC PURPOSE. WITHOUT THE EXPRESS WRITTEN CONSENT OF AVCON, INC., ANY DISTRIBUTION, REPRODUCTION, OR OTHER USE OF THIS DOCUMENT, IN WHOLE OR IN PART, IS STRICTLY PROHIBITED.

N:\359 CITY OF PENSACOLA-AIRPORT\2024.0359.01-PNS RUNWAY 8-26\000 CAD\24035901_E301-E311.DWG 4/11/2025 10:23 AM

NOTES:

1. SEE SHEET E301 FOR GENERAL CIRCUITING NOTES.

MATCH LINE - SEE SHEET E304

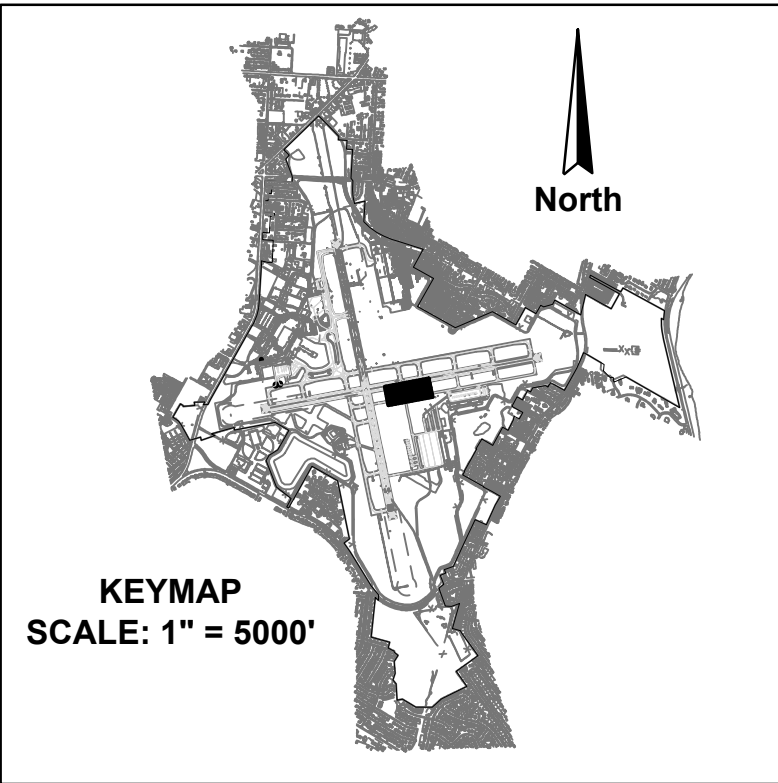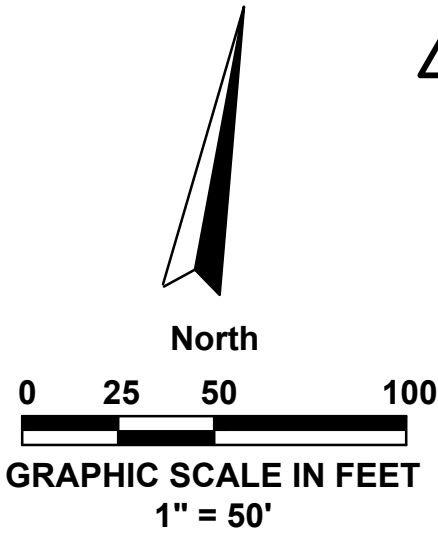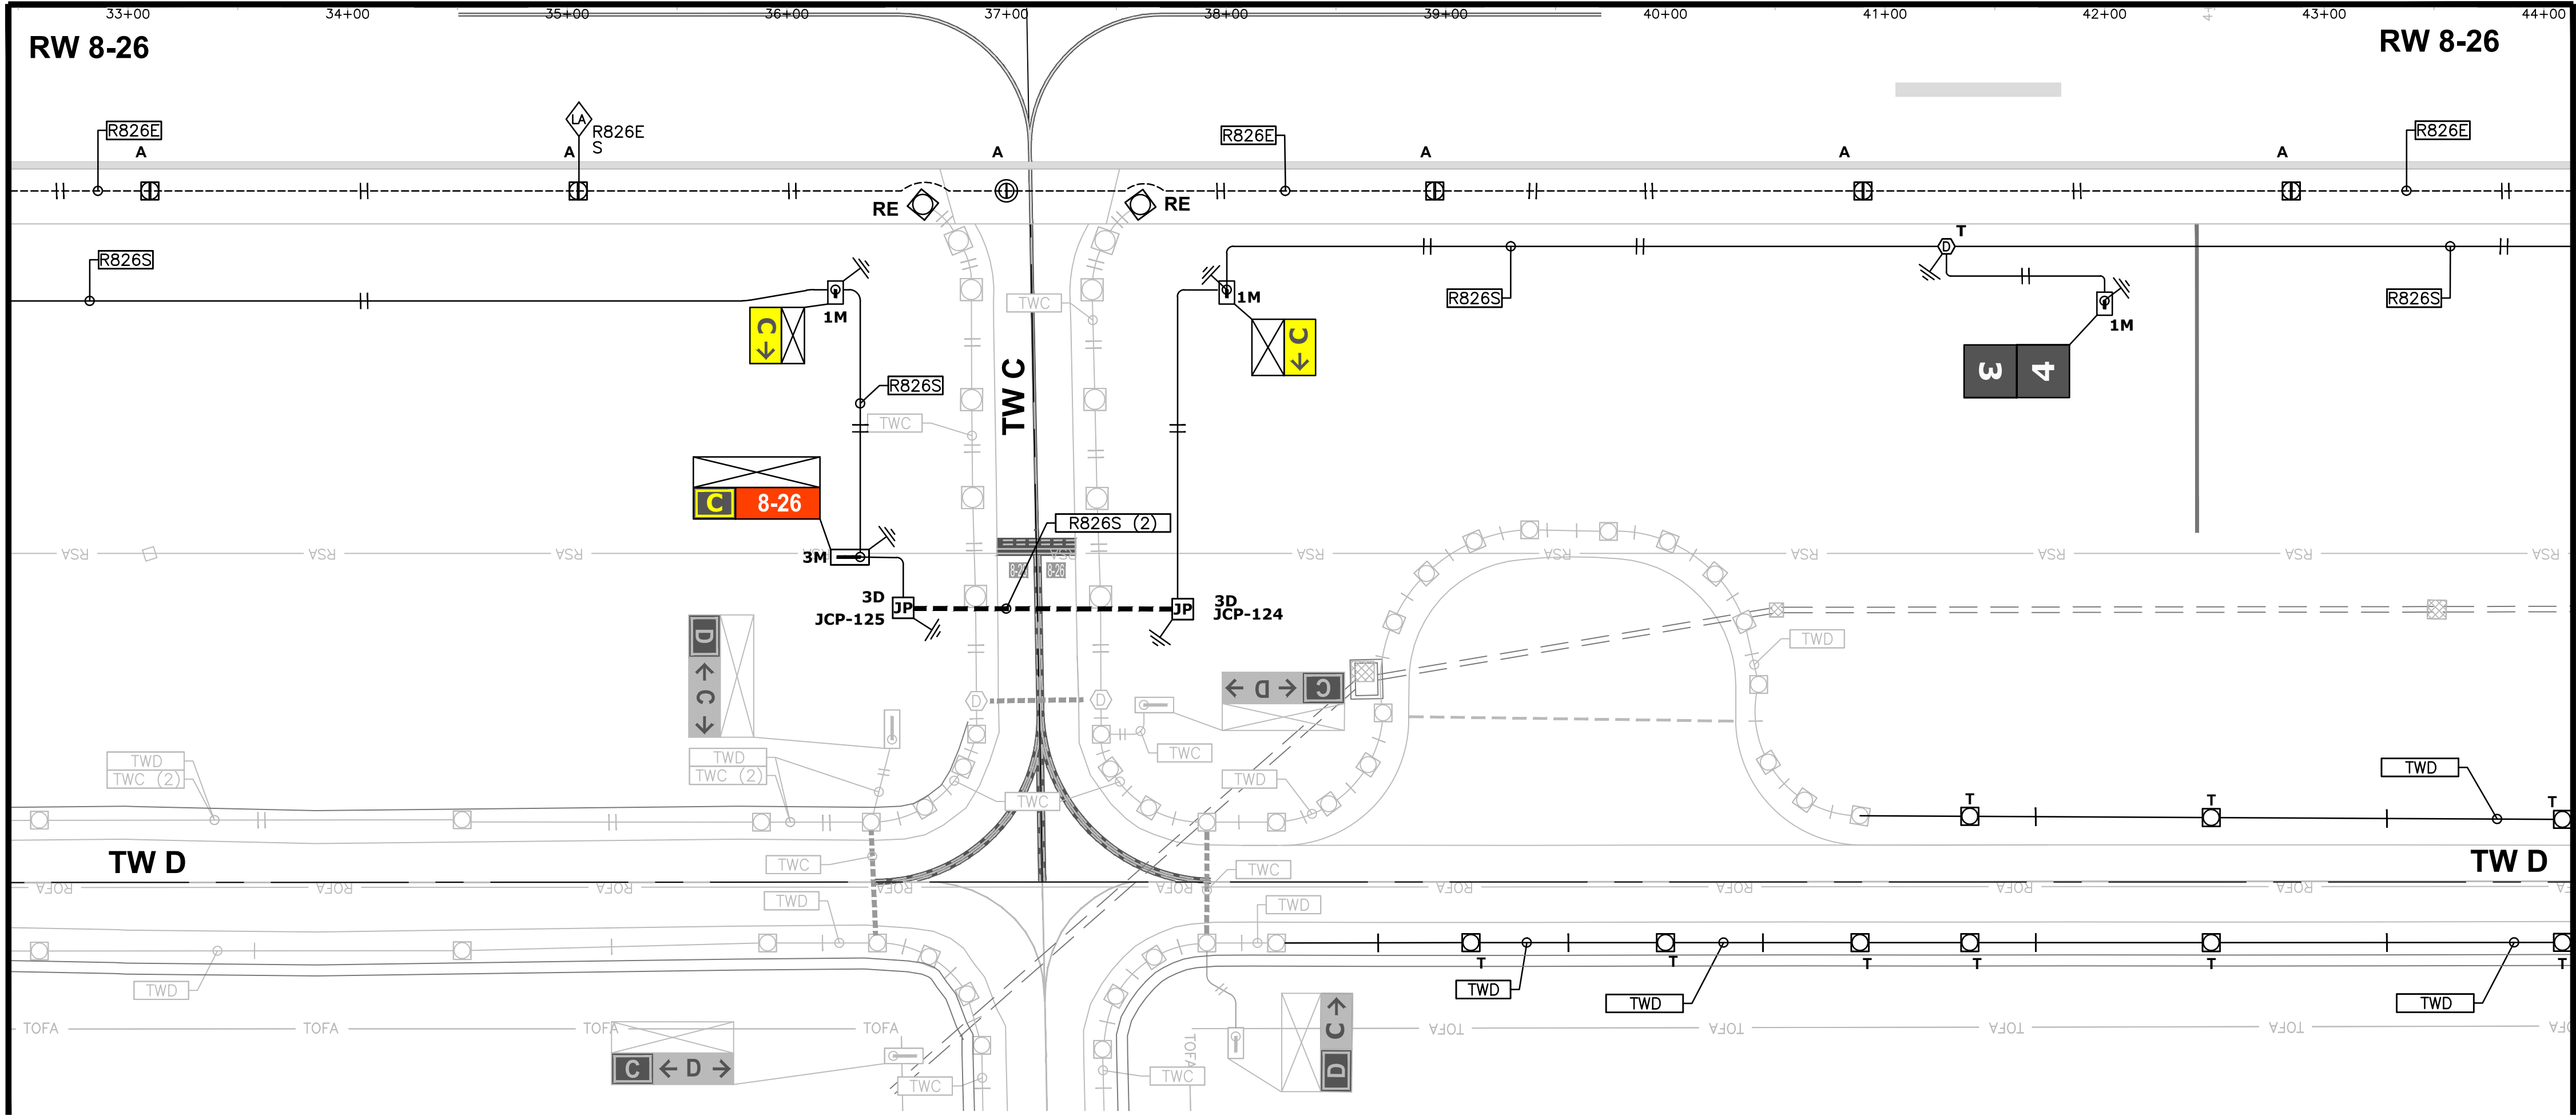

RUNWAY 8-26
REHABILITATION

PREPARED FOR
PENSACOLA INTERNATIONAL AIRPORT

AIRFIELD LIGHTING
CIRCUITING PLAN
(SHEET 6 OF 11)

ISSUED FOR BID DRAWINGS

DESIGNED BY: SAH
DRAWN BY: KJF
CHECKED BY: MAG
APPROVED BY: VCL
PROJECT NO: 24.0359.01
DATE: MARCH 28, 2025

SHEET NUMBER
E306


AVCON, INC.
ENGINEERS & PLANNERS

3298 SUMMIT BLVD., SUITE 26
PENSACOLA, FL 32503
OFFICE: (850) 688-5526
CORPORATE CERTIFICATE OF
AUTHORIZATION NUMBER: 5057
WWW.AVCONINC.COM

NO.	DATE	REVISION	BY
1	4/25	ADDENDUM 3	SAH


TRANSFORMING TODAY'S IDEAS
INTO TOMORROW'S REALITY

THIS DOCUMENT CONTAINS PRIVILEGED AND PROPRIETARY INFORMATION, ALL OF WHICH IS EXPRESSLY PROVIDED BY AVCON, INC., FOR USE BY THE INTENDED RECIPIENT, AND FOR A SPECIFIC PURPOSE. WITHOUT THE EXPRESS WRITTEN CONSENT OF AVCON, INC. ANY DISTRIBUTION, REPRODUCTION, OR OTHER USE OF THIS DOCUMENT, IN WHOLE OR IN PART, IS STRICTLY PROHIBITED.

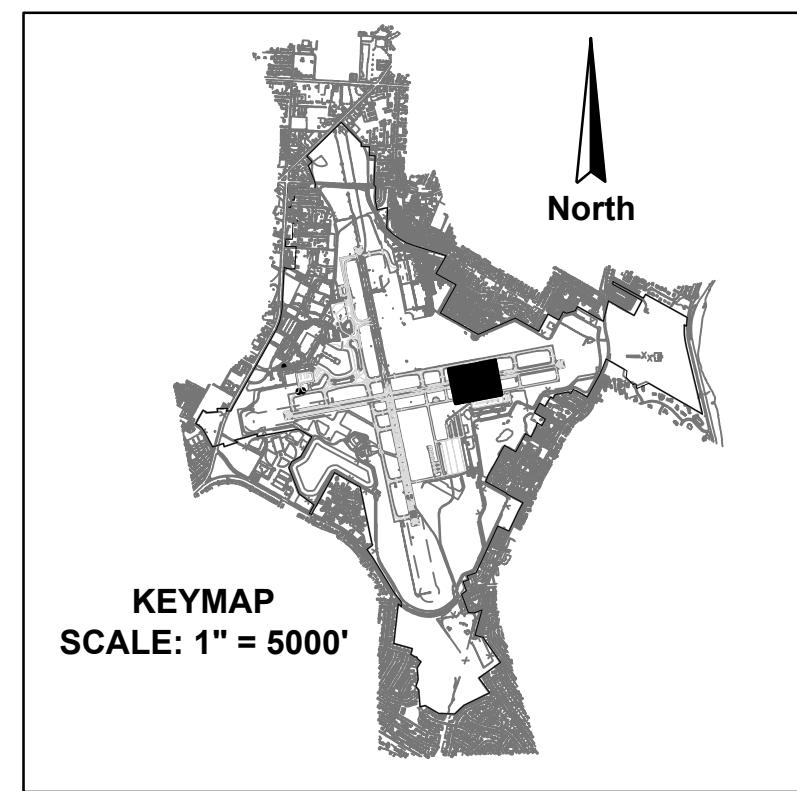[illegible]


N:\359 CITY OF PENSACOLA-AIRPORT\2024.0359.01-PNS RUNWAY 8-26\000 CAD\24035901_E301-E311.DWG 4/11/2025 10:24 AM

MATCH LINE - SEE SHEET E306


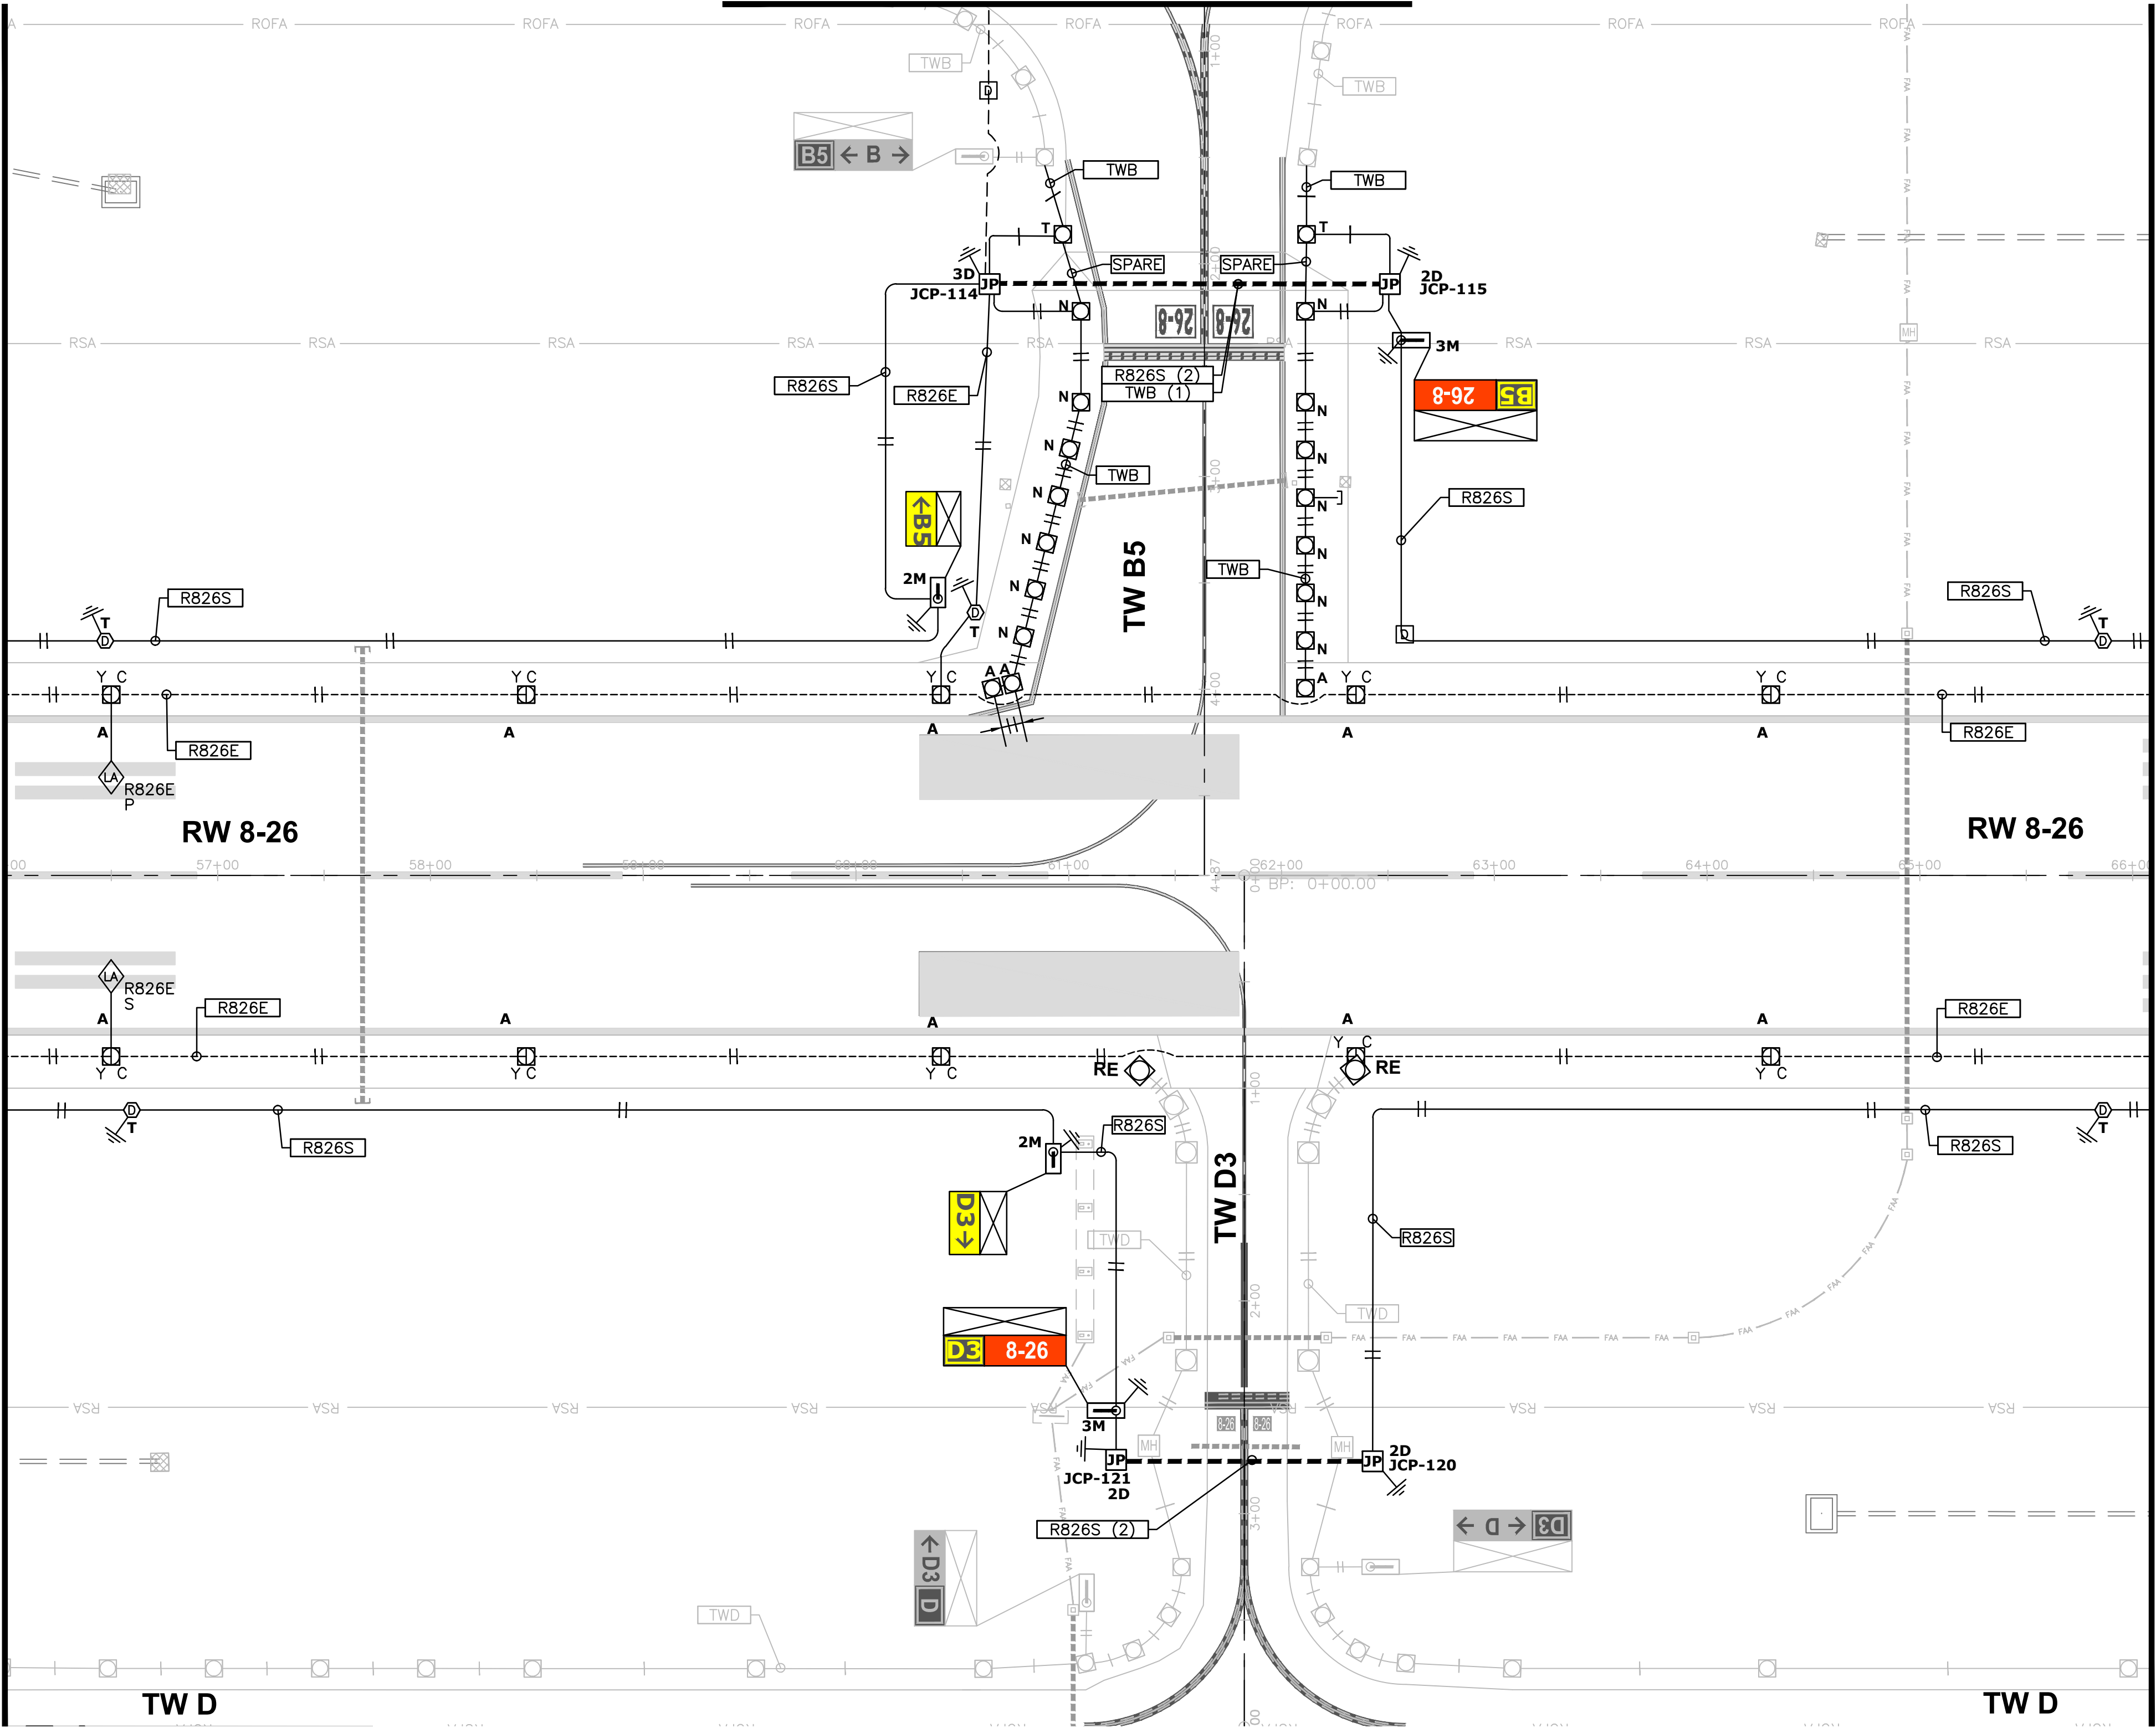


NOTES:
1. SEE SHEET E301 FOR GENERAL CIRCUITING NOTES.

MATCH LINE - SEE SHEET E307

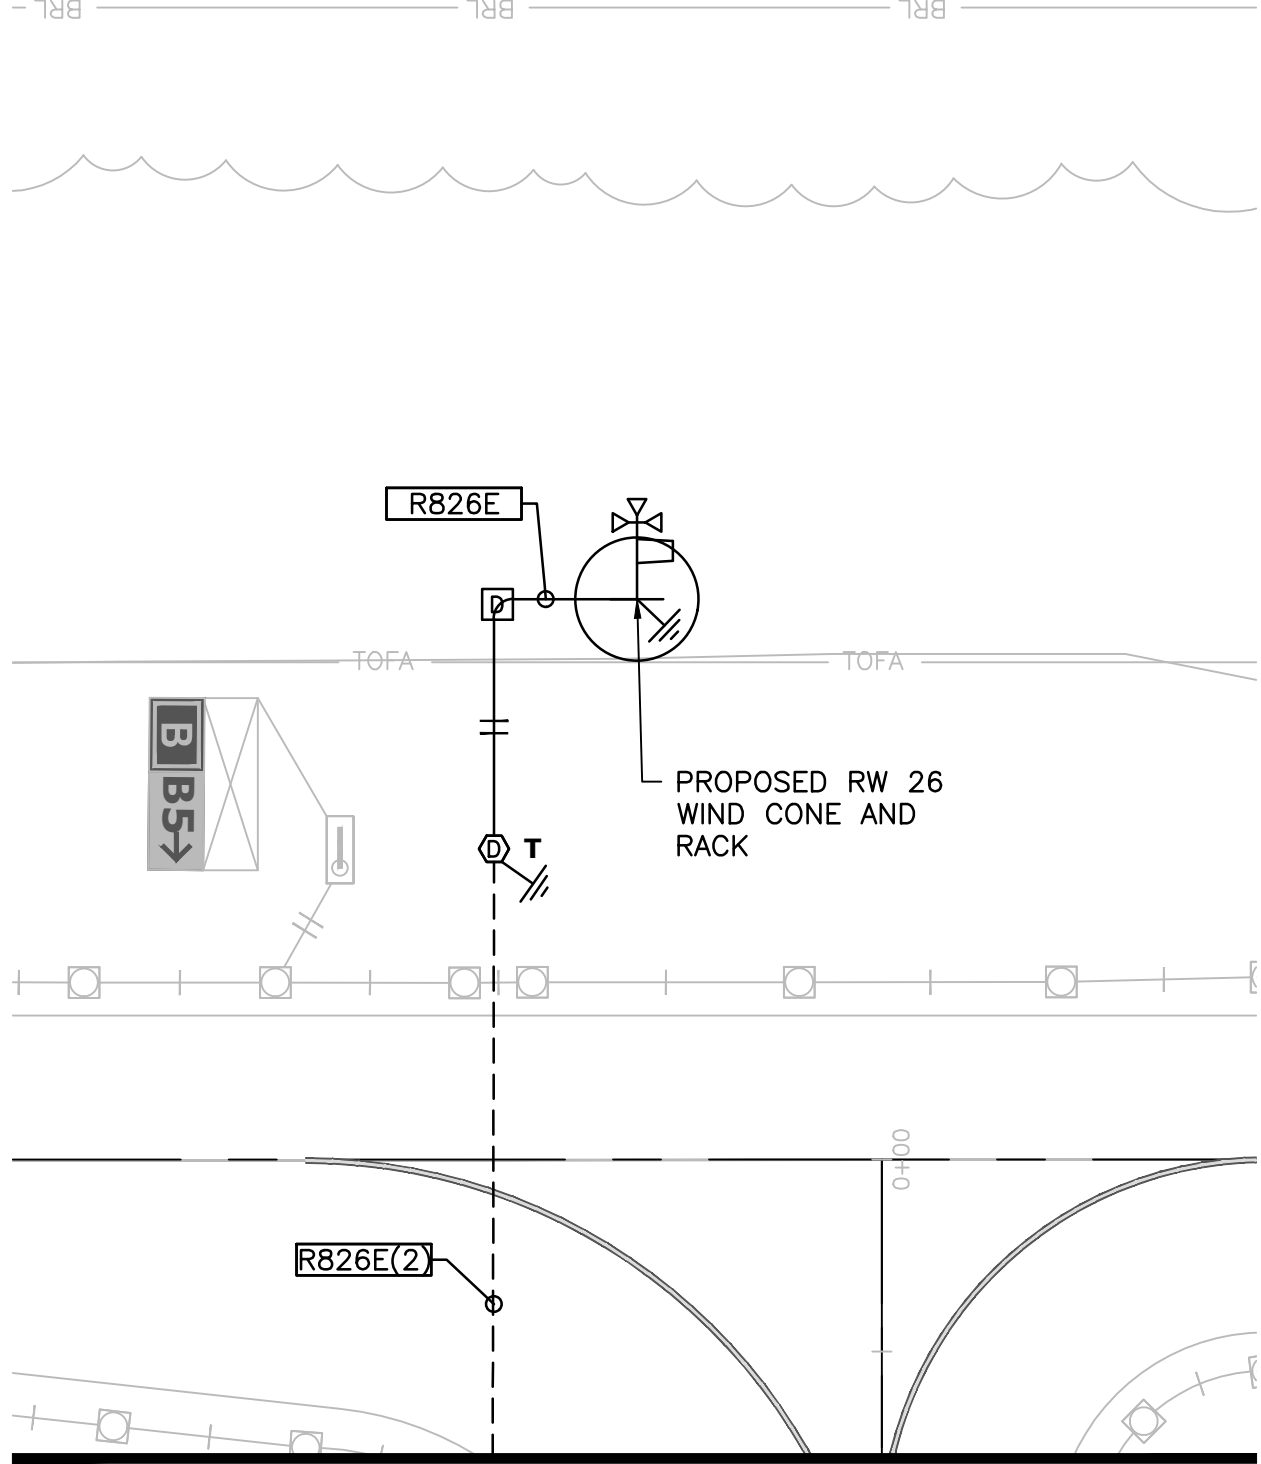

MATCH LINE - SEE THIS SHEET

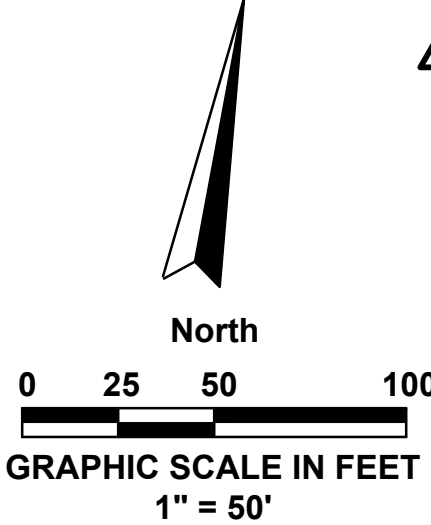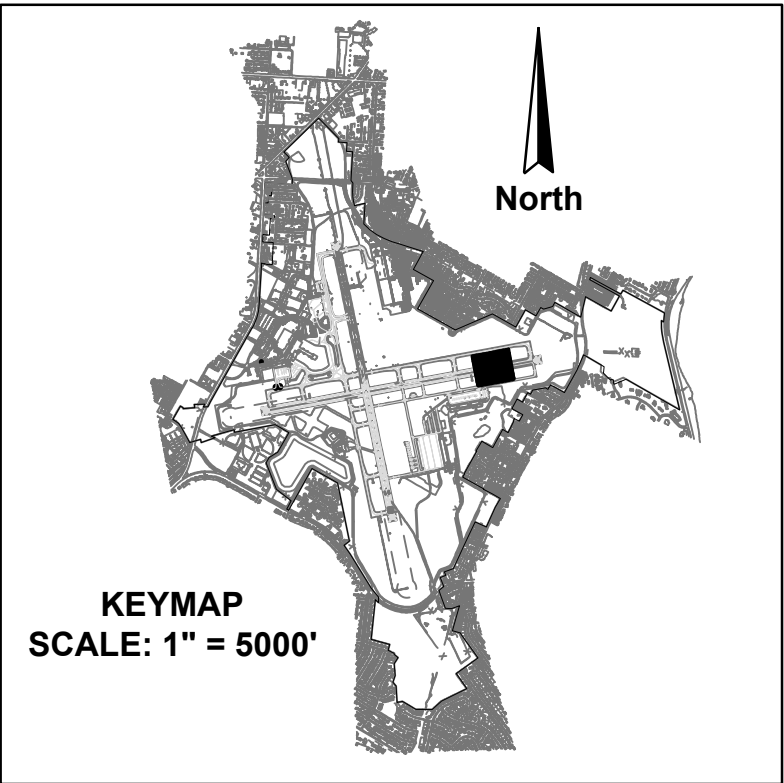

**AIRFIELD
LIGHTING
CIRCUITING PLAN
(SHEET 8 OF 11)**
ISSUED FOR BID DRAWINGS

**RUNWAY 8-26
REHABILITATION**
PREPARED FOR
PENSACOLA INTERNATIONAL AIRPORT

DESIGNED BY: SAH
DRAWN BY: KJF
CHECKED BY: MAG
APPROVED BY: VCL
PROJECT NO: 24.0359.01
DATE: MARCH 28, 2025


**SHEET NUMBER
E308**

AVCON, INC.
ENGINEERS & PLANNERS
3298 SUMMIT BLVD., SUITE 26
PENSACOLA, FL 32503
OFFICE: (850) 688-5526
CORPORATE CERTIFICATE OF
AUTHORIZATION NUMBER: 5057
WWW.AVCONINC.COM



TRANSFORMING TODAY'S IDEAS
INTO TOMORROW'S REALITY

NO.	DATE	REVISION	BY
1	4/25	ADDENDUM 3	SAH
2			
3			
4			
5			
6			
7			
8			
9			
10			

THIS DOCUMENT CONTAINS PRIVILEGED AND PROPRIETARY INFORMATION, ALL OF WHICH IS EXPRESSLY PROVIDED BY AVCON, INC., FOR USE BY THE INTENDED RECIPIENT, AND FOR A SPECIFIC PURPOSE. WITHOUT THE EXPRESS WRITTEN CONSENT OF AVCON, INC., ANY DISTRIBUTION, REPRODUCTION, OR OTHER USE OF THIS DOCUMENT, IN WHOLE OR IN PART, IS STRICTLY PROHIBITED.

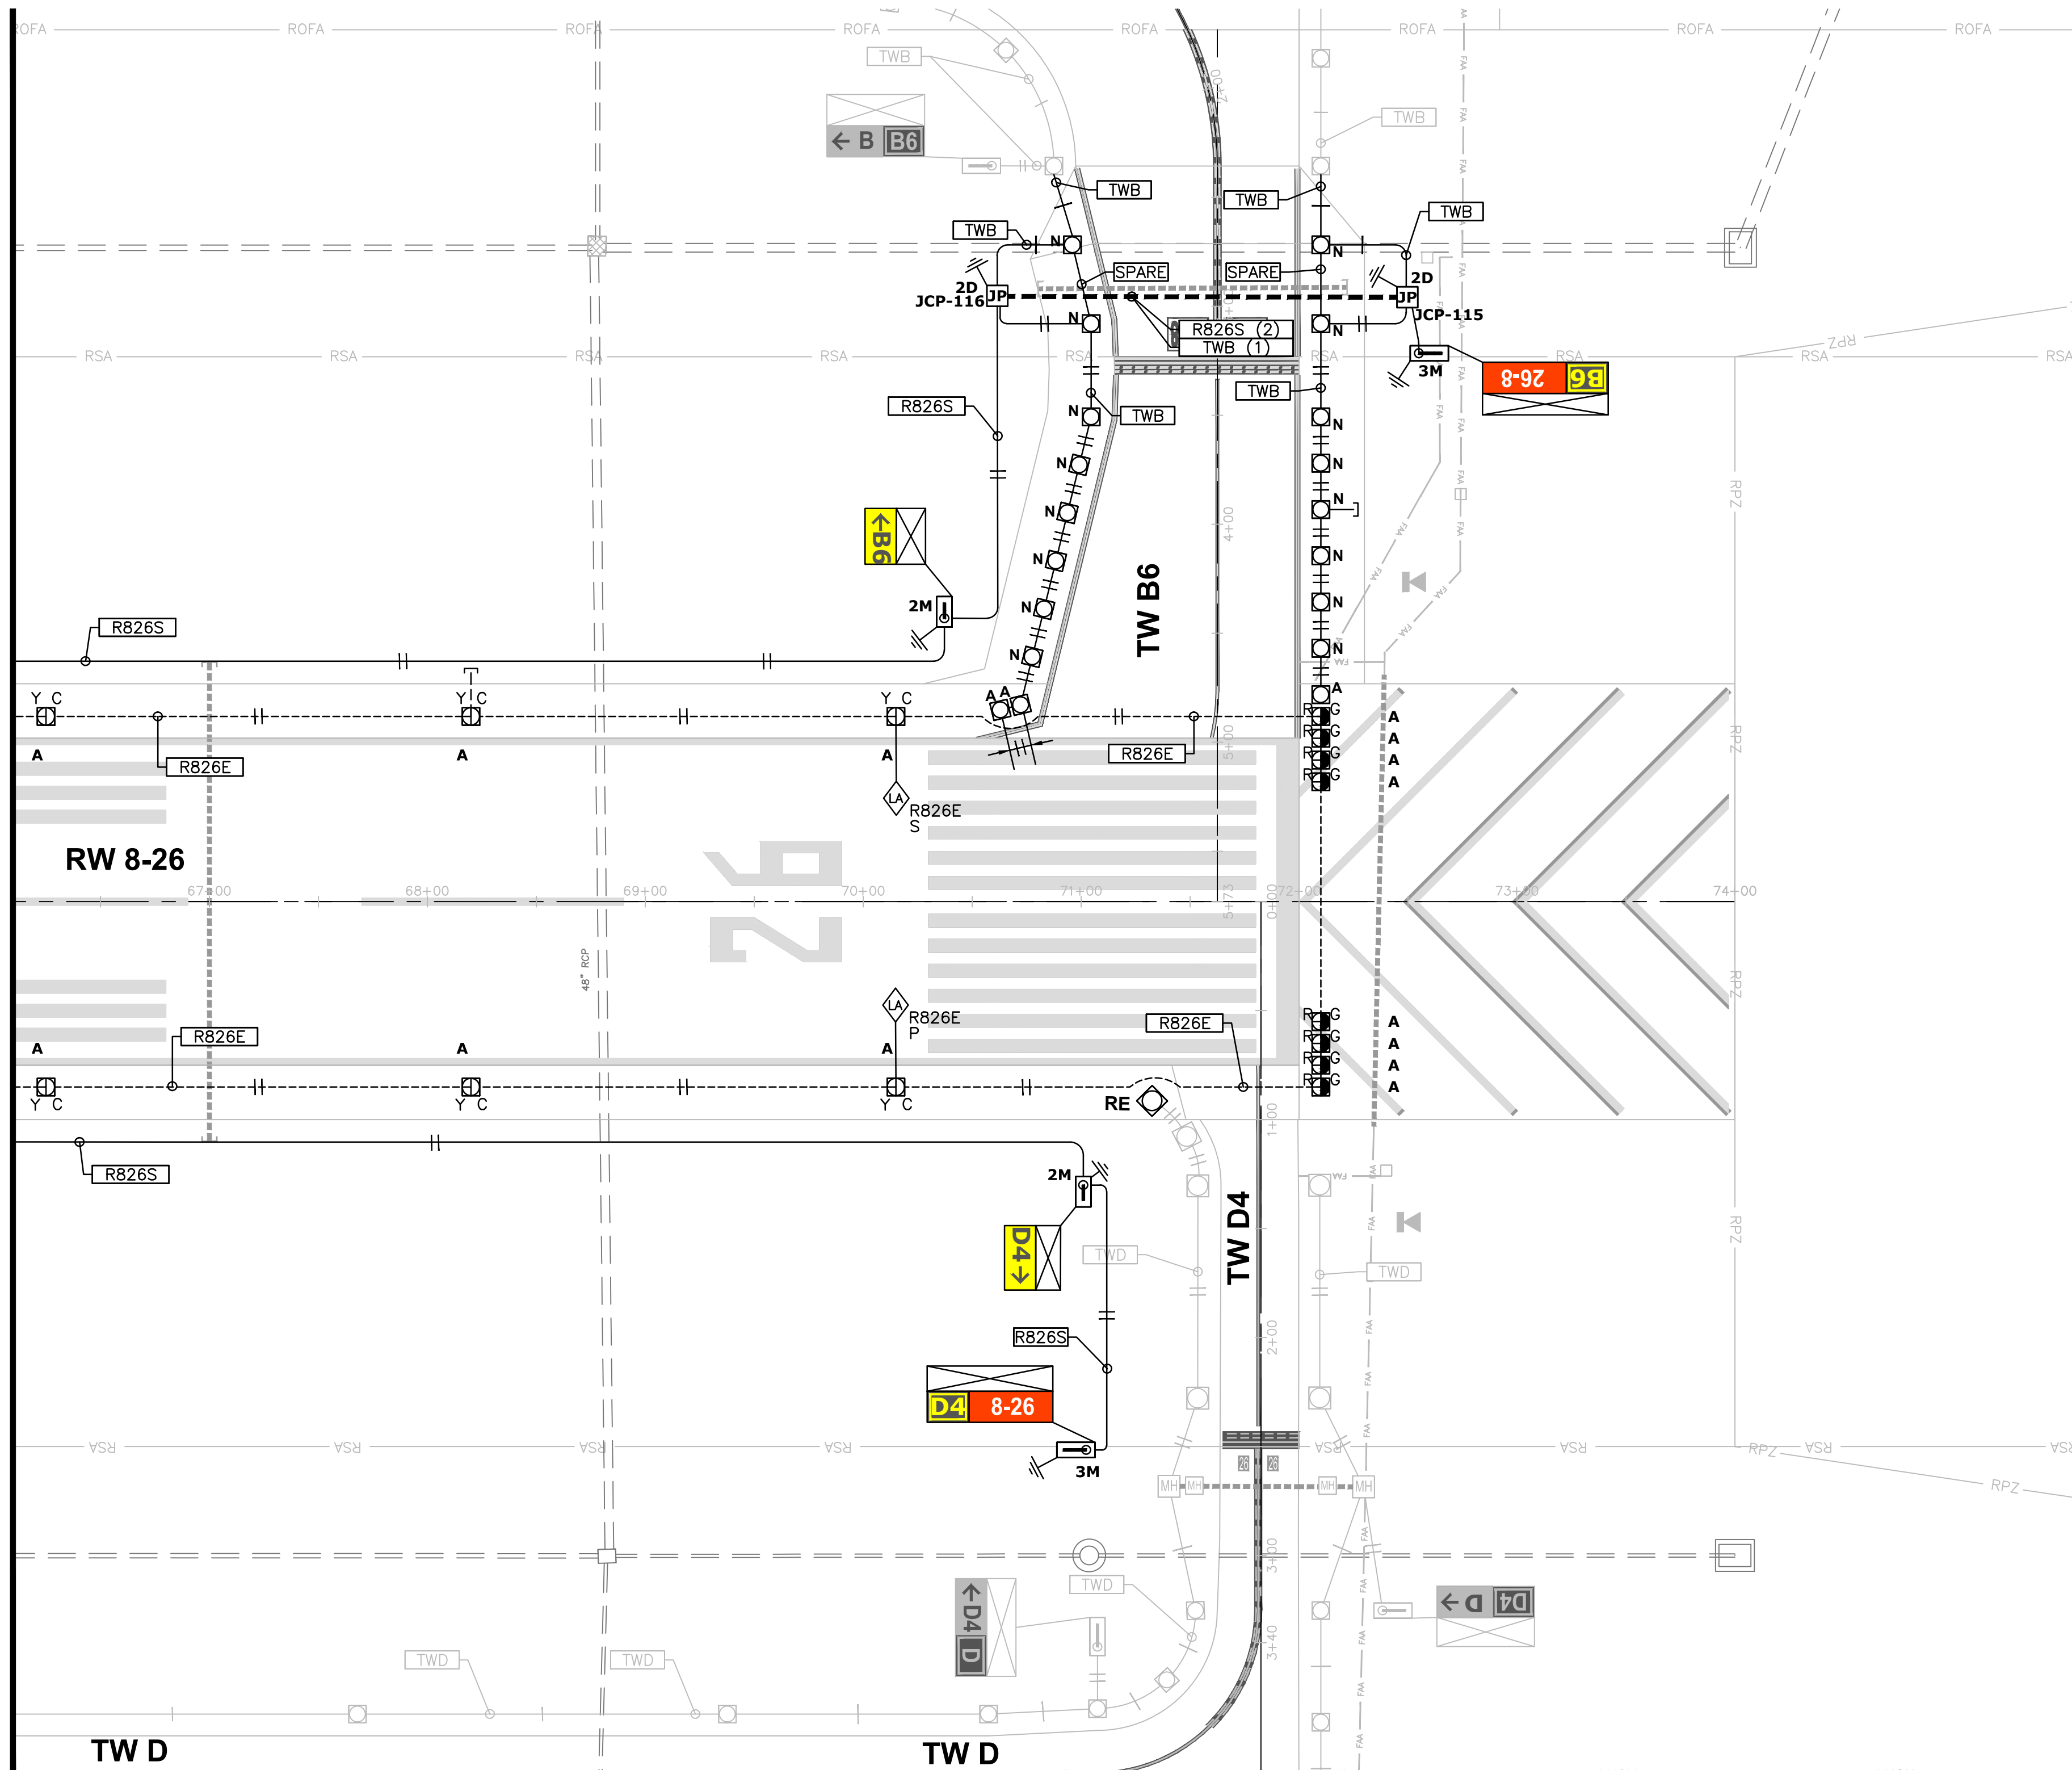

1. SEE SHEET E301 FOR GENERAL CIRCUITING NOTES.

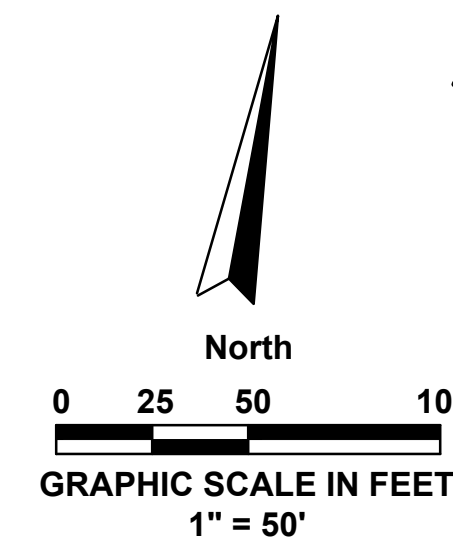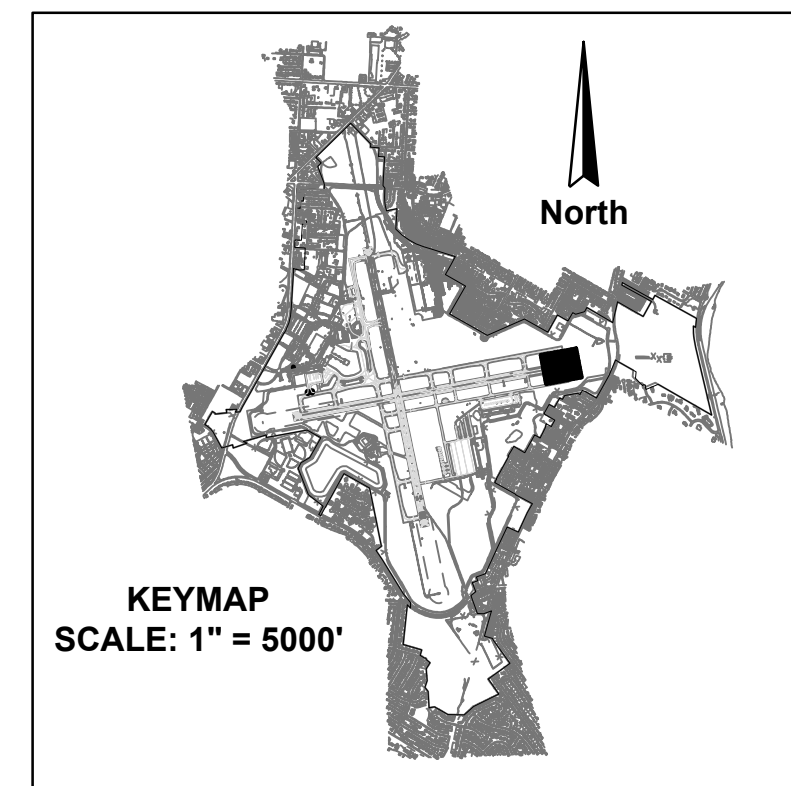

**RUNWAY 8-26
REHABILITATION**

**PREPARED FOR
PENSACOLA INTERNATIONAL AIRPORT**

**AIRFIELD
LIGHTING
CIRCUITING PLAN
(SHEET 9 OF 11)**

[illegible]

AVCON, INC.
ENGINEERS & PLANNERS

3298 SUMMIT BLVD., SUITE 26
PENSACOLA, FL 32503
OFFICE: (850) 698-3826
CORPORATE CERTIFICATE OF
AUTHORIZATION NUMBER: 0507
www.avconinc.com

**TRANSFORMING TODAY'S IDEAS
INTO TOMORROW'S REALITY**




N:\MCDLLE-040\LOGS\LOG008.MPE\Version LOG00 print.jpg

SHEET NUMBER
E309

N:\359 CITY OF PENSACOLA-AIRPORT\2024-0359.01-PNS RUNWAY 8-26\000 CAD\24035901_E301-E311.DWG 4/11/2025 10:24 AM

NOTES:

1. SEE SHEET E301 FOR GENERAL CIRCUITING NOTES.

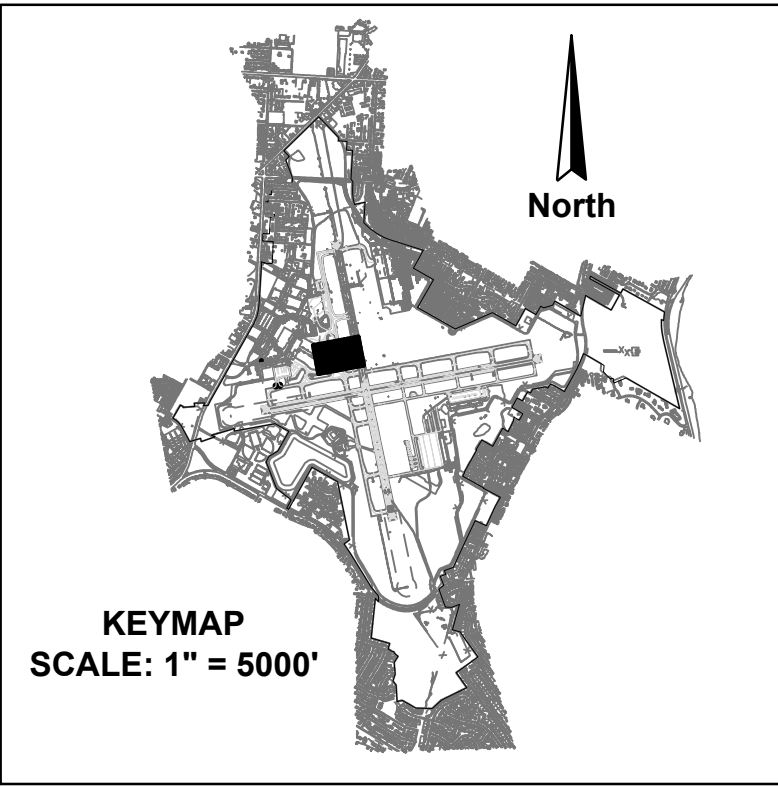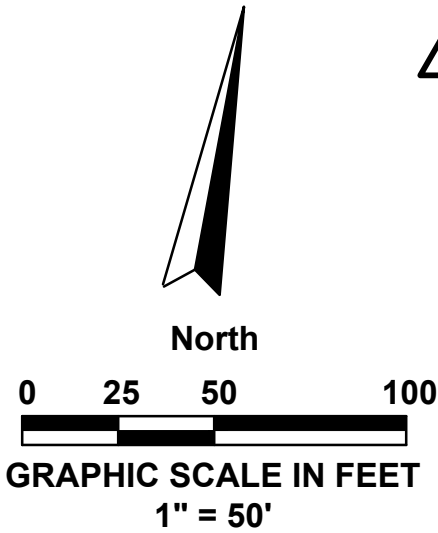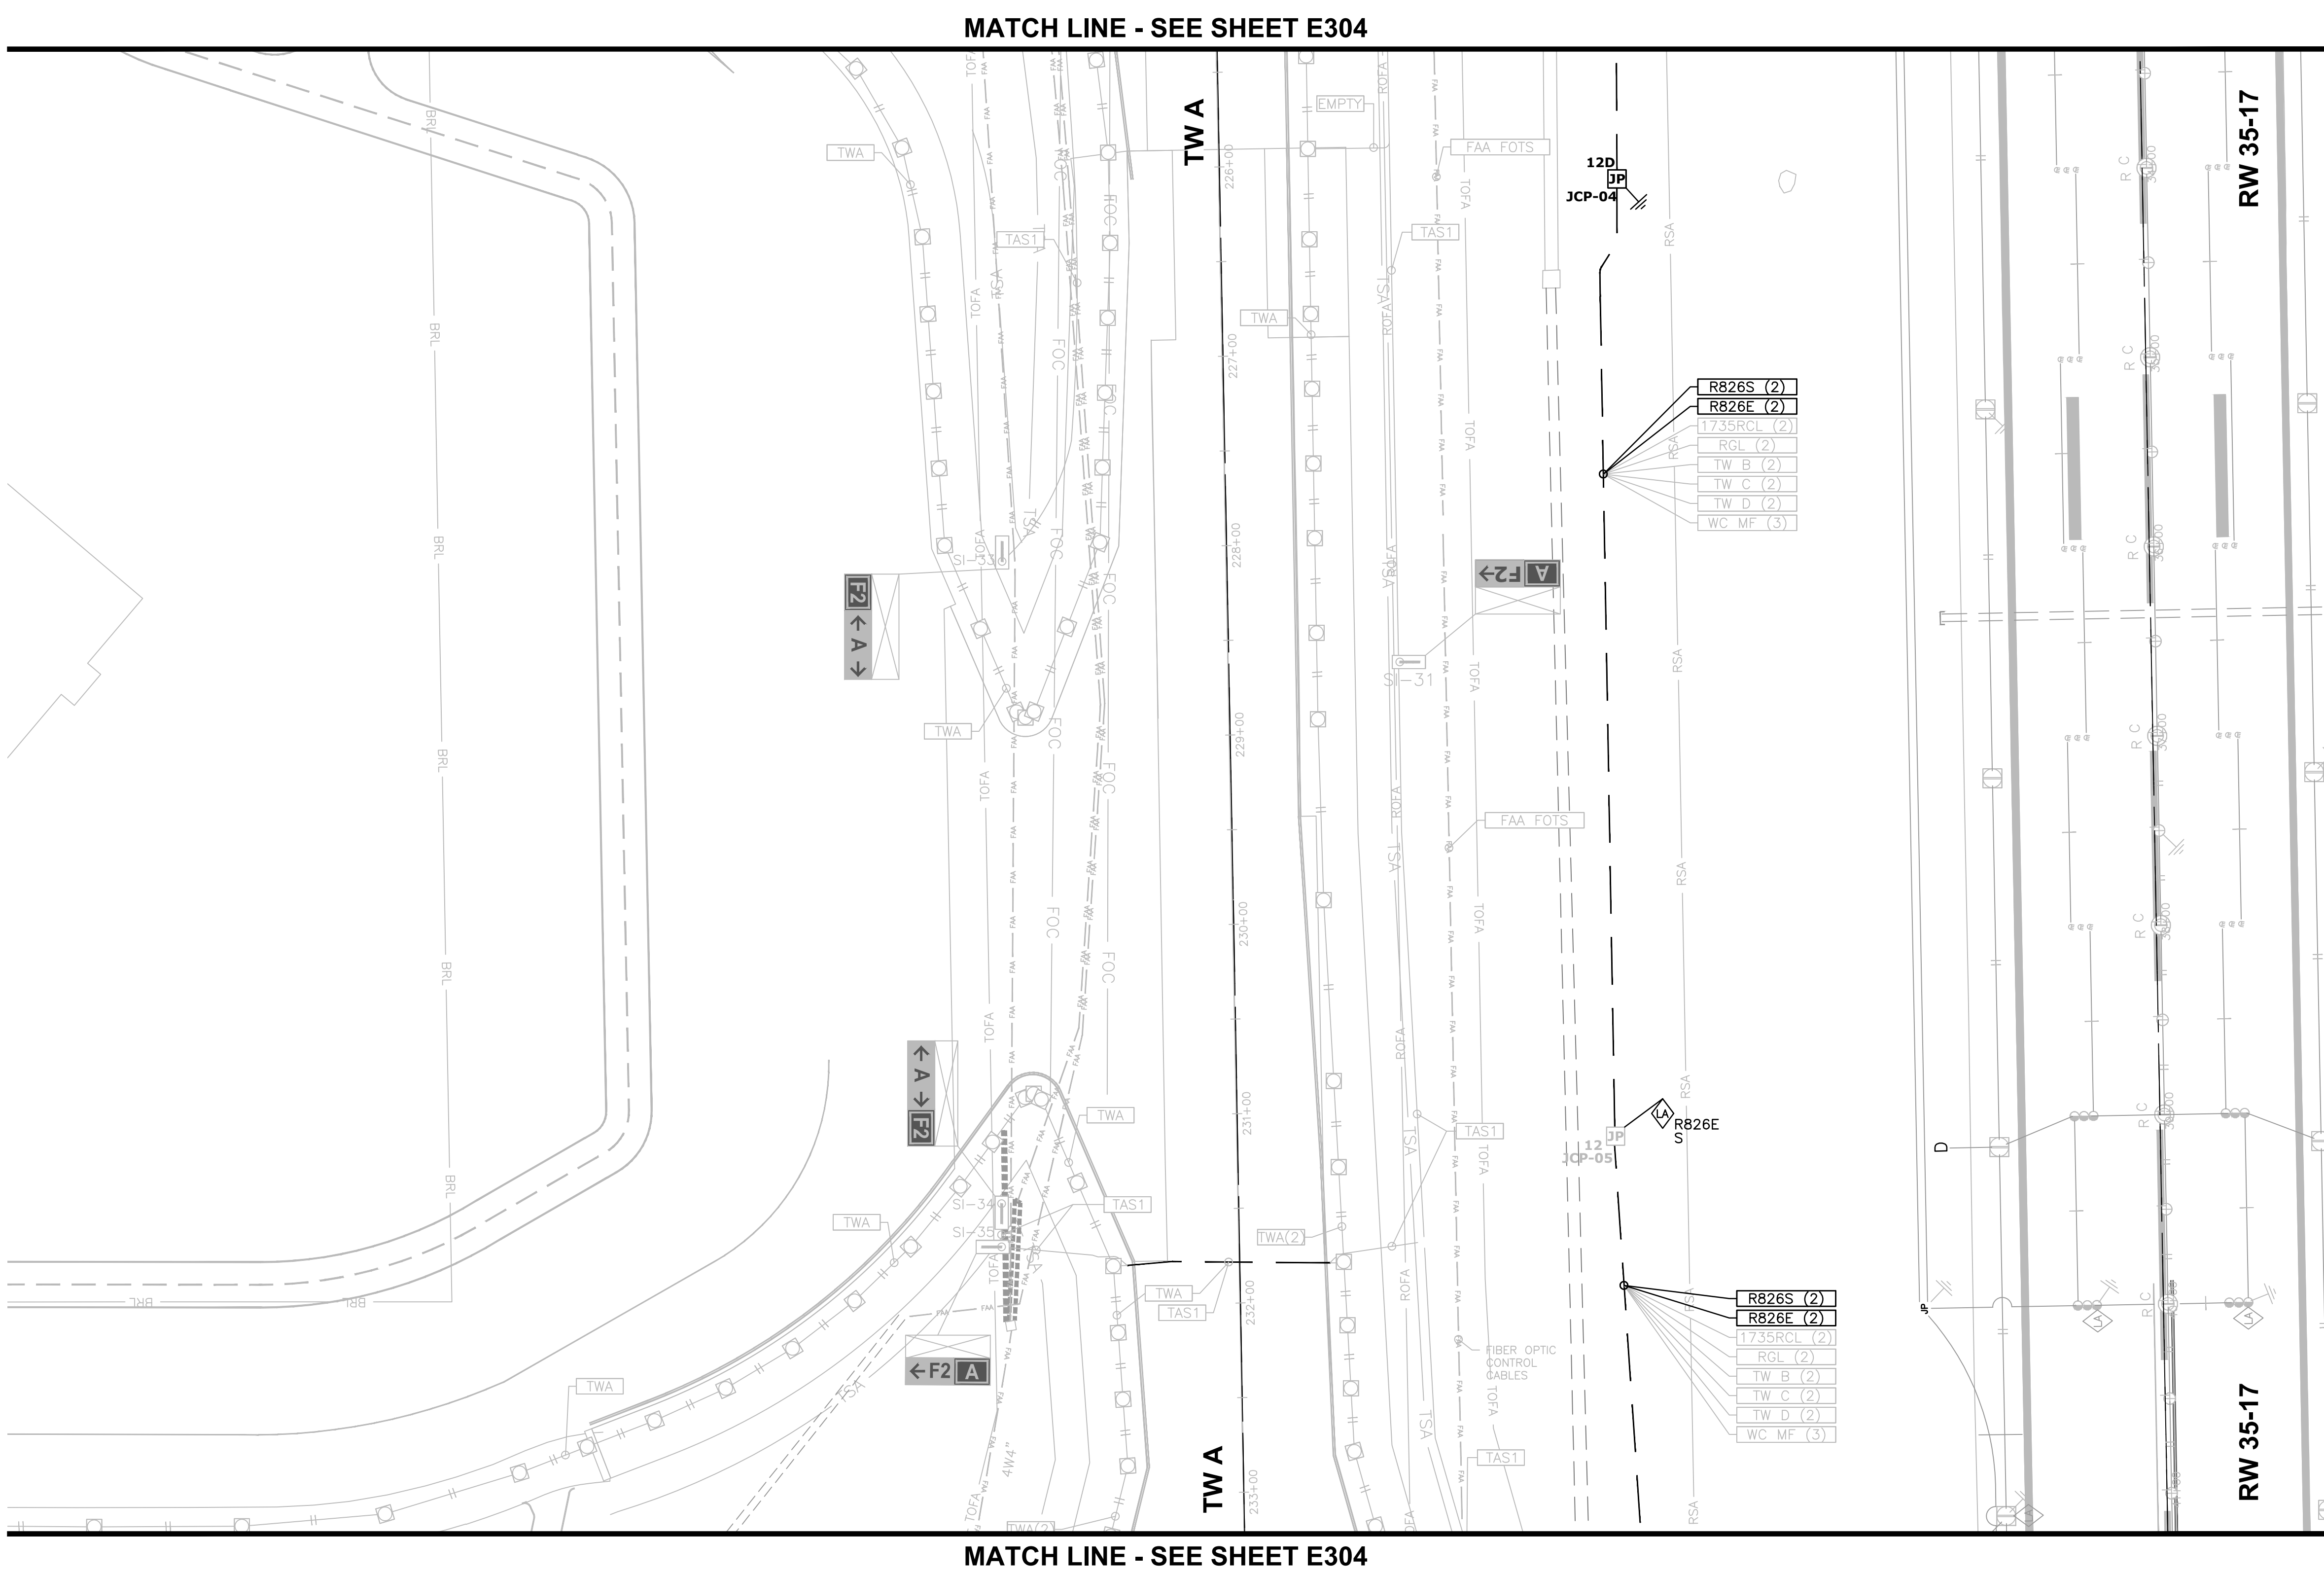

RUNWAY 8-26
REHABILITATION

PREPARED FOR
PENSACOLA INTERNATIONAL AIRPORT

AIRFIELD
LIGHTING
CIRCUITING PLAN
(SHEET 10 OF 11)
ISSUED FOR BID DRAWINGS

NO.	DATE	REVISION	BY
1	4/25	ADDENDUM 3	SAH
2			
3			
4			
5			
6			
7			
8			
9			
10			

AVCON, INC.
ENGINEERS & PLANNERS

3298 SUMMIT BLVD., SUITE 26
PENSACOLA, FL 32503
OFFICE: (850) 688-5526
CORPORATE CERTIFICATE OF
AUTHORIZATION NUMBER: 5057
WWW.AVCONINC.COM


TRANSFORMING TODAY'S IDEAS
INTO TOMORROW'S REALITY

DESIGNED BY: SAH
DRAWN BY: KJF
CHECKED BY: MAG
APPROVED BY: VCL
PROJECT NO: 24.0359.01
DATE: MARCH 28, 2025

SHEET NUMBER
E310

THIS DOCUMENT CONTAINS PRIVILEGED AND PROPRIETARY INFORMATION, ALL OF WHICH IS EXPRESSLY PROVIDED BY AVCON, INC., FOR USE BY THE INTENDED RECIPIENT, AND FOR A SPECIFIC PURPOSE. WITHOUT THE EXPRESS WRITTEN CONSENT OF AVCON, INC., ANY DISTRIBUTION, REPRODUCTION, OR OTHER USE OF THIS DOCUMENT, IN WHOLE OR IN PART, IS STRICTLY PROHIBITED.



N:\359 CITY OF PENSACOLA-AIRPORT\2024.0359.01-PNS RUNWAY 8-26\000 CAD\24035901_E301-E311.DWG 4/11/2025 10:24 AM

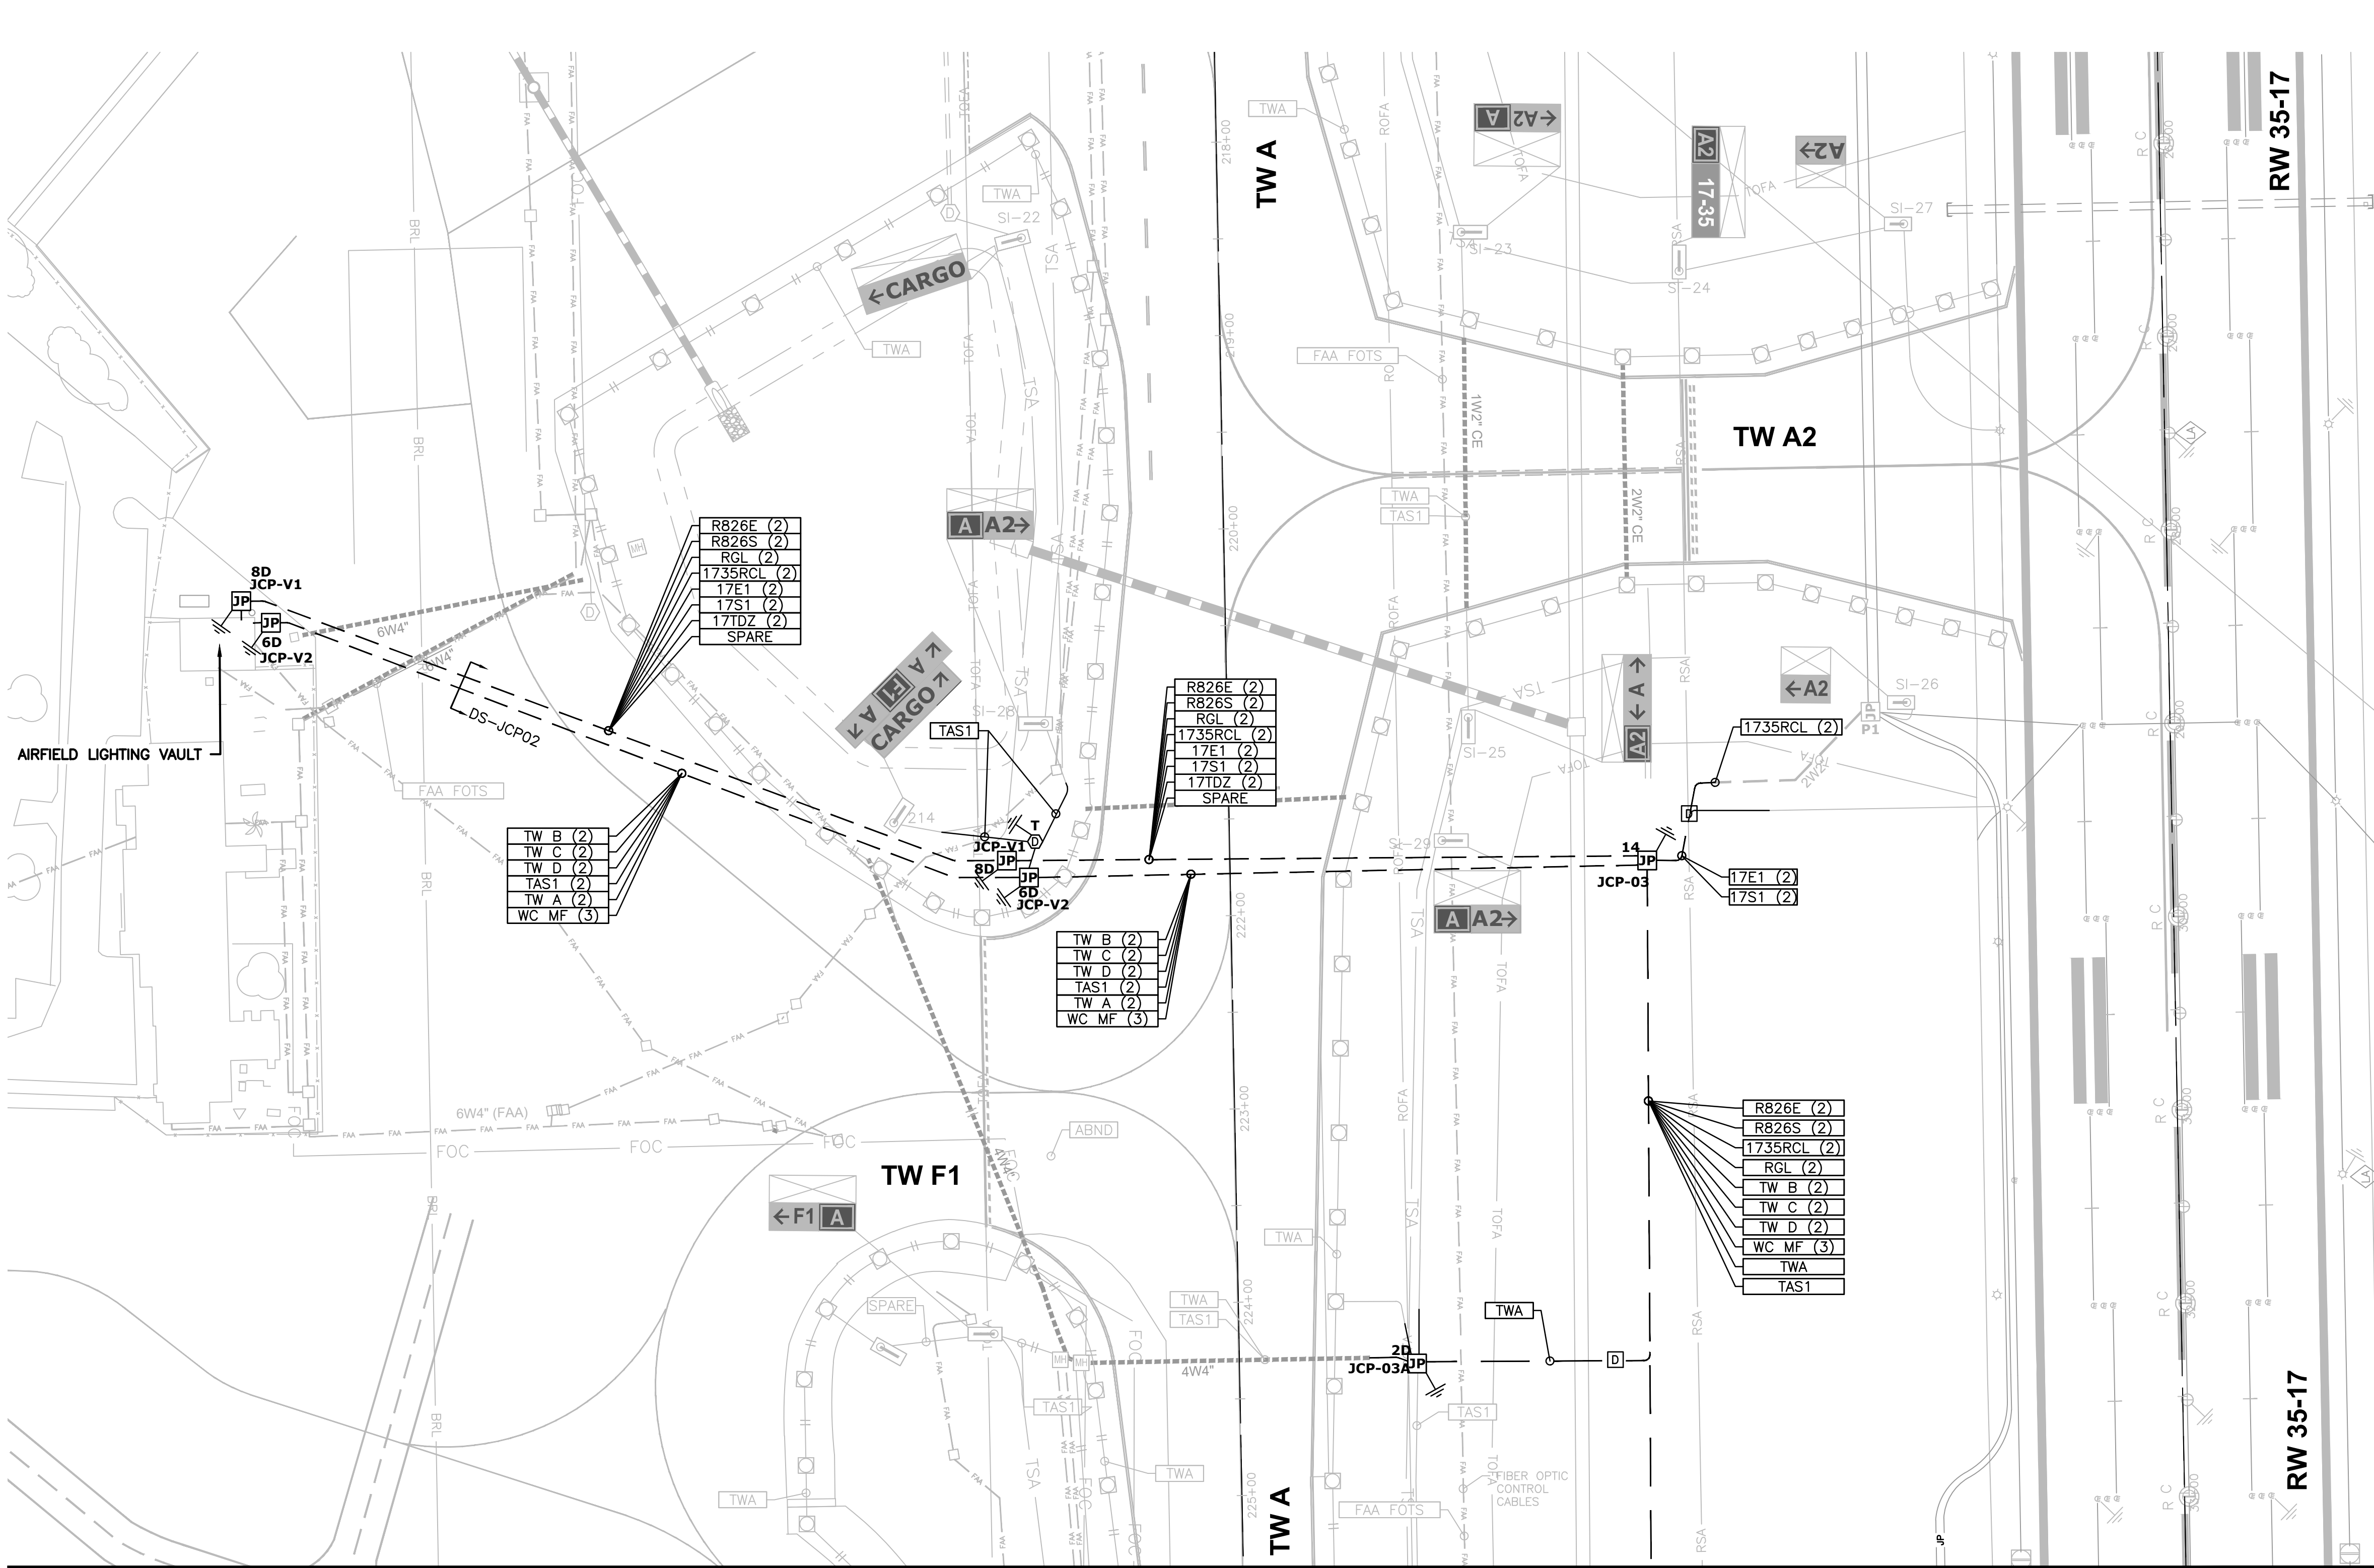

MATCH LINE - SEE SHEET E306

NOTES:

1. SEE SHEET E301 FOR GENERAL CIRCUITING NOTES.

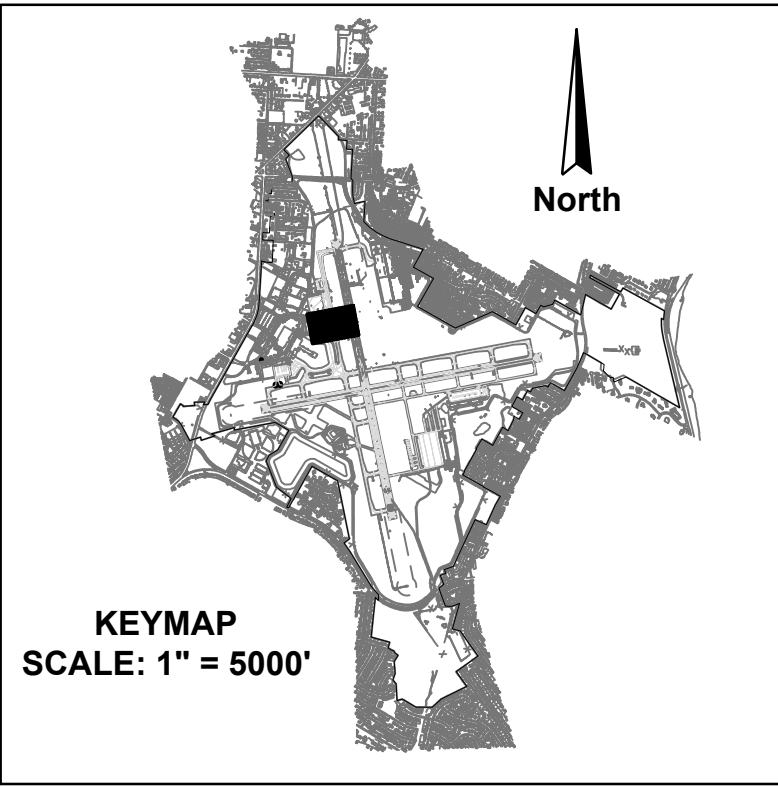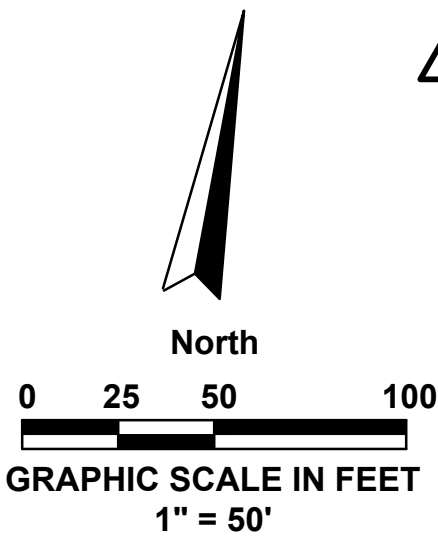

AVCON, INC.
ENGINEERS & PLANNERS
3298 SUMMIT BLVD., SUITE 26
PENSACOLA, FL 32503
OFFICE: (850) 688-5526
CORPORATE CERTIFICATE OF
AUTHORIZATION NUMBER: 5057
WWW.AVCONINC.COM

TRANSFORMING TODAY'S IDEAS
INTO TOMORROW'S REALITY

SAH

4/25

ADDENDUM 3

BY

SAH

4/25

ADDENDUM 3

BY

RUNWAY 8-26
REHABILITATION

PREPARED FOR
PENSACOLA INTERNATIONAL AIRPORT

AIRFIELD
LIGHTING
CIRCUITING PLAN
(SHEET 11 OF 11)
ISSUED FOR BID DRAWINGS

DESIGNED BY: SAH
DRAWN BY: KJF
CHECKED BY: MAG
APPROVED BY: VCL
PROJECT NO: 24.0359.01
DATE: MARCH 28, 2025

SHEET NUMBER
E311

THIS DOCUMENT CONTAINS PRIVILEGED AND PROPRIETARY INFORMATION, ALL OF WHICH IS EXPRESSLY PROVIDED BY AVCON, INC., FOR USE BY THE INTENDED RECIPIENT, AND FOR A SPECIFIC PURPOSE. WITHOUT THE EXPRESS WRITTEN CONSENT OF AVCON, INC., ANY DISTRIBUTION, REPRODUCTION, OR OTHER USE OF THIS DOCUMENT, IN WHOLE OR IN PART, IS STRICTLY PROHIBITED.

RW 17/35



① PROPOSED CONDUIT DUCT BANK LAYOUT

**TRANSFORMING TODAY'S IDEAS
INTO TOMORROW'S REALITY**

SAH	ADDENDUM 3	4/25	A
			△
			△
BY	REVISION	DATE	NO.

**PROPOSED JCP
SCHEMATIC DIAGRAM
(SHEET 1 OF 4)**

ISSUED FOR BID DRAWINGS

RUNWAY 8-26 REHABILITATION

PREPARED FOR
DENSA CO. A INTERNATIONAL AIRPORT

DESIGNED BY: SAH
DRAWN BY: KJR
CHECKED BY: MAG
APPROVED BY: VCL
PROJECT NO: 24.0359.01
DATE: MARCH 28, 2025

SHEET NUMBER
E312

THIS DOCUMENT CONTAINS PRIVILEGED AND PROPRIETARY INFORMATION, ALL OF WHICH IS EXPRESSLY PROVIDED BY AVCON, INC. FOR USE BY THE INTENDED RECIPIENT, AND FOR A SPECIFIC PURPOSE. WITHOUT THE EXPRESS WRITTEN CONSENT OF AVCON, INC. ANY DISTRIBUTION, REPRODUCTION, OR OTHER USE OF THIS DOCUMENT, IN WHOLE OR IN PART, IS STRICTLY PROHIBITED.





③ PROPOSED CONDUIT DUCT BANK LAYOUT

MATCH LINE - E315

**RUNWAY 8-26
REHABILITATION**


**PREPARED FOR
PENSACOLA INTERNATIONAL AIRPORT**

**PROPOSED JCP
SCHEMATIC DIAGRAM
(SHEET 3 OF 4)**

PENSACOLA INTERNATIONAL AIRPORT

DESIGNED BY: SAK
DRAWN BY: KJ
CHECKED BY: MAC
APPROVED BY: VCI
PROJECT NO: 24.0359.0
DATE: MARCH 28, 2024

SHEET NUMBER
E314

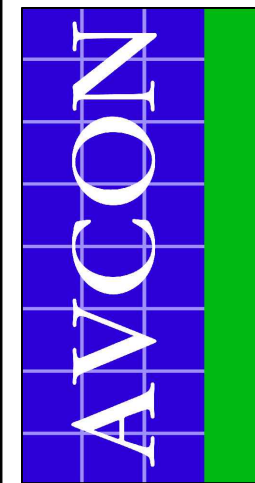

AVCON, INC.
ENGINEERS & PLANNERS
3298 SUMMIT BLVD., SUITE 26
PENSACOLA, FL 32503
OFFICE: (850) 698-3526
CORPORATE CERTIFICATE OF
AUTHORIZATION NUMBER: 5057
www.avconinc.com




ER	2025	9:01	VCL	MAG	KJF	SAH	PENSACOLA INTERNATIONAL AIRPORT
ISSUED FOR BID DRAWINGS							
			NO.	DATE	REVISION		
INTO TOMORROW'S REALITY							
TRANSFORMING TODAY'S IDEAS							
www.avconllc.com							



N:\359 CITY OF PENSACOLA-AIRPORT\2024.0359.01-PNS RUNWAY 8-26\000 CAD\24035901_E401-411.DWG 4/11/2025 9:14 AM

GENERAL NUMBERING NOTES:

- SEE SHEET E001 FOR GENERAL NOTES AND E002 FOR SYMBOL LEGEND.
- ALL ELEVATED LIGHT FIXTURES SHALL BE INSTALLED WITH A BRASS IDENTIFICATION MARKER INSTALLED PER CONTRACT DETAILS. SEE SHEET E527 FOR ID TAG DETAILS.
- EACH LIGHT BASE CONTAINING A FIELD LIGHTNING ARRESTOR SHALL BE EQUIPPED WITH AN ADDITIONAL BRASS ID TAG ENGRAVED WITH "LA". SEE SHEET E530 FOR LIGHTNING ARRESTOR TAG DETAILS.
- SEE SHEETS E506 - E510 FOR IDENTIFICATION TAG WORK FOR IN-PAVEMENT LIGHT FIXTURES AND LIGHT FIXTURES INSTALLED IN SHOULDER PAVEMENT.
- ALL WIND CONES SHALL BE EQUIPPED WITH A BRASS MARKER INSTALLED PER CONTRACT DETAILS. SEE SHEET E518 FOR DETAILS.
- ALL SIGNS FIXTURES SHALL BE EQUIPPED WITH A BRASS MARKER INSTALLED PER CONTRACT DETAILS AND AN ADHESIVE ID LABEL. SEE SHEETS E514 - E517 FOR DETAILS.
- EACH JUNCTION CAN WITHIN A JUNCTION CAN PLAZA SHALL BE EQUIPPED WITH A BRASS ID MARKER DENOTING THE CIRCUIT(S) CONTAINED INSIDE. THE JUNCTION CAN PLAZA CONCRETE FOUNDATION SHALL BE IMPRESSED WITH ITS UNIQUE IDENTIFICATION LABEL AS SHOWN IN THESE PLANS. SEE SHEETS E521, E522, AND E529 FOR DETAILS.
- PRESERVE AND PROTECT EXISTING FIXTURE IDENTIFICATION FOR FIXTURE TO BE REUSED IN THIS PROJECT. ANY DAMAGE TO THE EXISTING IDENTIFICATION SHALL RESULT IN THE CONTRACTOR REPAIRING/REPLACING THE DAMAGED ITEMS TO THE SATISFACTION OF THE OWNER AT THE CONTRACTORS EXPENSE. (TYP.)
- COORDINATE WITH THE OWNER FOR ALL FIXTURES NOT NUMBERED IN THESE PLANS.
- ALL FIXTURES AND CANS SHALL BE IDENTIFIED TO THE SATISFACTION ON THE OWNER.
- ALL IDENTIFICATION WORK SHALL BE INCIDENTAL TO THE RESPECTIVE FIXTURE PAY ITEM.

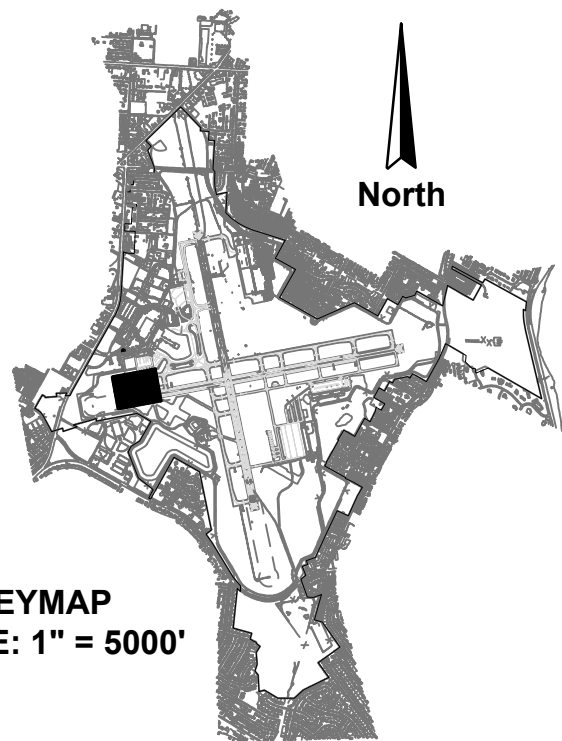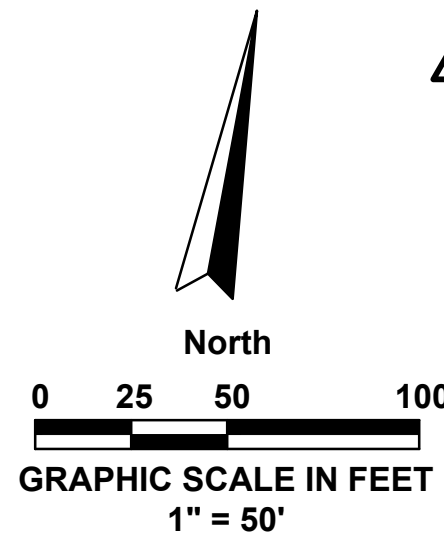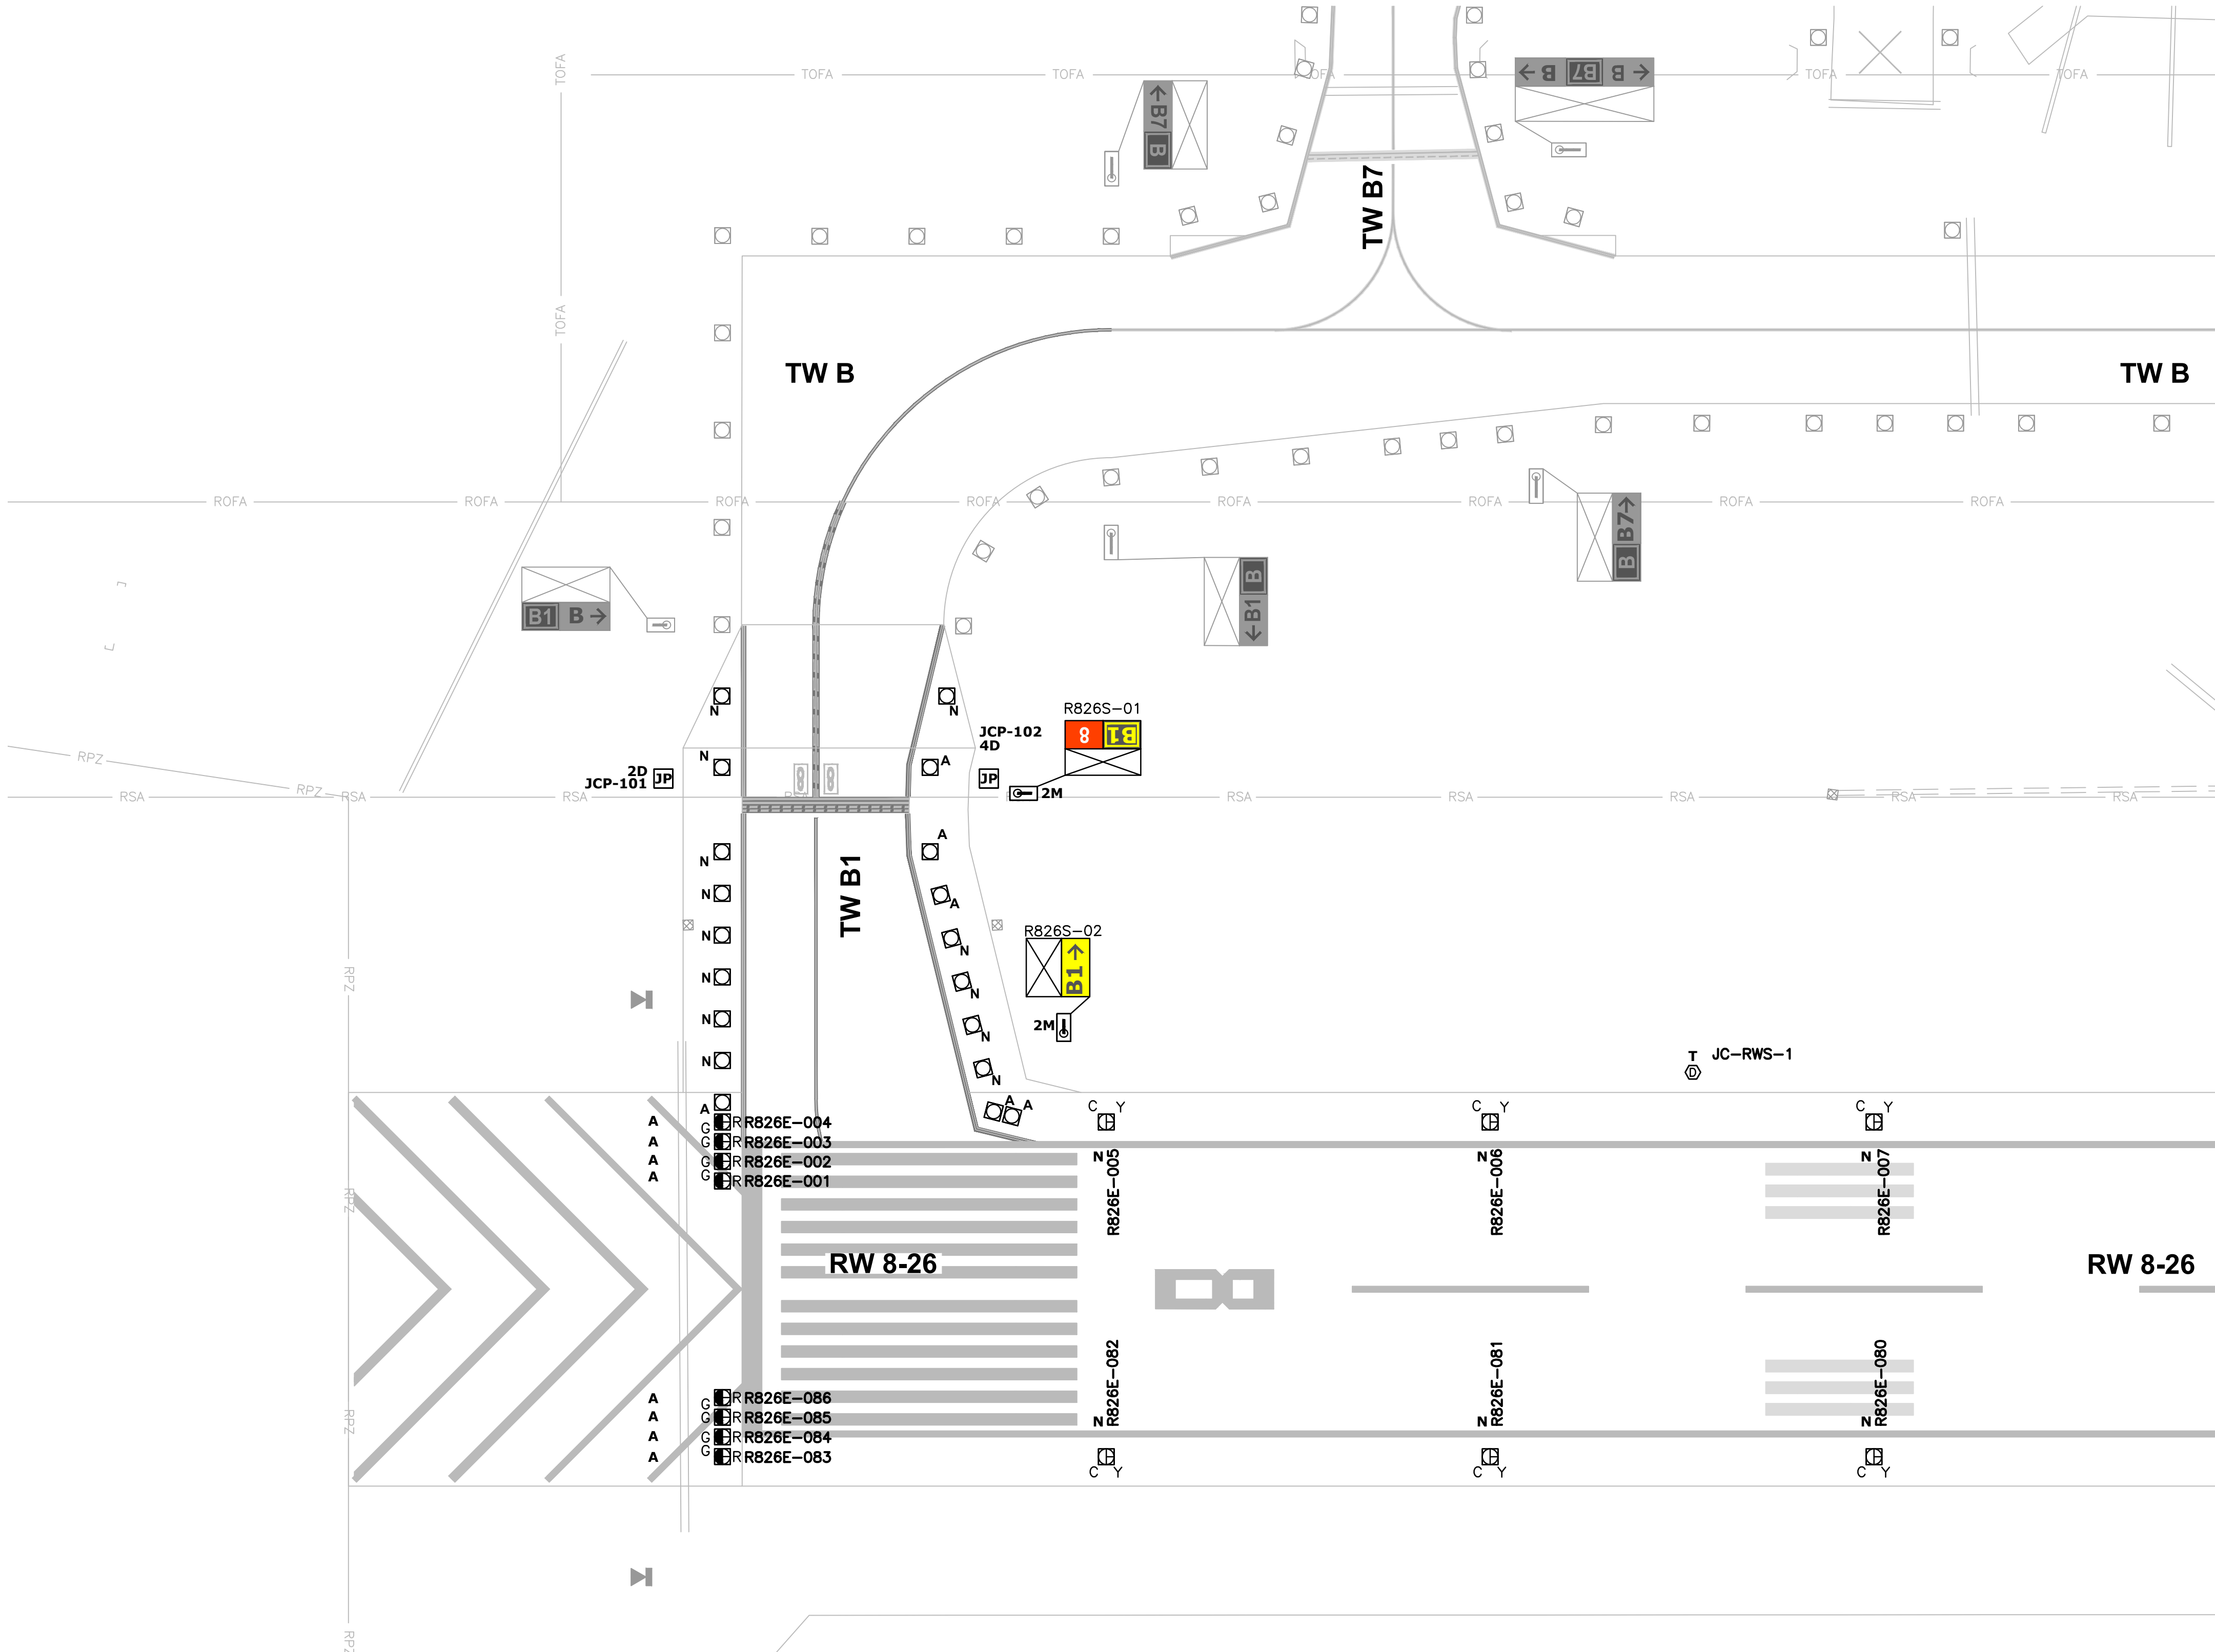

RUNWAY 8-26 REHABILITATION

PREPARED FOR
PENSACOLA INTERNATIONAL AIRPORT

DESIGNED BY: SAH
DRAWN BY: KJF
CHECKED BY: MAG
APPROVED BY: VCL
PROJECT NO: 24.0359.01
DATE: MARCH 28, 2025

SHEET NUMBER
E401


AIRFIELD LIGHTING NUMBERING PLAN (SHEET 1 OF 11)

ISSUED FOR BID DRAWINGS

NO.	DATE	REVISION	BY
1	4/25	ADDENDUM 3	SAH
2			
3			
4			
5			
6			
7			
8			
9			
10			
11			

TRANSFORMING TODAY'S IDEAS
INTO TOMORROW'S REALITY

AVCON, INC.
ENGINEERS & PLANNERS
3298 SUMMIT BLVD., SUITE 26
PENSACOLA, FL 32503
OFFICE: (850) 688-5526
CORPORATE CERTIFICATE OF
AUTHORIZATION NUMBER: 5057
WWW.AVCONINC.COM


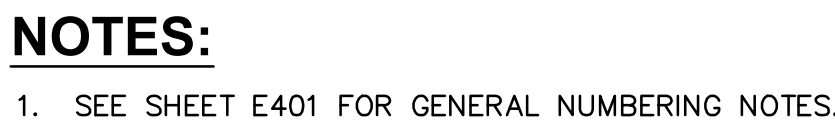


MATCH LINE - THIS SHEET

MATCH LINE - SEE SHEET E210

MATCH LINE - SEE SHEET E203

MATCH LINE - SEE SHEET E204

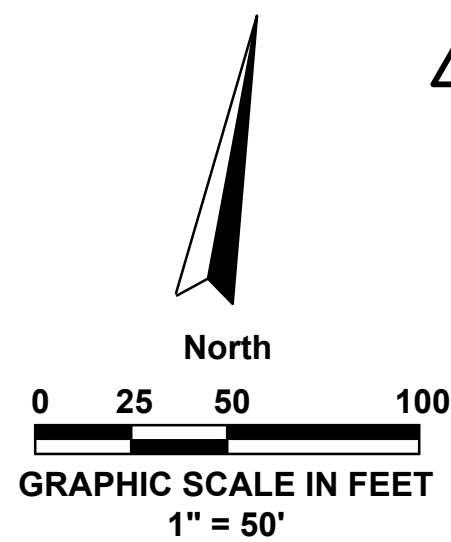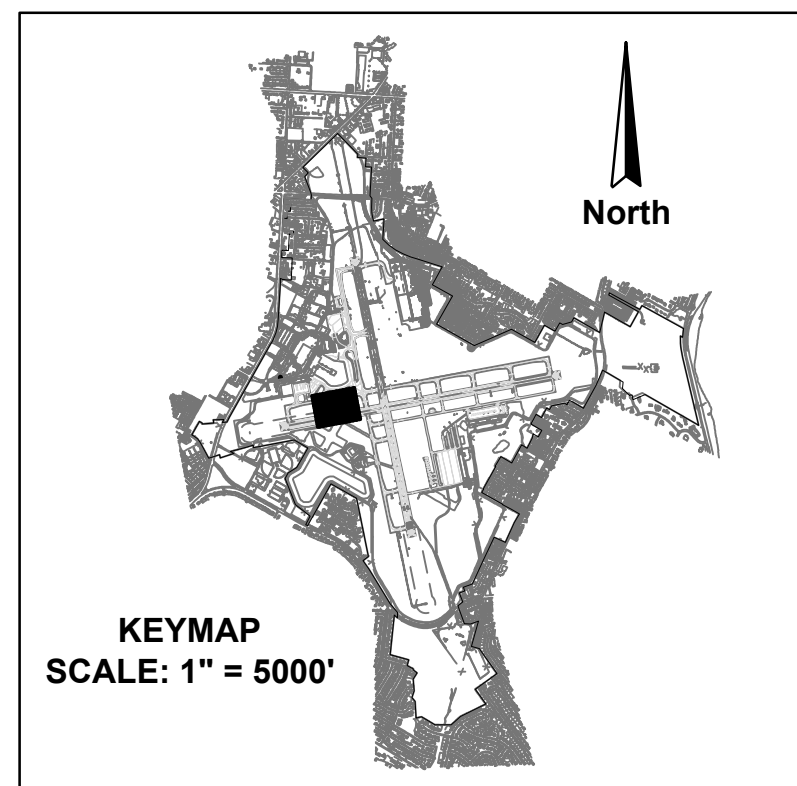

**RUNWAY 8-26
REHABILITATION**

**PREPARED FOR
PENSACOLA INTERNATIONAL AIRPORT**

**AIRFIELD LIGHTING
NUMBERING PLAN
(SHEET 2 OF 11)**

AVCON, INC.
ENGINEERS & PLANNERS

3298 SUMMIT BLVD., SUITE 26
PENSACOLA, FL 32503
OFFICE: (850) 698-3526
CORPORATE CERTIFICATE OF
AUTHORIZATION NUMBER: 5057
www.avconinc.com

N:\NICEVILLE-CAD\002_00005\JPEG\Aveson LOGO .jpeg

A	4/25	ADDENDUM 3	SAH
△			
△			
NO.	DATE	REVISION	BY

DESIGNED BY: SAH
DRAWN BY: KJR
CHECKED BY: MAG
APPROVED BY: VCL
PROJECT NO: 24.0359.01
DATE: MARCH 28, 2025

SHEET NUMBER
E402


THIS DOCUMENT CONTAINS PROPRIETARY INFORMATION, ALL OF WHICH IS EXPRESSLY PROVIDED BY AVCON, INC. FOR USE BY THE INTENDED RECIPIENT, AND FOR A SPECIFIC PURPOSE. WITHOUT THE EXPRESS WRITTEN CONSENT OF AVCON, INC. ANY DISTRIBUTION, REPRODUCTION, OR OTHER USE OF THIS DOCUMENT, IN WHOLE OR IN PART, IS STRICTLY PROHIBITED.

N:\359 CITY OF PENSACOLA-AIRPORT\2024.0359.01-PNS RUNWAY 8-26\000 CAD\24035901_E401-411.DWG 4/11/2025 9:14 AM

NOTES:



1. SEE SHEET E401 FOR GENERAL NUMBERING NOTES.

MATCH LINE - SEE SHEET E402

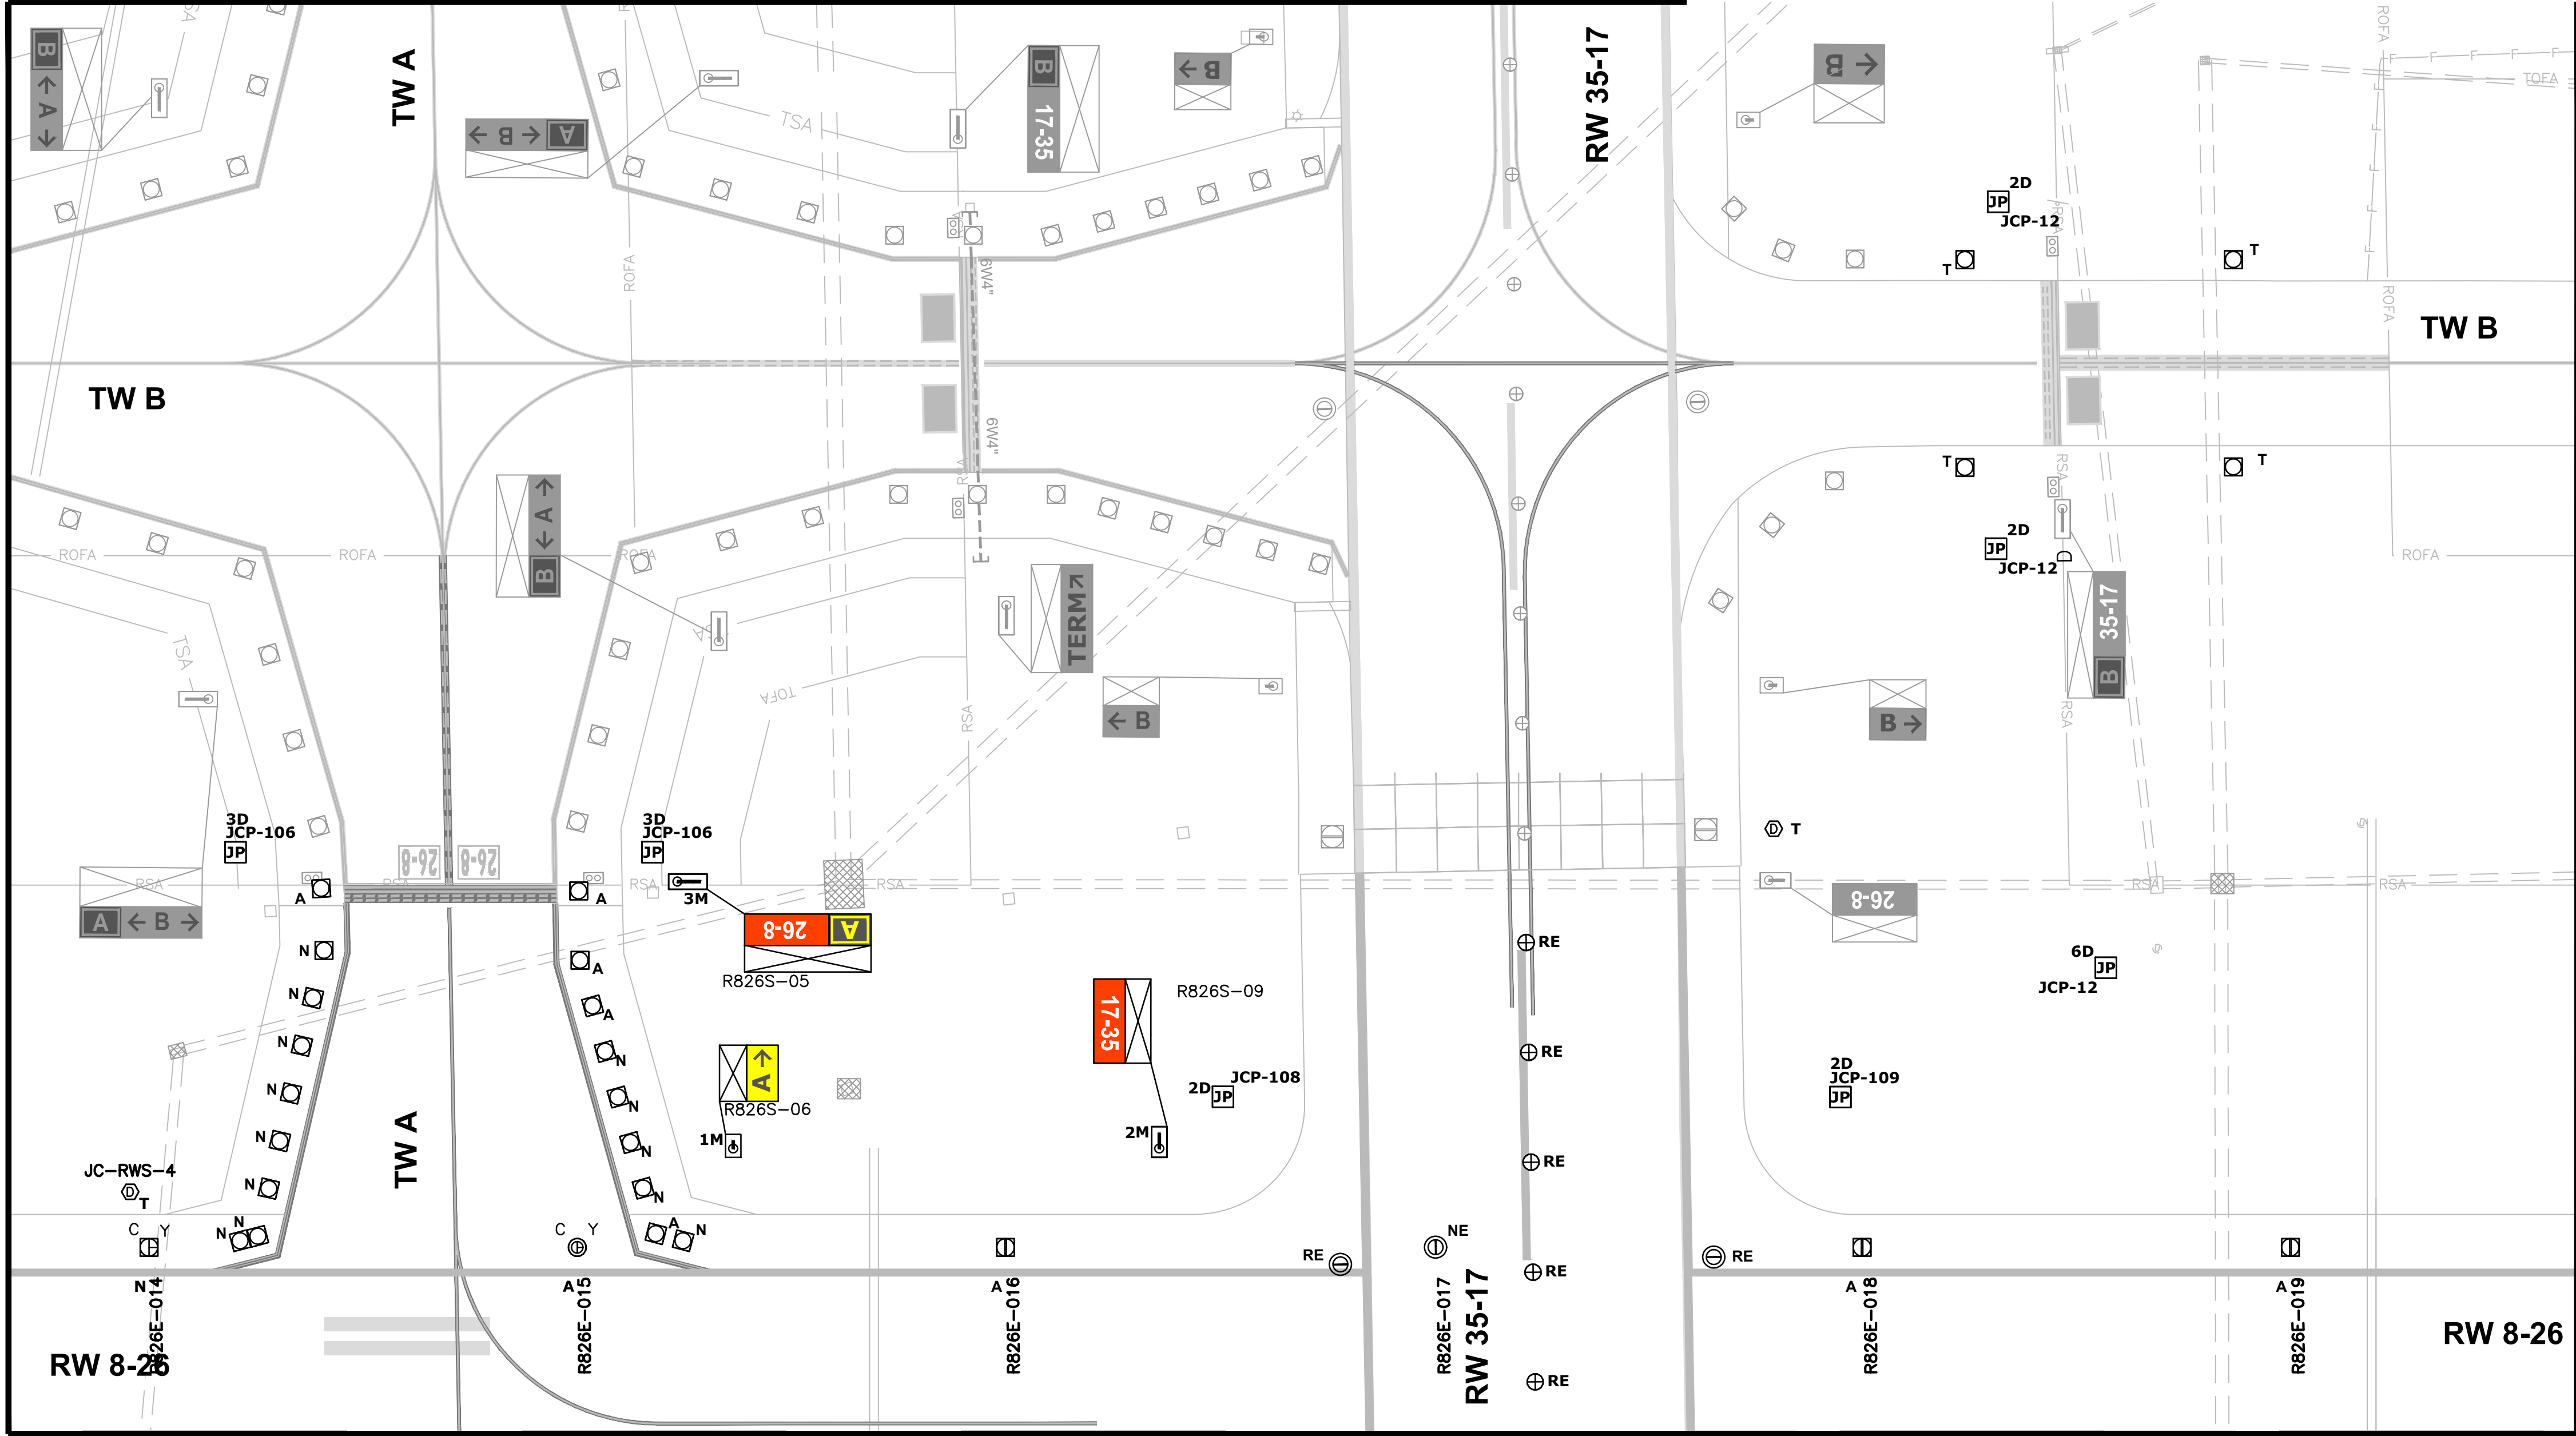

MATCH LINE - SEE SHEET E404

MATCH LINE - SEE SHEET E405

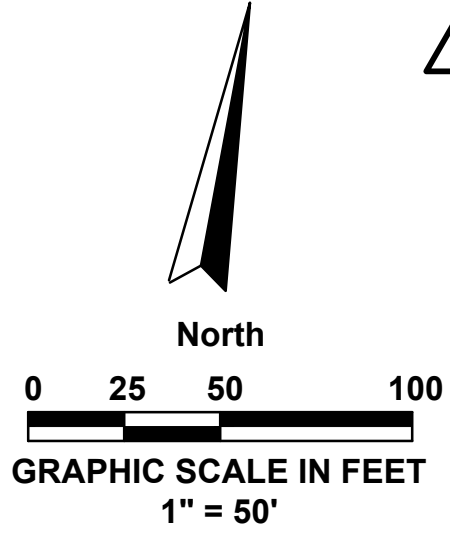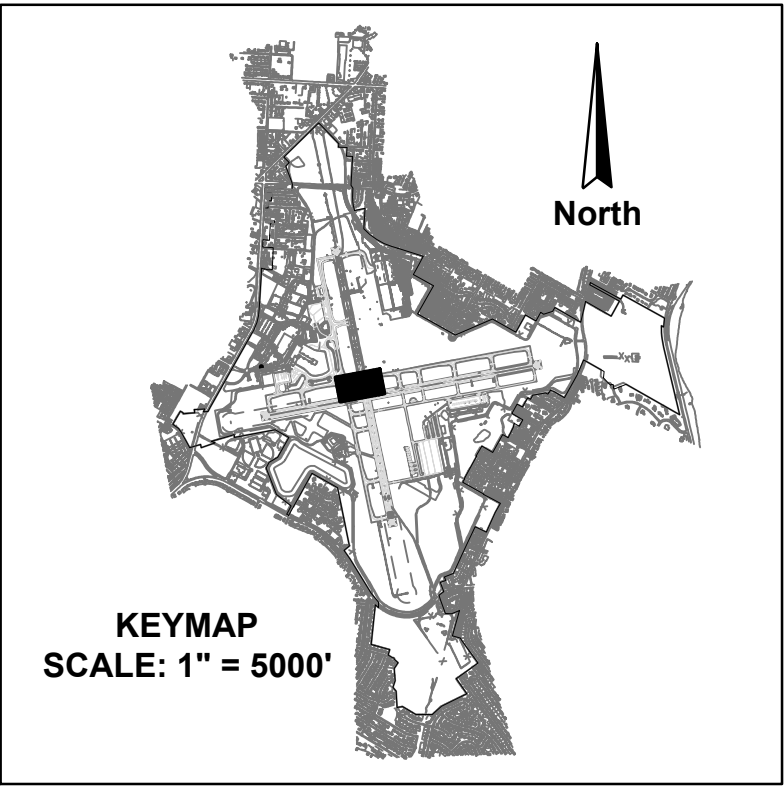

RUNWAY 8-26
REHABILITATION
PREPARED FOR
PENSACOLA INTERNATIONAL AIRPORT

DESIGNED BY: SAH
DRAWN BY: KJF
CHECKED BY: MAG
APPROVED BY: VCL
PROJECT NO: 24.0359.01
DATE: MARCH 28, 2025

SHEET NUMBER
E403



AIRFIELD LIGHTING
NUMBERING PLAN
(SHEET 3 OF 11)
ISSUED FOR BID DRAWINGS

NO.	DATE	REVISION	BY
1	4/25	ADDENDUM 3	SAH
2			
3			
4			
5			
6			
7			
8			
9			
10			

AVCON, INC.
ENGINEERS & PLANNERS
3298 SUMMIT BLVD., SUITE 26
PENSACOLA, FL 32503
OFFICE: (850) 688-5526
CORPORATE CERTIFICATE OF
AUTHORIZATION NUMBER: 5057
WWW.AVCONINC.COM

TRANSFORMING TODAY'S IDEAS
INTO TOMORROW'S REALITY

1. SEE SHEET E401 FOR GENERAL NUMBERING NOTES.

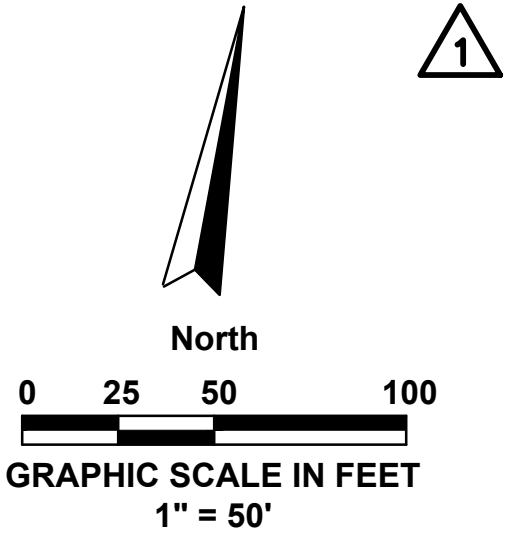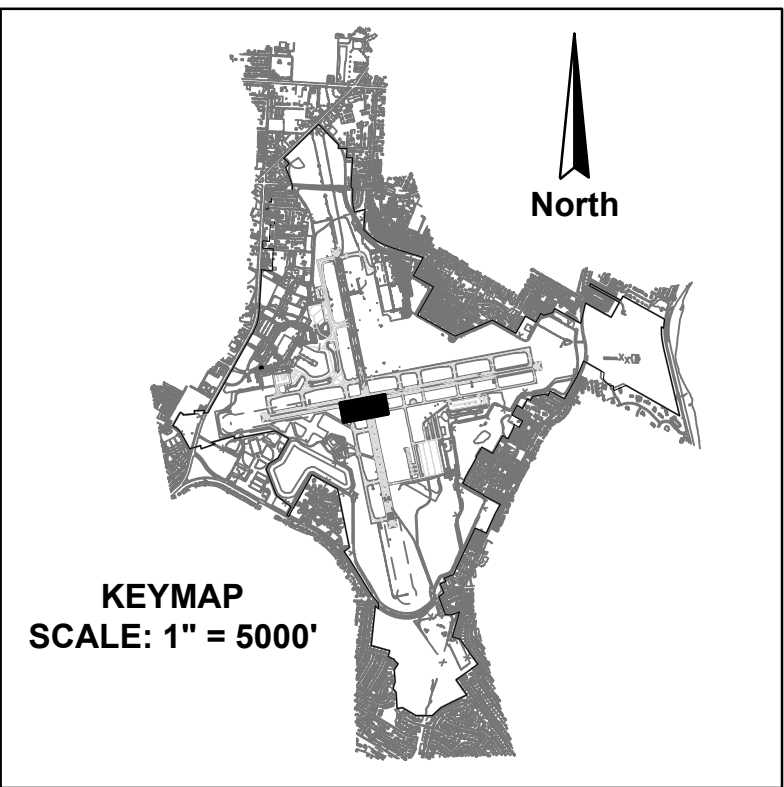

**AIRFIELD LIGHTING
NUMBERING PLAN
(SHEET 4 OF 11)**

DESIGNED BY: SAH
DRAWN BY: KJR
CHECKED BY: MAG
APPROVED BY: VCL
PROJECT NO: 24.0359.01
DATE: MARCH 28, 2025

SHEET NUMBER
E404

AVCON, INC.
ENGINEERS & PLANNERS

3298 SUMMIT BLVD., SUITE 26
PENSACOLA, FL 32503
OFFICE: (850) 698-3526
CORPORATE CERTIFICATE OF
AUTHORIZATION NUMBER: 5057
www.avconinc.com

**TRANSFORMING TODAY'S IDEAS
INTO TOMORROW'S REALITY**


THIS DOCUMENT CONTAINS PRIVILEGED AND PROPRIETARY INFORMATION, ALL OF WHICH IS EXPRESSLY PROVIDED BY AVCON, INC. FOR USE BY THE INTENDED RECIPIENT, AND FOR A SPECIFIC PURPOSE. WITHOUT THE EXPRESS WRITTEN CONSENT OF AVCON, INC. ANY DISTRIBUTION, REPRODUCTION, OR OTHER USE OF THIS DOCUMENT, IN WHOLE OR IN PART, IS STRICTLY PROHIBITED.

N:\359 CITY OF PENSACOLA-AIRPORT\2024.0359.01-PNS RUNWAY 8-26\000 CAD\24035901_E401-411.DWG 4/11/2025 9:14 AM



NOTES:

1. SEE SHEET E401 FOR GENERAL NUMBERING NOTES.

MATCH LINE - SEE SHEET E403

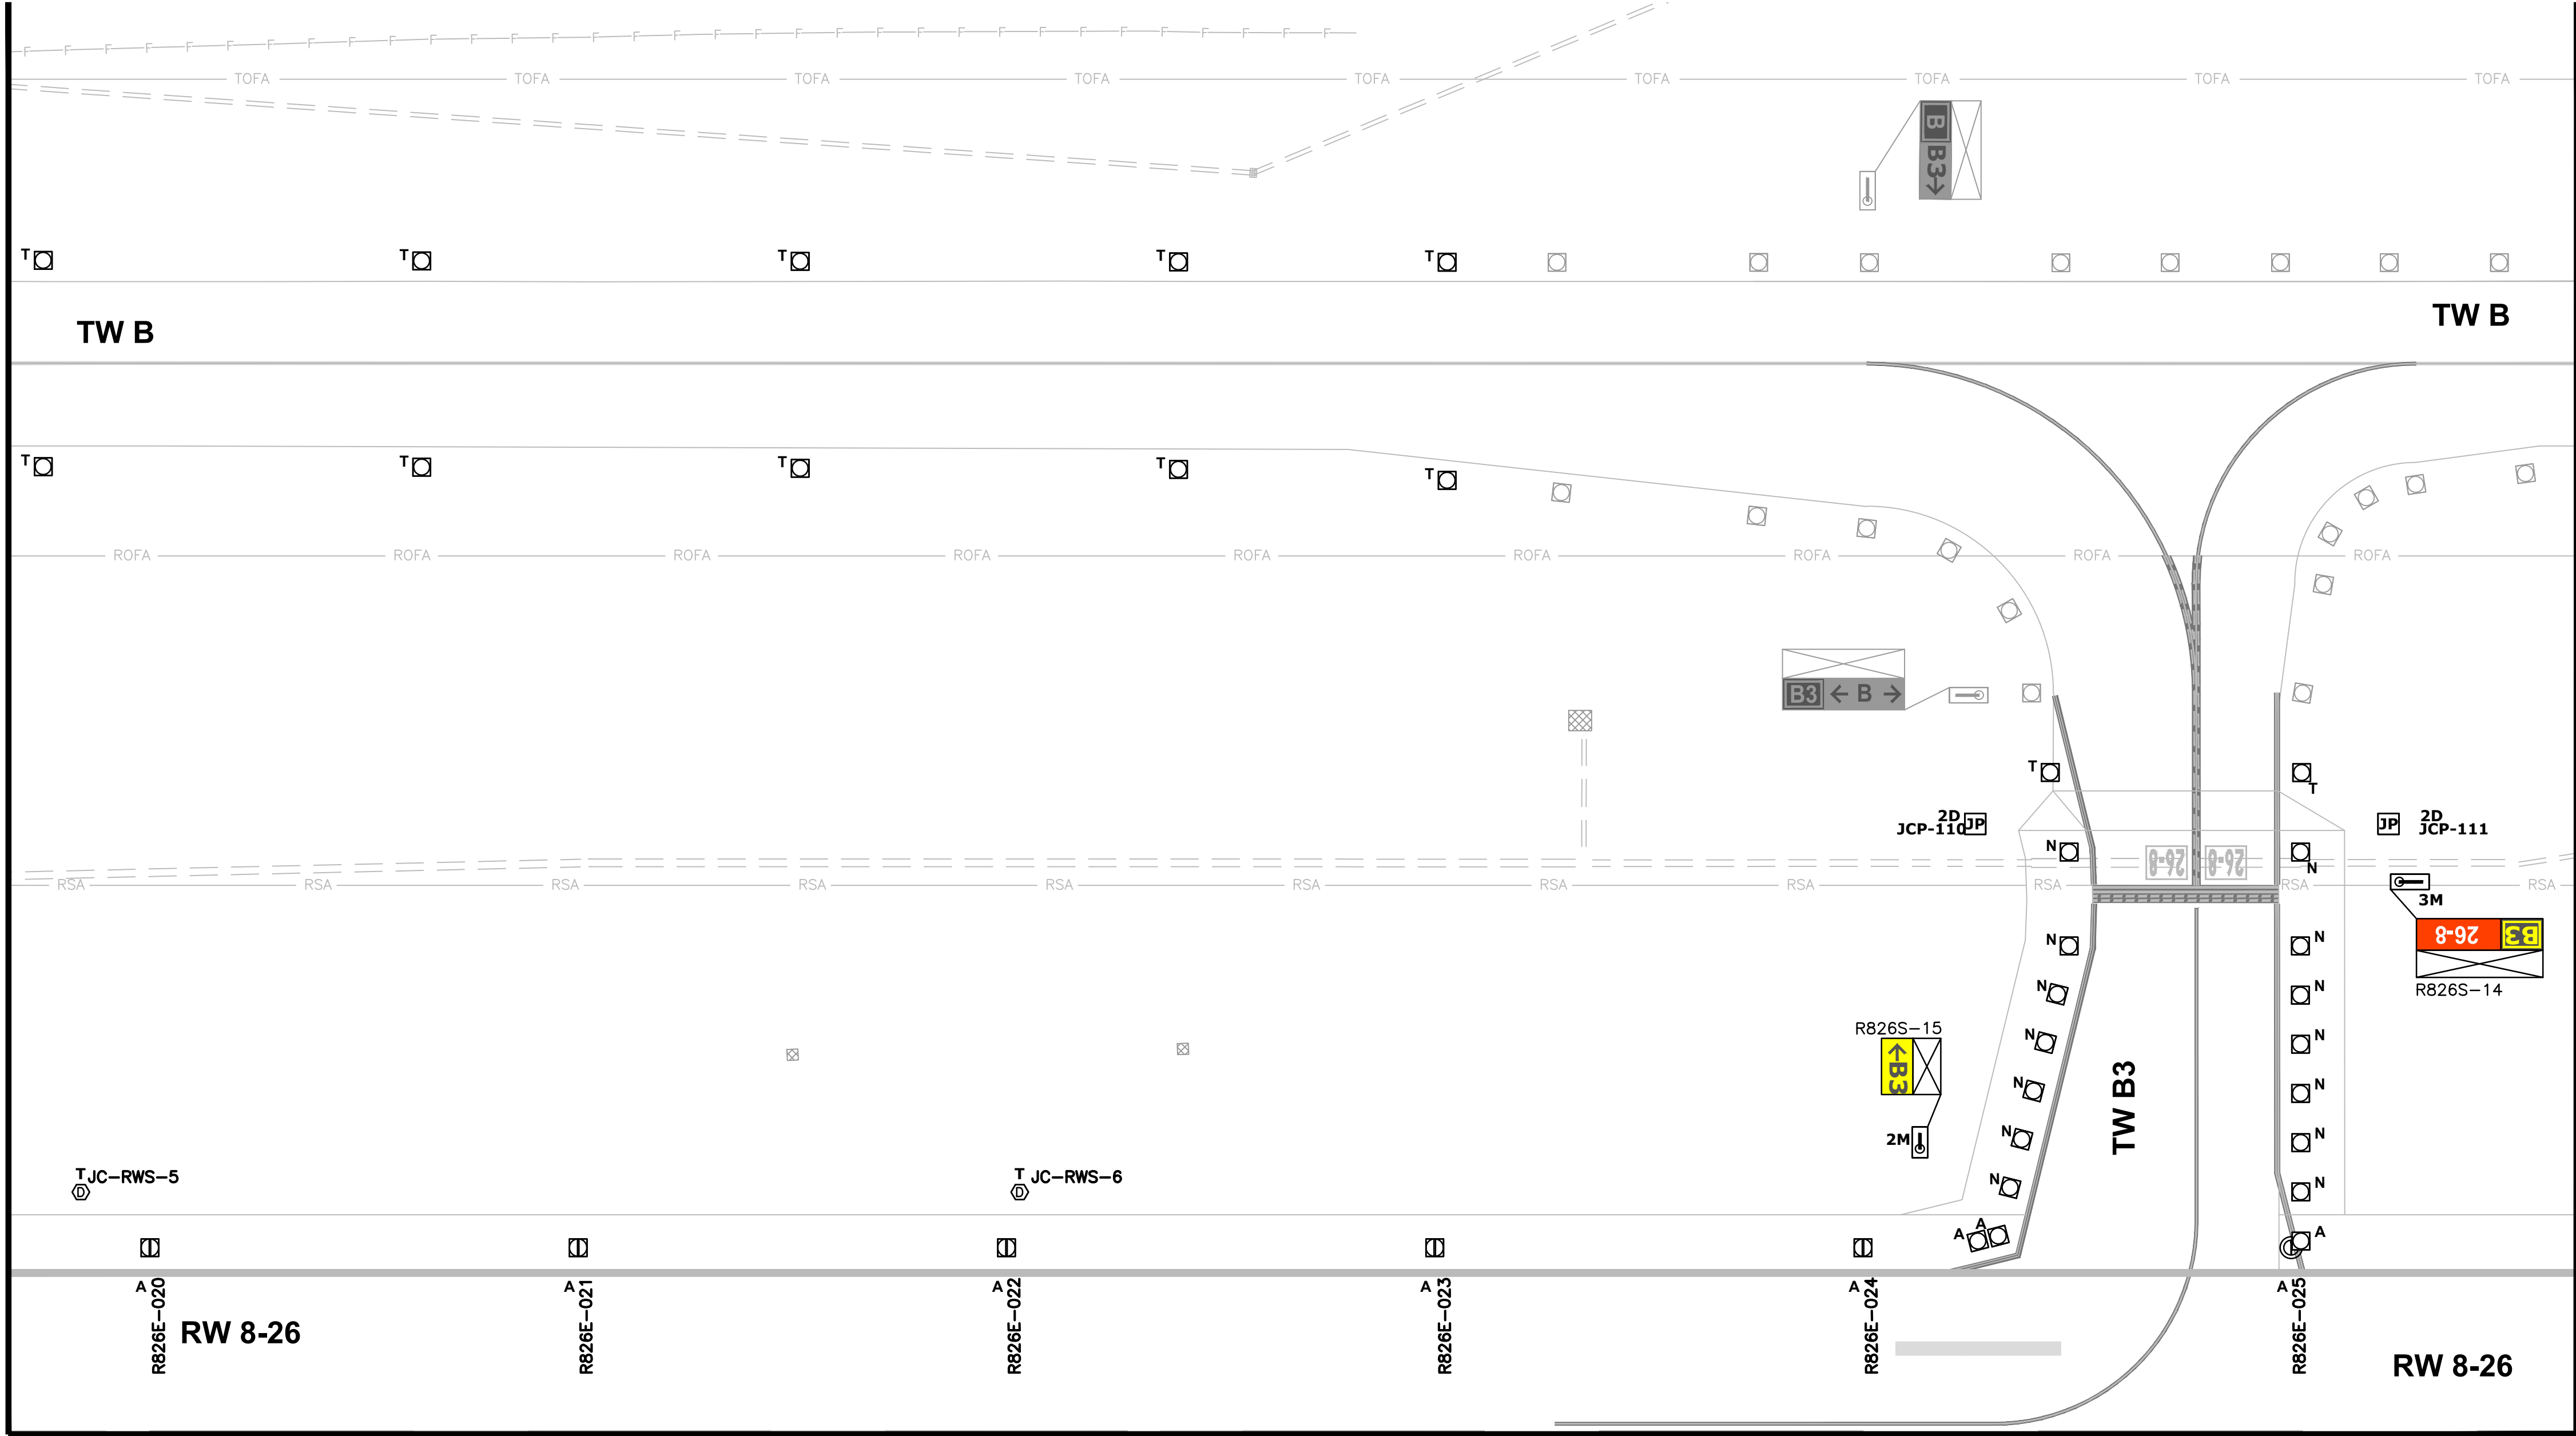

MATCH LINE - SEE SHEET E406

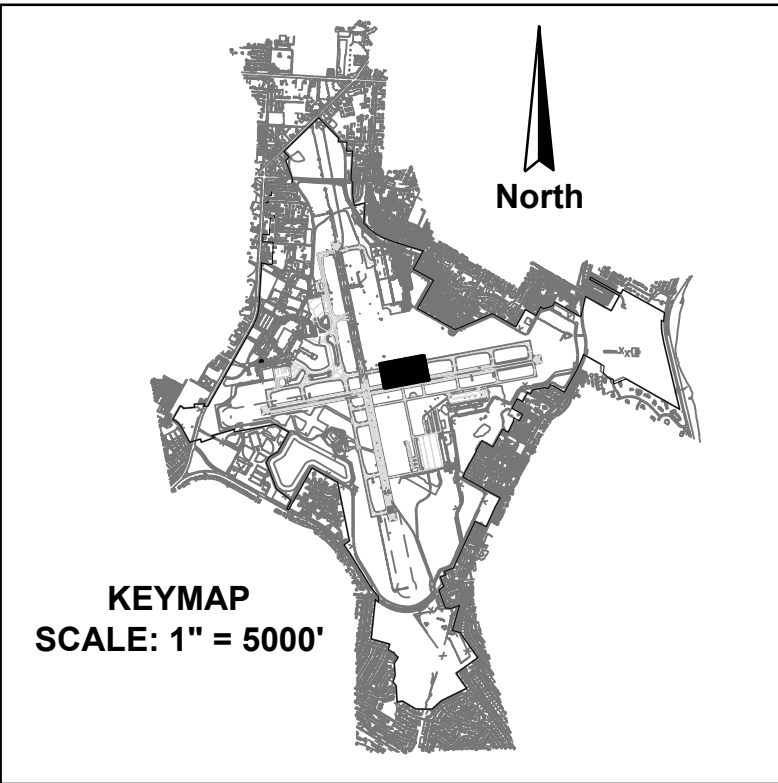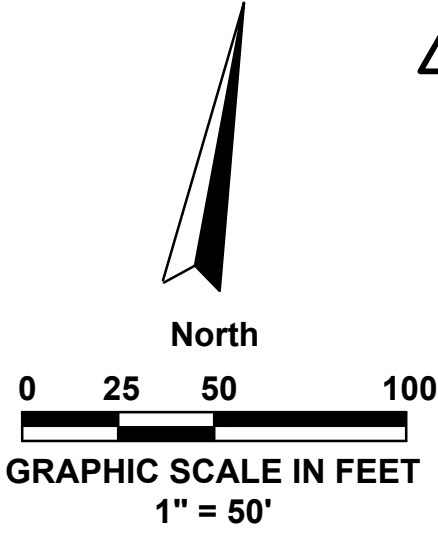

AVCON, INC.
ENGINEERS & PLANNERS
3298 SUMMIT BLVD., SUITE 26
PENSACOLA, FL 32503
OFFICE: (850) 688-5526
CORPORATE CERTIFICATE OF
AUTHORIZATION NUMBER: 5057
WWW.AVCONINC.COM

N:\MICHELLE-CAD\02_L005\A\000\0000.pptx

NO.	DATE	REVISION	BY
1	4/25	ADDENDUM 3	SAH
2			
3			
4			
5			
6			
7			
8			
9			
10			

**AIRFIELD LIGHTING
NUMBERING PLAN
(SHEET 5 OF 11)**
ISSUED FOR BID DRAWINGS

**RUNWAY 8-26
REHABILITATION**
PREPARED FOR
PENSACOLA INTERNATIONAL AIRPORT

DESIGNED BY: SAH
DRAWN BY: KJF
CHECKED BY: MAG
APPROVED BY: VCL
PROJECT NO: 24.0359.01
DATE: MARCH 28, 2025




**SHEET NUMBER
E405**

THIS DOCUMENT CONTAINS PRIVILEGED AND PROPRIETARY INFORMATION. ALL OF WHICH IS EXPRESSLY PROVIDED BY AVCON, INC., FOR USE BY THE INTENDED RECIPIENT, AND FOR A SPECIFIC PURPOSE. WITHOUT THE EXPRESS WRITTEN CONSENT OF AVCON, INC., ANY DISTRIBUTION, REPRODUCTION, OR OTHER USE OF THIS DOCUMENT, IN WHOLE OR IN PART, IS STRICTLY PROHIBITED.

N:\359 CITY OF PENSACOLA-AIRPORT\2024.0359.01-PNS RUNWAY 8-26\000 CAD\24035901_E401-411.DWG 4/11/2025 9:15 AM

NOTES:
1. SEE SHEET E401 FOR GENERAL NUMBERING NOTES.

MATCH LINE - SEE SHEET E404

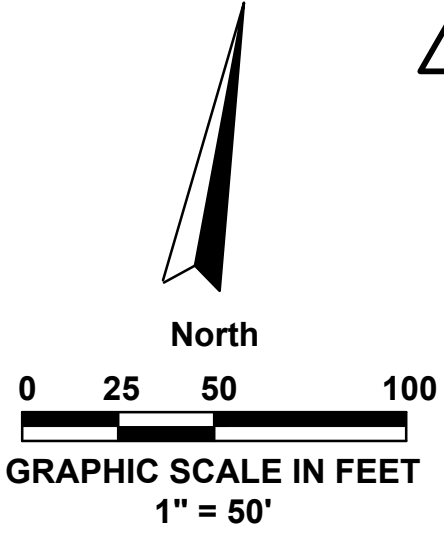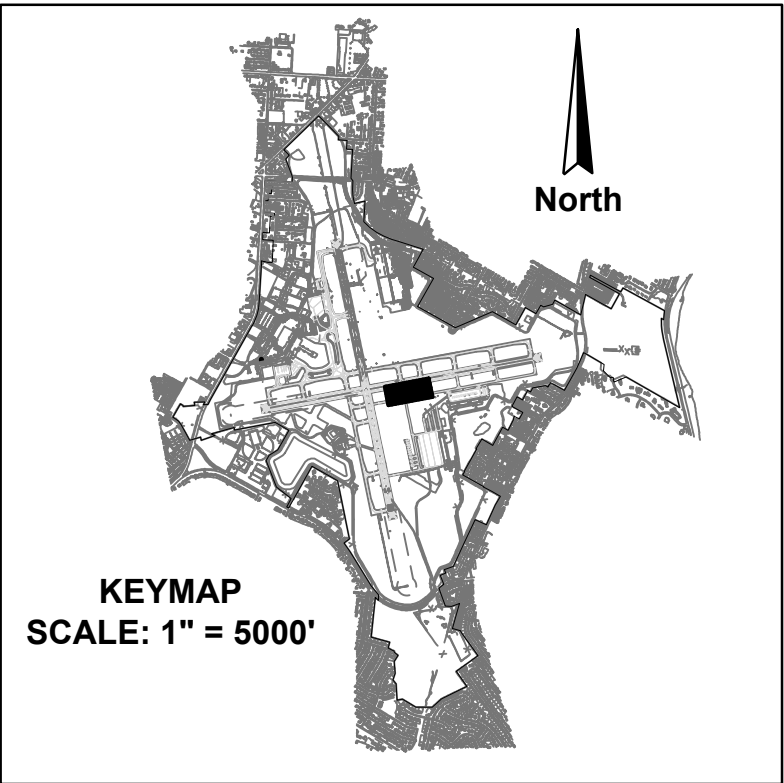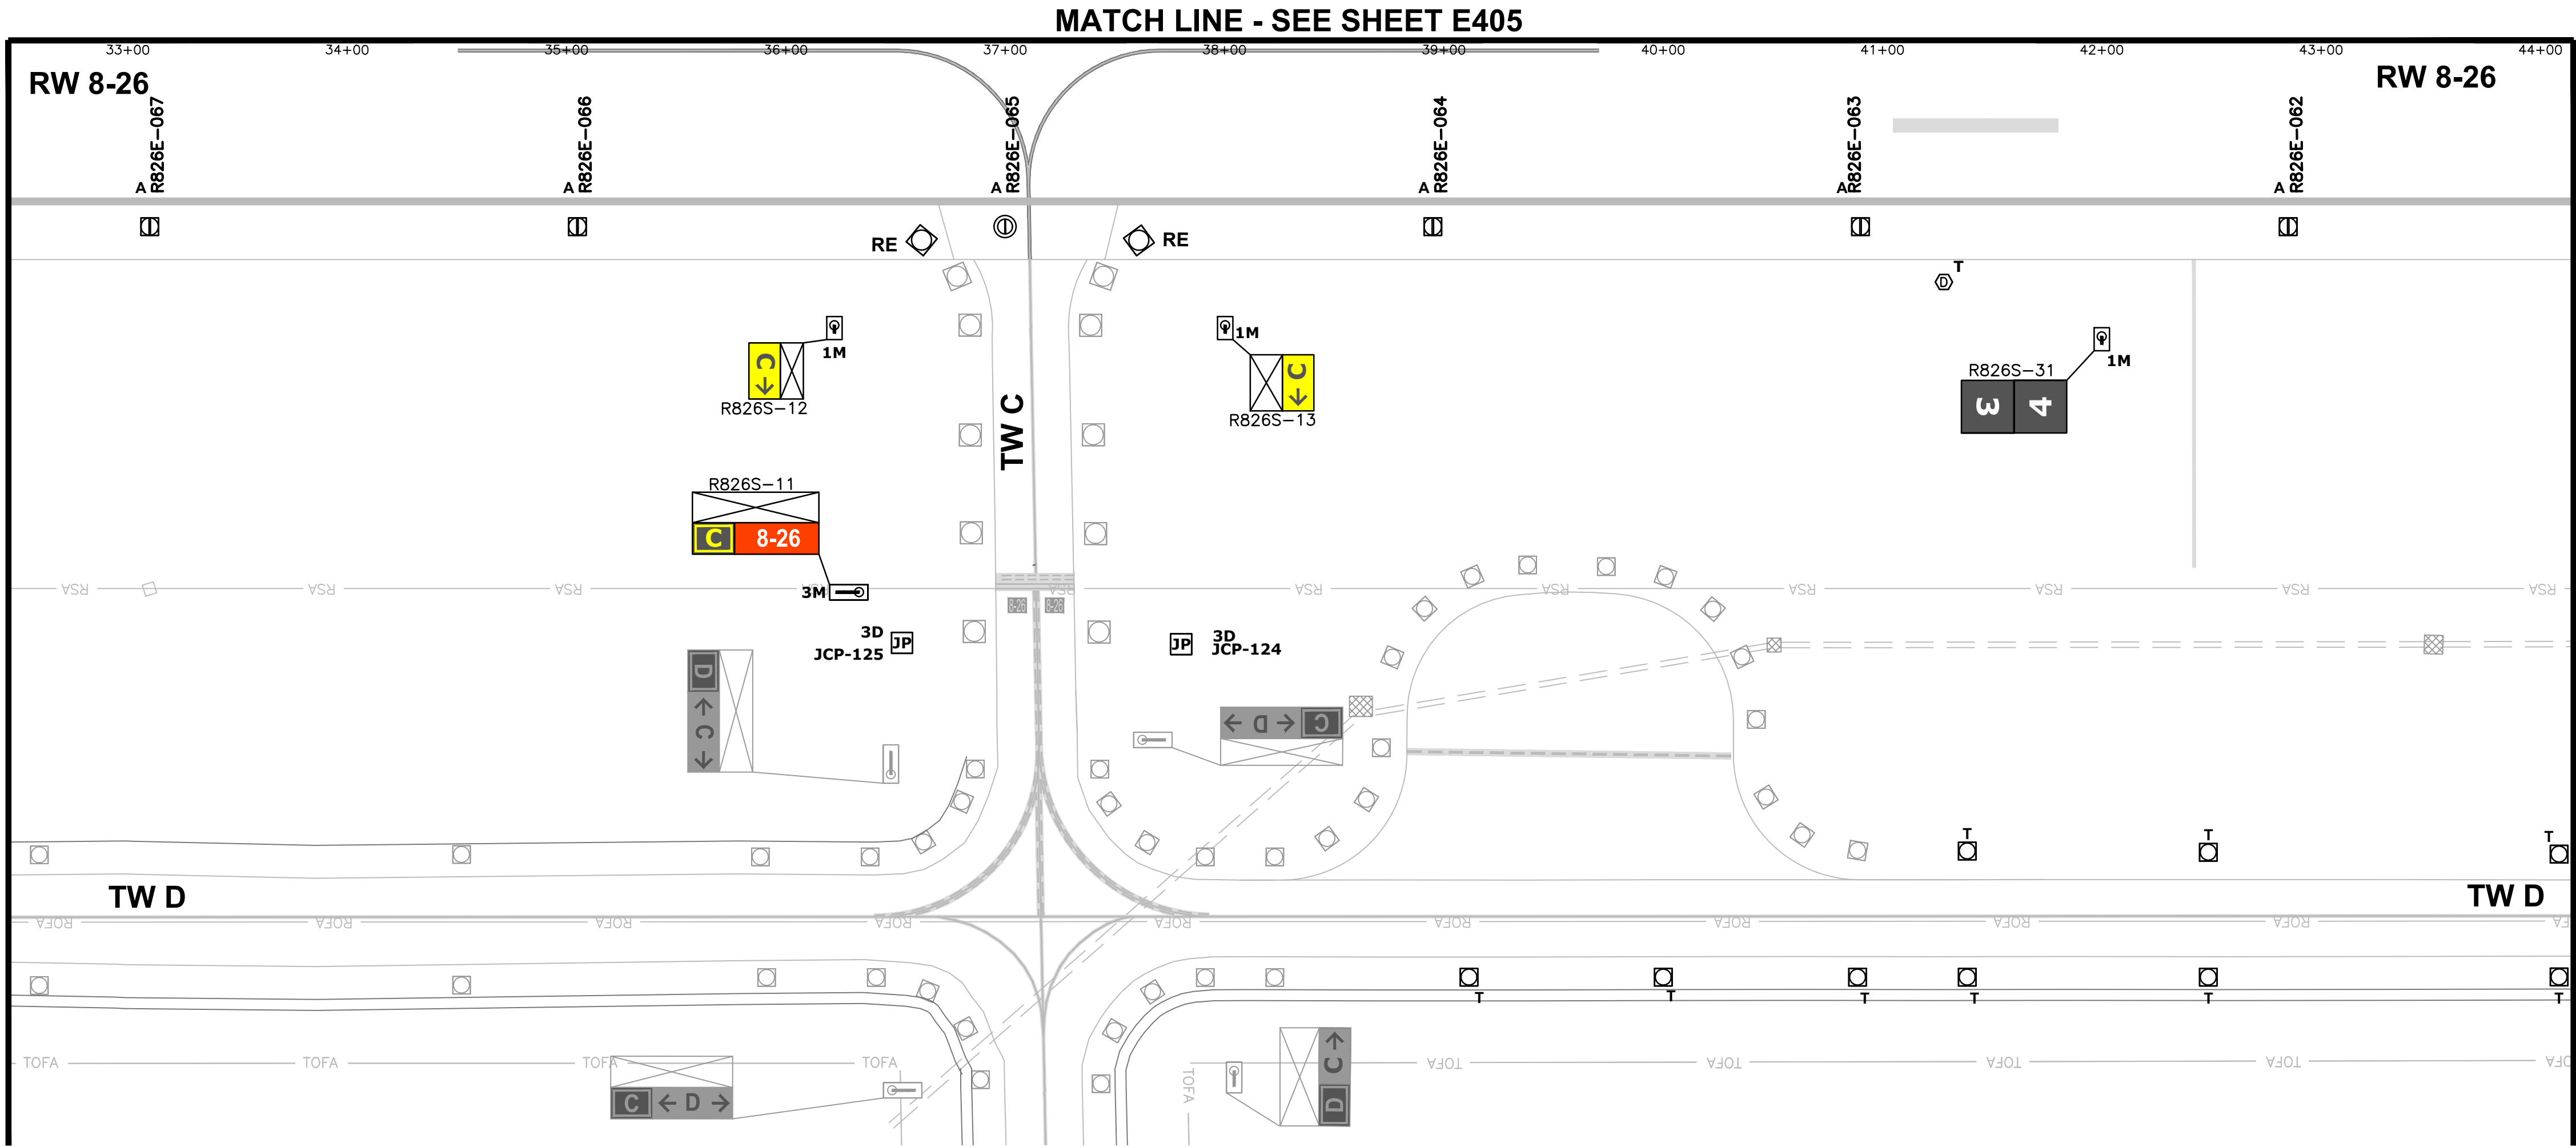

**AIRFIELD LIGHTING
NUMBERING PLAN
(SHEET 6 OF 11)**
ISSUED FOR BID DRAWINGS

**RUNWAY 8-26
REHABILITATION**
PREPARED FOR
PENSACOLA INTERNATIONAL AIRPORT

DESIGNED BY: SAH
DRAWN BY: KJF
CHECKED BY: MAG
APPROVED BY: VCL
PROJECT NO: 24.0359.01
DATE: MARCH 28, 2025

**SHEET NUMBER
E406**

AVCON, INC.
ENGINEERS & PLANNERS
3298 SUMMIT BLVD., SUITE 26
PENSACOLA, FL 32503
OFFICE: (850) 688-5526
CORPORATE CERTIFICATE OF
AUTHORIZATION NUMBER: 5057
WWW.AVCONINC.COM


NO.	DATE	REVISION	BY
1	4/25	ADDENDUM 3	SAH
2			
3			
4			
5			
6			
7			
8			
9			
10			

TRANSFORMING TODAY'S IDEAS
INTO TOMORROW'S REALITY
THIS DOCUMENT CONTAINS PRIVILEGED AND PROPRIETARY INFORMATION. ALL OF WHICH IS EXPRESSLY PROVIDED BY AVCON, INC., FOR USE BY THE INTENDED RECIPIENT, AND FOR A SPECIFIC PURPOSE. WITHOUT THE EXPRESS WRITTEN CONSENT OF AVCON, INC., ANY DISTRIBUTION, REPRODUCTION, OR OTHER USE OF THIS DOCUMENT, IN WHOLE OR IN PART, IS STRICTLY PROHIBITED.

N:\359 CITY OF PENSACOLA-AIRPORT\2024.0359.01-PNS RUNWAY 8-26\000 CAD\24035901_E401-411.DWG 4/11/2025 9:15 AM



MATCH LINE - SEE SHEET E406

MATCH LINE - SEE SHEET E405

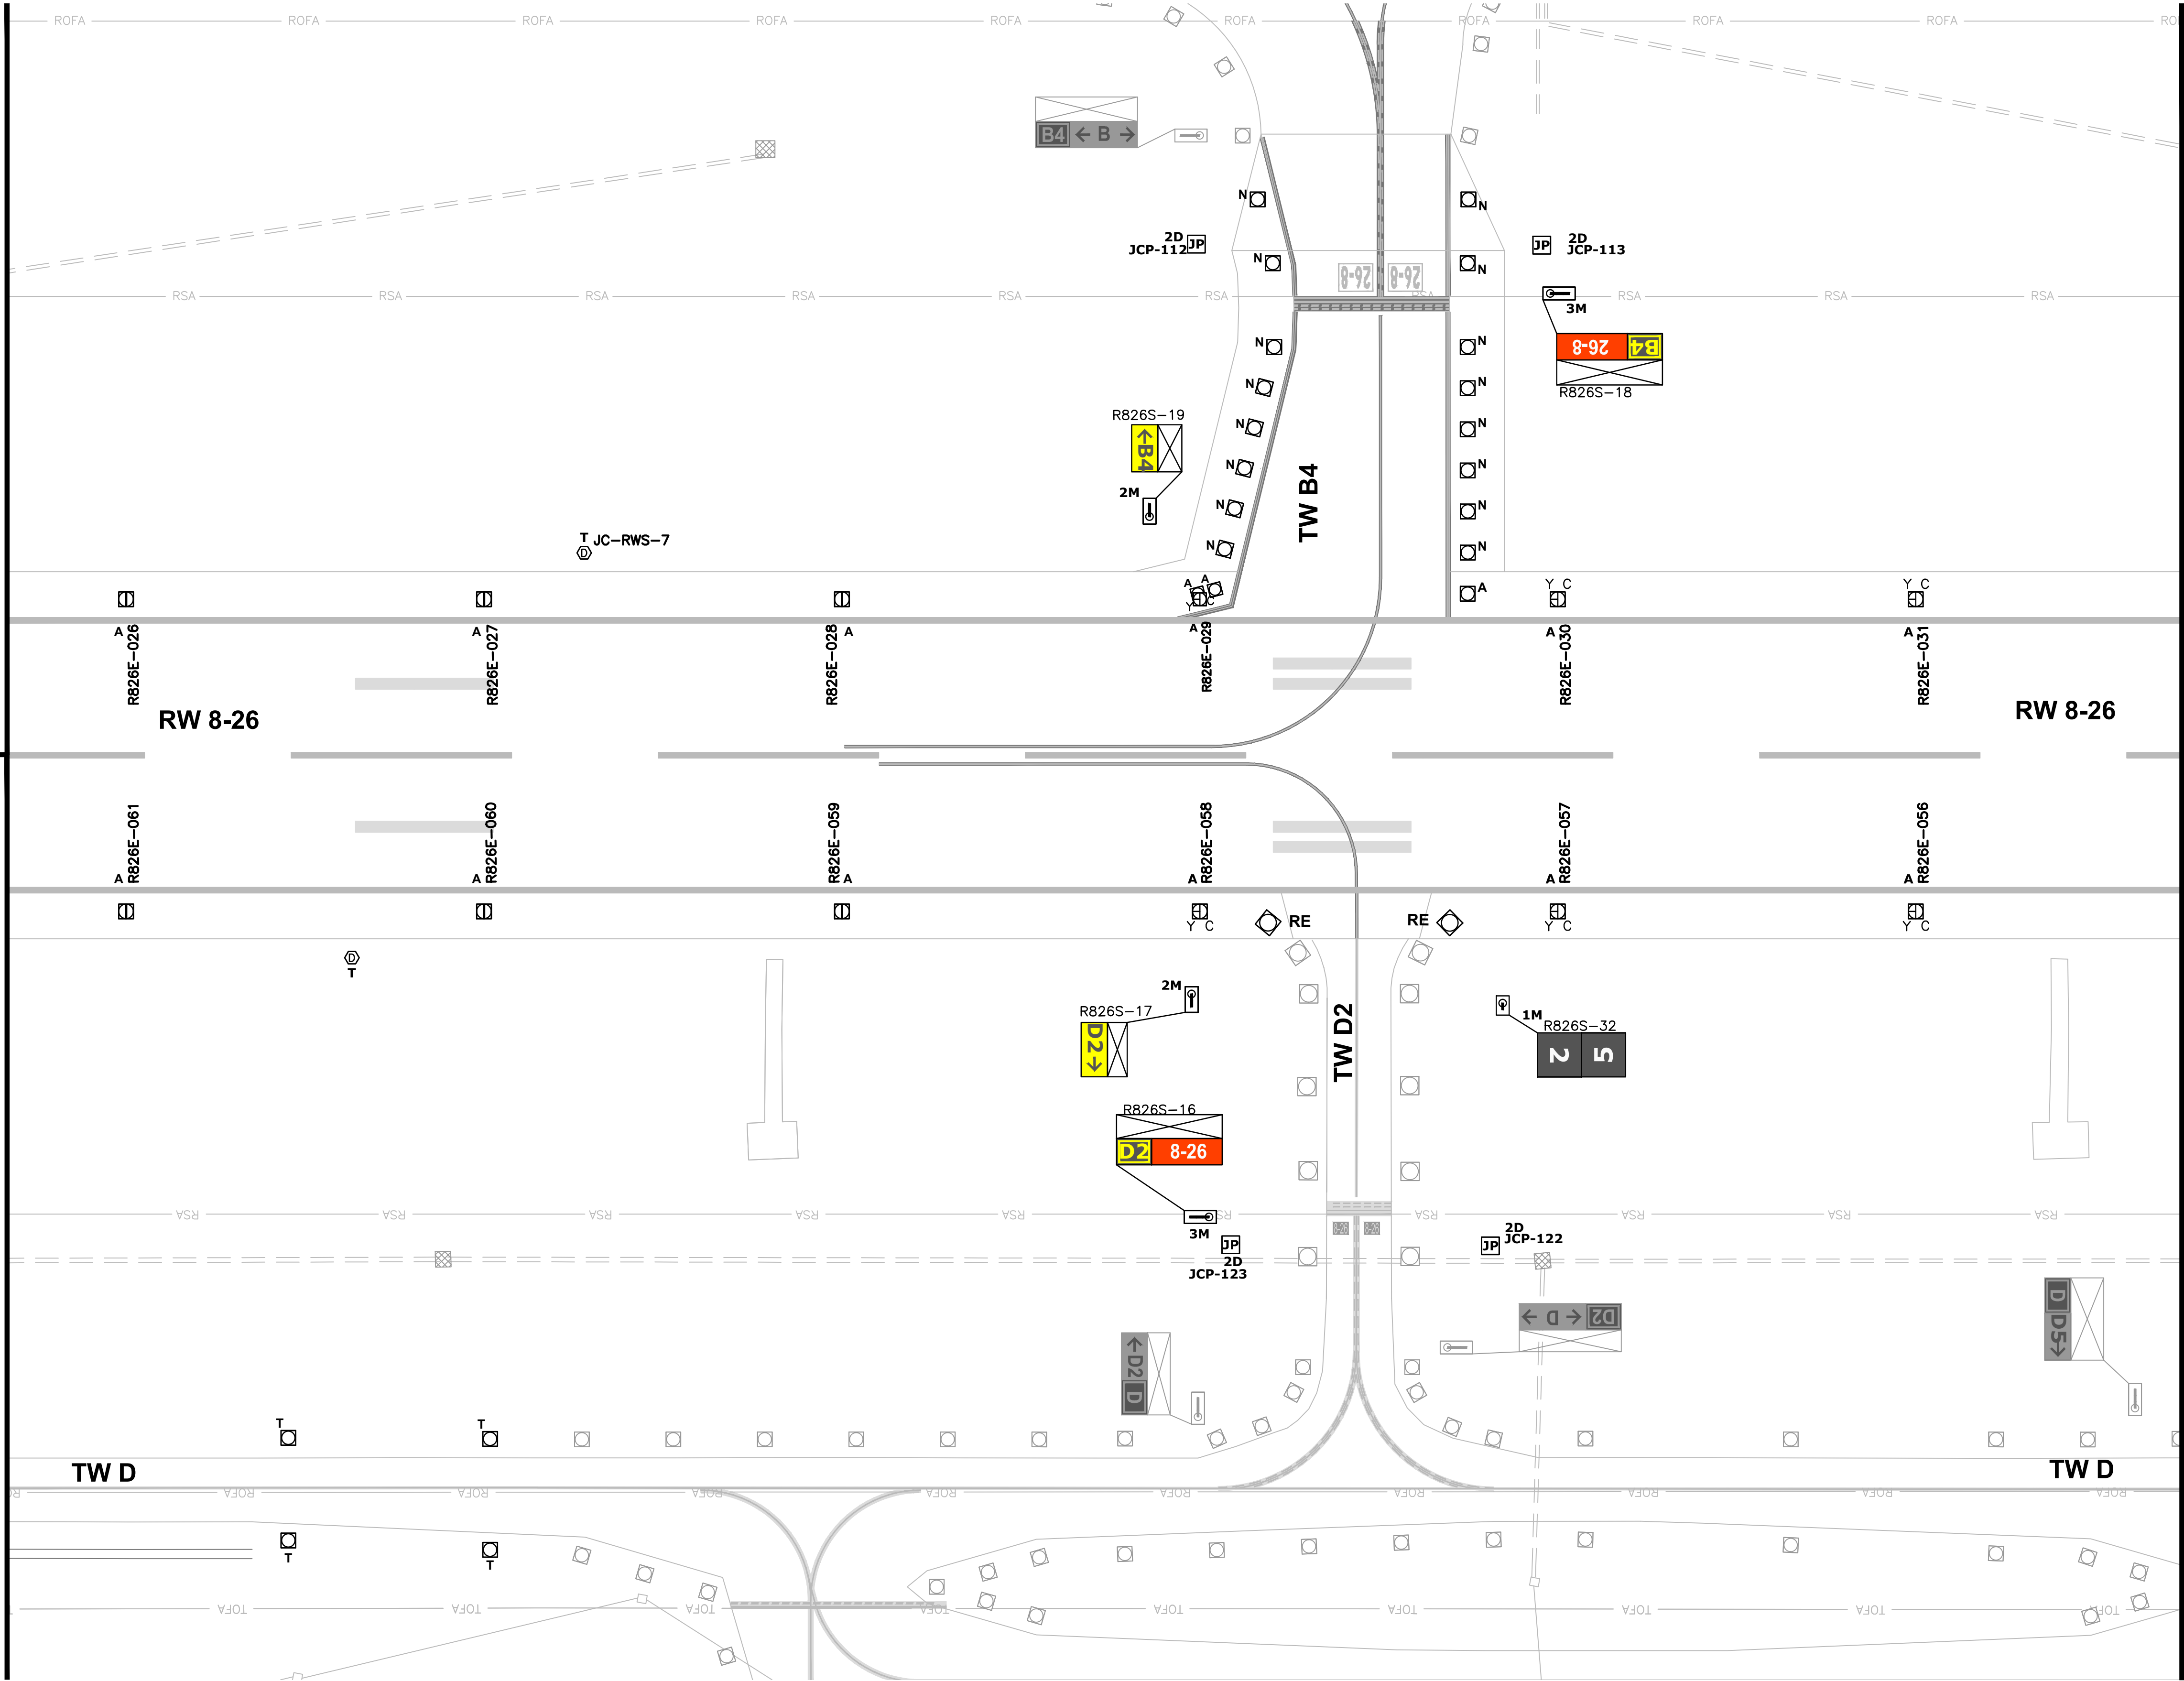

NOTES:

1. SEE SHEET E401 FOR GENERAL NUMBERING NOTES.

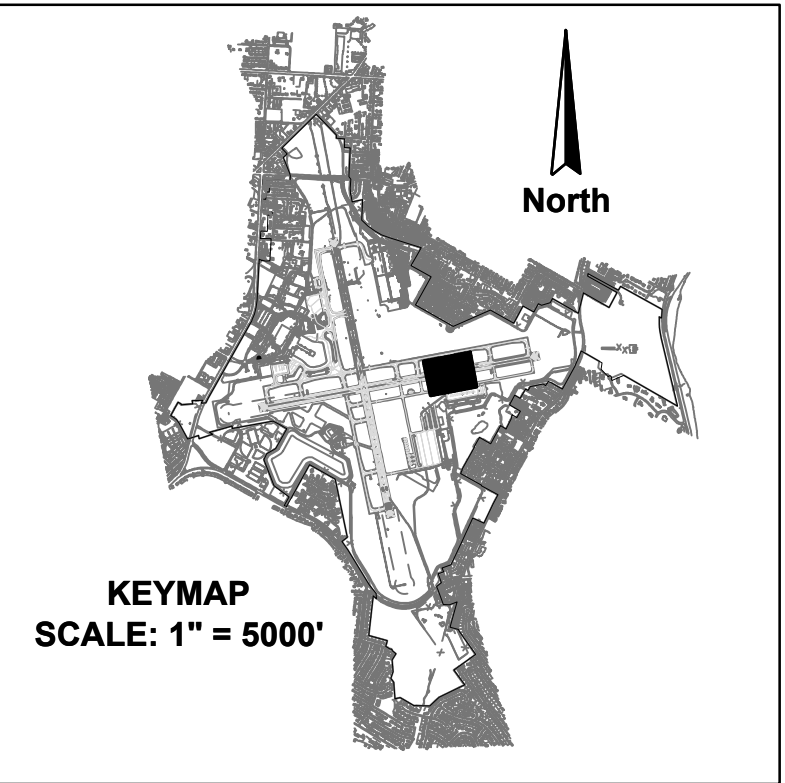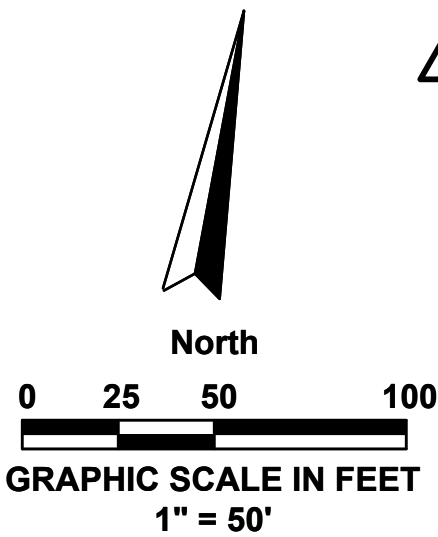

MATCH LINE - SEE SHEET E408

RUNWAY 8-26
REHABILITATION

AIRFIELD LIGHTING
NUMBERING PLAN
(SHEET 7 OF 11)

NO.	DATE	REVISION	BY
1	4/25	ADDENDUM 3	SAH
2			
3			
4			
5			
6			
7			
8			
9			
10			

DESIGNED BY: SAH
DRAWN BY: KJF
CHECKED BY: MAG
APPROVED BY: VCL
PROJECT NO: 24.0359.01
DATE: MARCH 28, 2025

SHEET NUMBER
E407

AVCON, INC.
ENGINEERS & PLANNERS
3298 SUMMIT BLVD., SUITE 26
PENSACOLA, FL 32503
OFFICE: (850) 688-5526
CORPORATE CERTIFICATE OF
AUTHORIZATION NUMBER: 5057
WWW.AVCONINC.COM

TRANSFORMING TODAY'S IDEAS
INTO TOMORROW'S REALITY

THIS DOCUMENT CONTAINS PRIVILEGED AND PROPRIETARY INFORMATION, ALL OF WHICH IS EXPRESSLY PROVIDED BY AVCON, INC., FOR USE BY THE INTENDED RECIPIENT, AND FOR A SPECIFIC PURPOSE. WITHOUT THE EXPRESS WRITTEN CONSENT OF AVCON, INC., ANY DISTRIBUTION, REPRODUCTION, OR OTHER USE OF THIS DOCUMENT, IN WHOLE OR IN PART, IS STRICTLY PROHIBITED.



DESIGNED BY: SAH
DRAWN BY: KJF
CHECKED BY: MAG
APPROVED BY: VCL
PROJECT NO: 24.0359.01
DATE: MARCH 28, 2025

SHEET NUMBER
E408

AVCON, INC.
ENGINEERS & PLANNERS

3298 SUMMIT BLVD., SUITE 26
PENSACOLA, FL. 32503

OFFICE: (850) 698-3526

CORPORATE CERTIFICATE OF
AUTHORIZATION NUMBER: 5057

www.avconinc.com

**TRANSFORMING TODAY'S IDEAS
INTO TOMORROW'S REALITY**

[illegible]


**AIRFIELD LIGHTING
NUMBERING PLAN
(SHEET 8 OF 11)**

ISSUED FOR BID DRAWINGS

THIS DOCUMENT CONTAINS PRIVILEGED AND PROPRIETARY INFORMATION, ALL OF WHICH IS EXPRESSLY PROVIDED BY AVCON, INC. FOR USE BY THE INTENDED RECIPIENT, AND FOR A SPECIFIC PURPOSE. WITHOUT THE EXPRESS WRITTEN CONSENT OF AVCON, INC. ANY DISTRIBUTION, REPRODUCTION, OR OTHER USE OF THIS DOCUMENT, IN WHOLE OR IN PART, IS STRICTLY PROHIBITED.



N:\359 CITY OF PENSACOLA-AIRPORT\2024.0359.01-PNS RUNWAY 8-26\000 CAD\24035901_E401-411.DWG 4/11/2025 9:15 AM

MATCH LINE - SEE SHEET E408

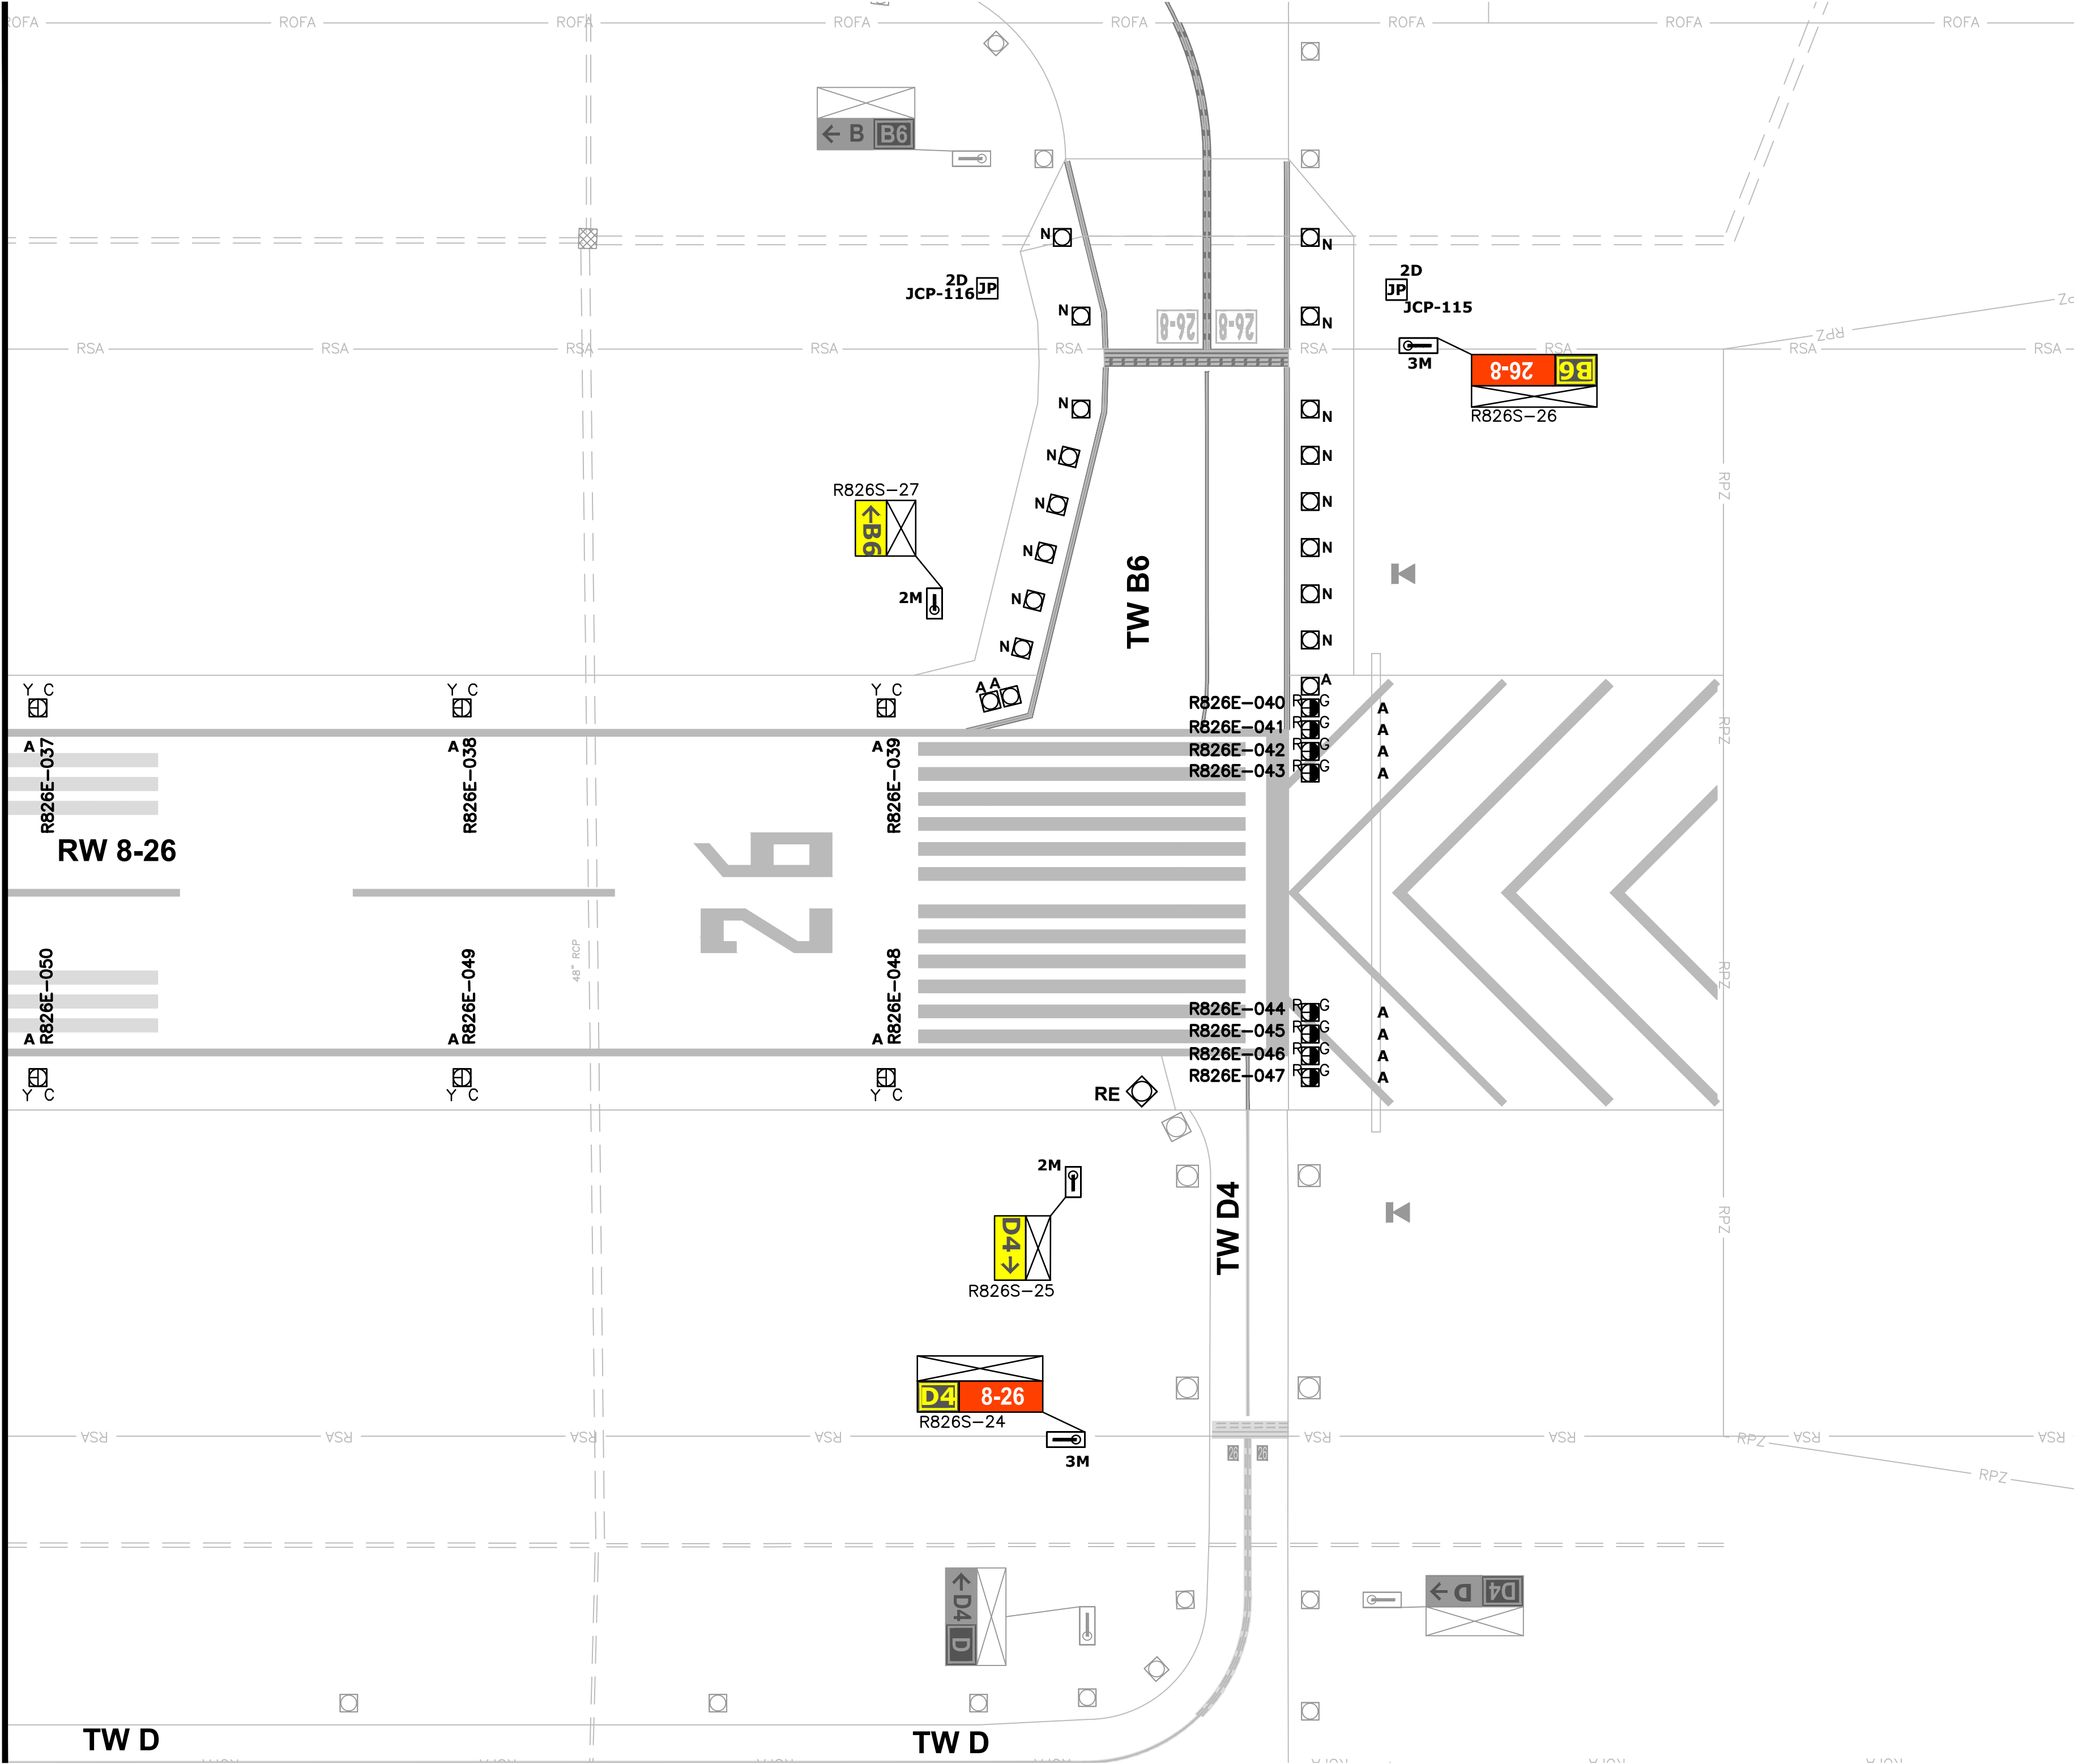

NOTES:

- SEE SHEET E401 FOR GENERAL NUMBERING NOTES.

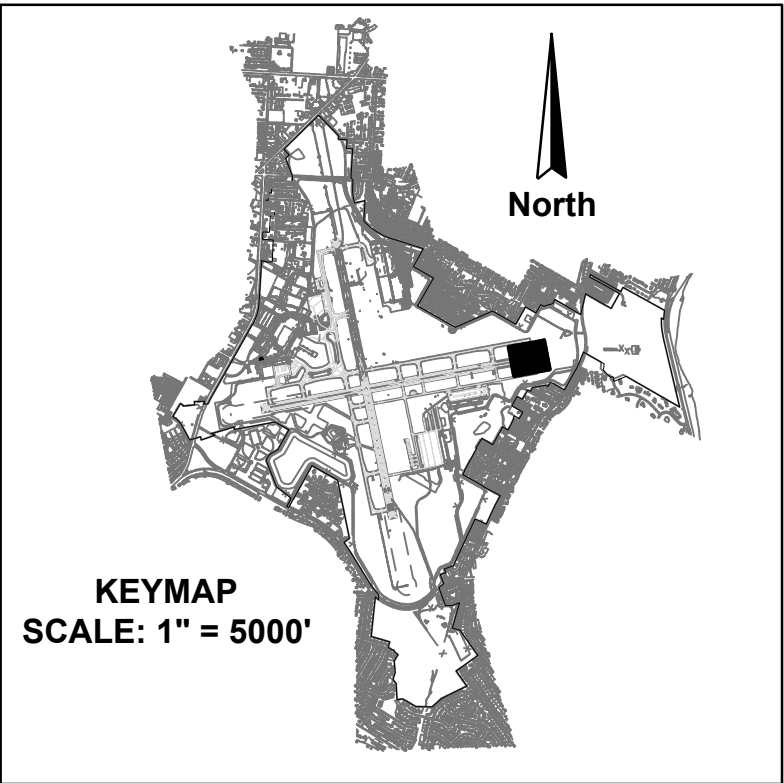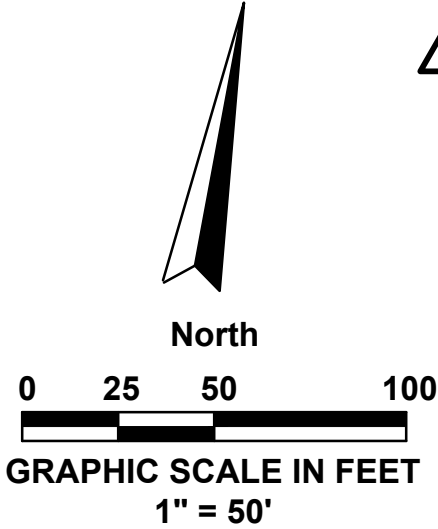

AVCON, INC.
ENGINEERS & PLANNERS
3298 SUMMIT BLVD., SUITE 26
PENSACOLA, FL 32503
OFFICE: (850) 688-5526
CORPORATE CERTIFICATE OF
AUTHORIZATION NUMBER: 5057
WWW.AVCONINC.COM

N:\NICK\KLE-CAD\002\LOGS\AVCON\0000.pgm.dwg

TRANSFORMING TODAY'S IDEAS
INTO TOMORROW'S REALITY

NO.	DATE	REVISION	BY
1	4/25	ADDENDUM 3	SAH
2			
3			
4			
5			
6			
7			
8			
9			
10			

AIRFIELD LIGHTING
NUMBERING PLAN
(SHEET 9 OF 11)

RUNWAY 8-26
REHABILITATION

DESIGNED BY: SAH
DRAWN BY: KJF
CHECKED BY: MAG
APPROVED BY: VCL
PROJECT NO: 24.0359.01
DATE: MARCH 28, 2025

SHEET NUMBER
E409

THIS DOCUMENT CONTAINS PRIVILEGED AND PROPRIETARY INFORMATION. ALL OF WHICH IS EXPRESSLY PROVIDED BY AVCON, INC., FOR USE BY THE INTENDED RECIPIENT, AND FOR A SPECIFIC PURPOSE. WITHOUT THE EXPRESS WRITTEN CONSENT OF AVCON, INC., ANY DISTRIBUTION, REPRODUCTION, OR OTHER USE OF THIS DOCUMENT, IN WHOLE OR IN PART, IS STRICTLY PROHIBITED.

1. SEE SHEET E401 FOR GENERAL NUMBERING NOTES.

MATCH LINE - SEE SHEET E403

MATCH LINE - SEE SHEET E411



TW A

TWA

12D
JCP-04

RW 35-17

RW 35-17

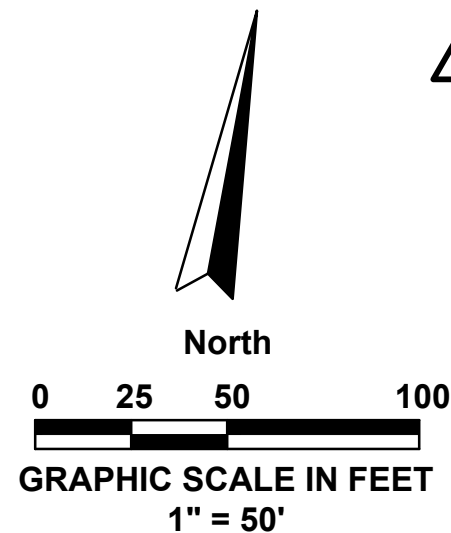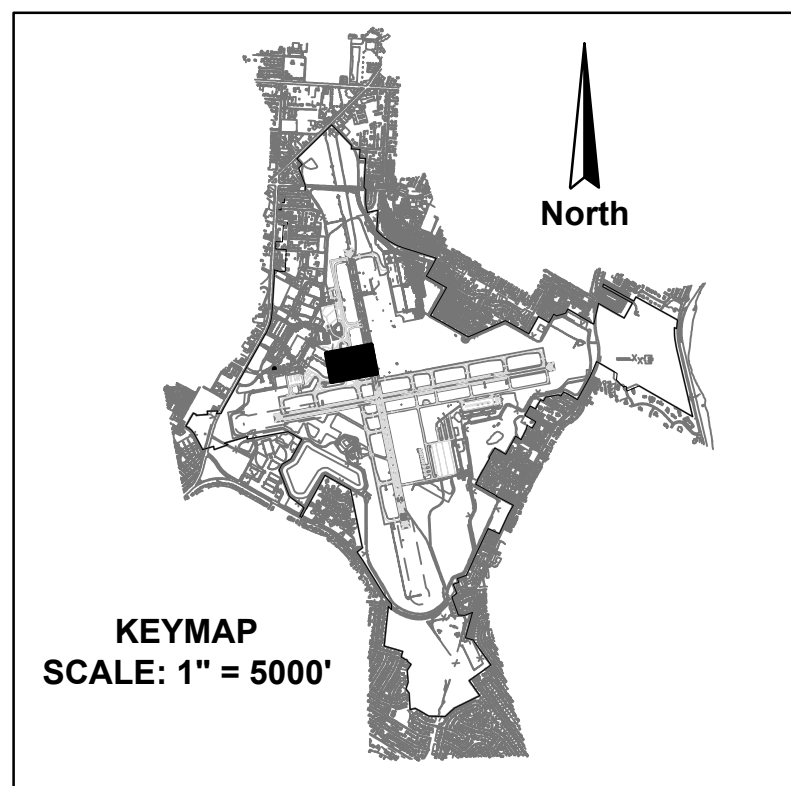

DESIGNED BY: SAH DRAWN BY: KJF CHECKED BY: MAG APPROVED BY: VCL PROJECT NO: 24.0359.01 DATE: MARCH 28, 2025	RUNWAY 8-26 REHABILITATION	AIRFIELD LIGHTING NUMBERING PLAN (SHEET 10 OF 11)
	PREPARED FOR PENSACOLA INTERNATIONAL AIRPORT	ISSUED FOR BID DRAWINGS

N:\NICEVILLE-CAD\002_LOGOS\JPEC\Avecon LOGO .pm5.jpg


AVCON, INC.
ENGINEERS & PLANNERS

3298 SUMMIT BLVD., SUITE 26
PENSACOLA, FL 32503
OFFICE: (850) 698-3526
CORPORATE CERTIFICATE OF
AUTHORIZATION NUMBER: 5057
www.avconinc.com


TRANSFORMING TODAY'S IDEAS
INTO TOMORROW'S REALITY

THIS DOCUMENT CONTAINS PRIVILEGED AND PROPRIETARY INFORMATION, ALL OF WHICH IS EXPRESSLY PROVIDED BY AVCON, INC., FOR USE BY THE INTENDED RECIPIENT, AND FOR A SPECIFIC PURPOSE. WITHOUT THE EXPRESS WRITTEN CONSENT OF AVCON, INC., ANY DISTRIBUTION, REPRODUCTION, OR OTHER USE OF THIS DOCUMENT, IN WHOLE OR IN PART, IS STRICTLY PROHIBITED.

1. SEE SHEET E401 FOR GENERAL NUMBERING NOTES.

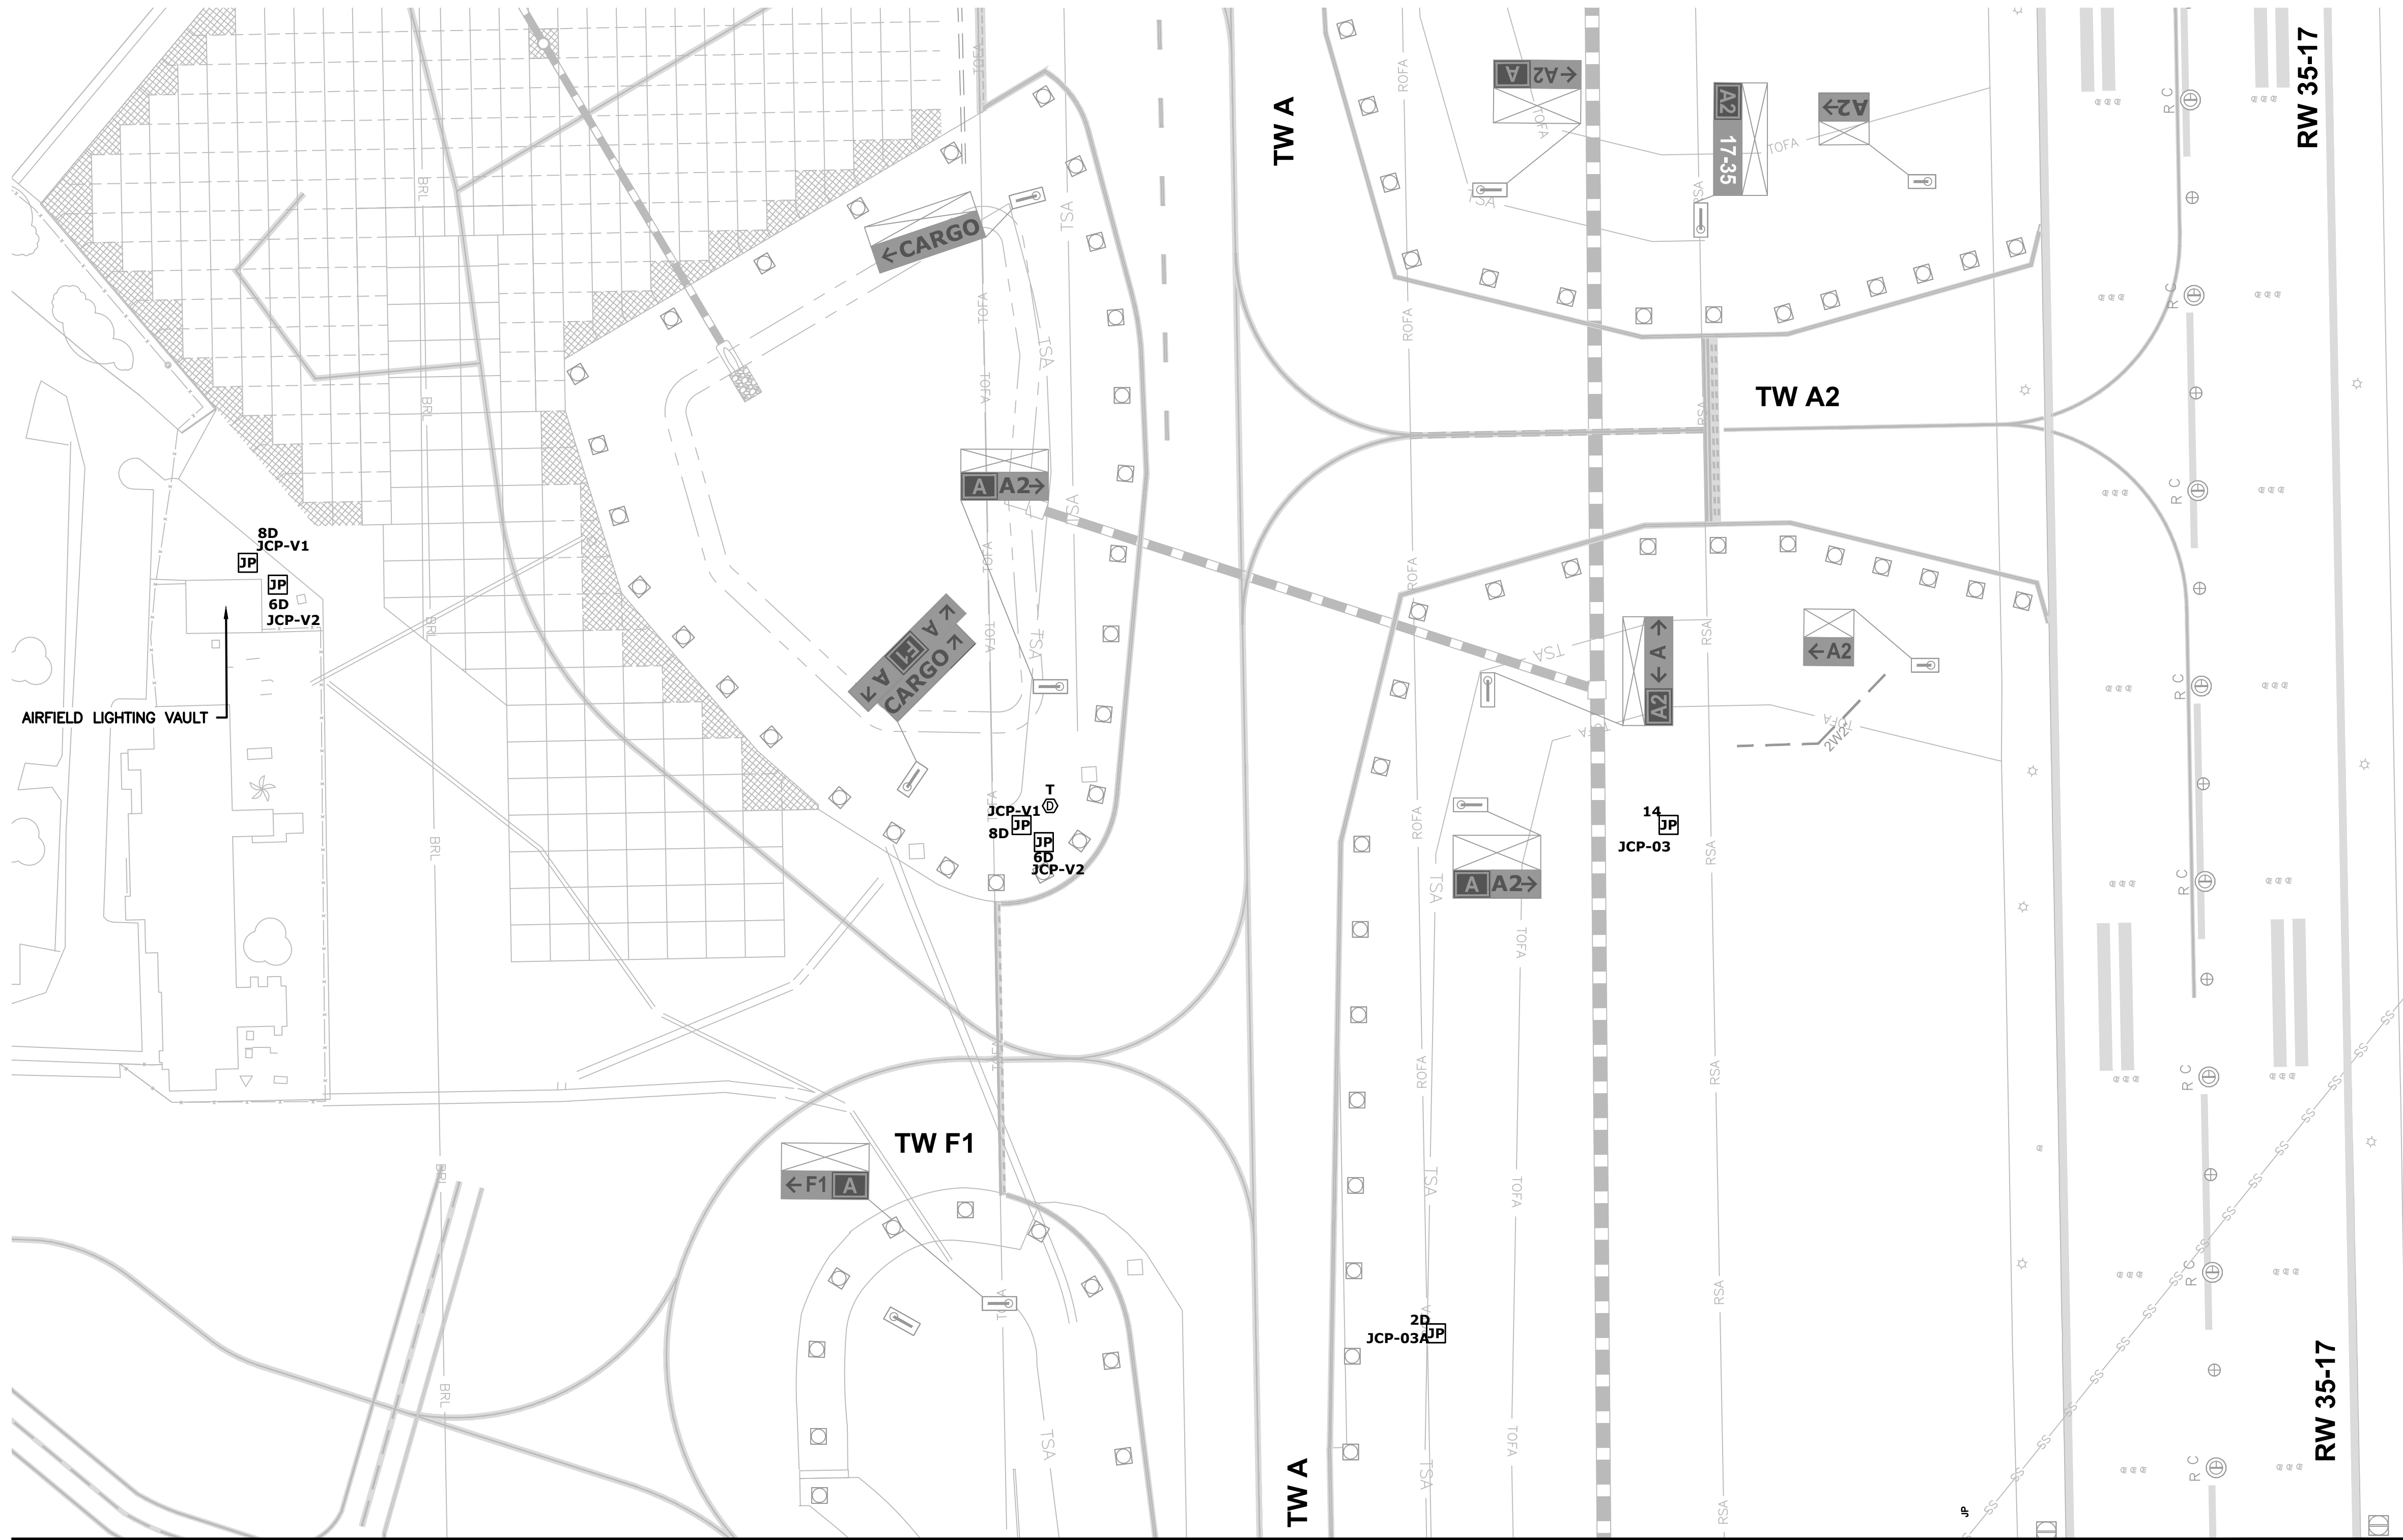

KEYMAP
SCALE: 1" = 5000'

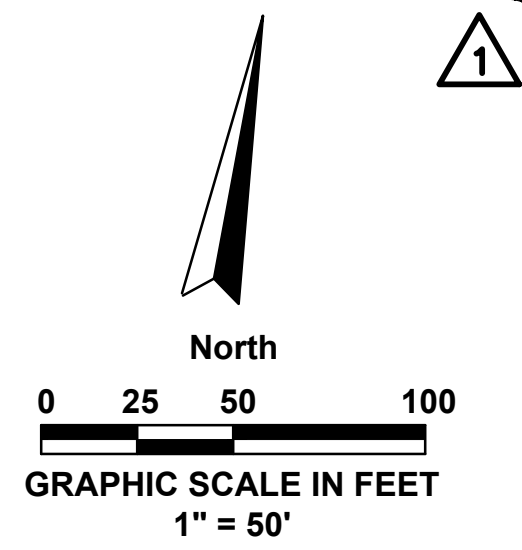

--	--

4/25	ADDENDUM 3	SAH
△		
△		
NO.	DATE	REVISION
BY		

AVCON, INC.
ENGINEERS & PLANNERS
 3298 SUMMIT BLVD., SUITE 26
 PENSACOLA, FL. 32503
 OFFICE: (850) 698-3526
 CORPORATE CERTIFICATE OF
 AUTHORIZATION NUMBER: 5057
www.avconline.com

**TRANSFORMING TODAY'S IDEAS
INTO TOMORROW'S REALITY**

THIS DOCUMENT CONTAINS PRIVILEGED AND PROPRIETARY INFORMATION ALL OF WHICH IS EXPRESSLY PROVIDED BY AVCON, INC. FOR USE BY THE INTENDED RECIPIENT, AND FOR A SPECIFIC PURPOSE. WITHOUT THE EXPRESS WRITTEN CONSENT OF AVCON, INC. ANY DISTRIBUTION, REPRODUCTION, OR OTHER USE OF THIS DOCUMENT, IN WHOLE OR IN PART, IS STRICTLY PROHIBITED.

N:\359 CITY OF PENSACOLA-AIRPORT\2024-0359.01-PNS RUNWAY 8-26\000 CAD\24035901_E512-E513.DWG 4/11/2025 9:16 AM

RUNWAY 8-26 SIGN SCHEDULE

SIGN NUMBER	SIGN MESSAGE		TYPE L-858		CIRCUIT	SIZE	STYLE	ESTIMATED MODULES	SHEET NUMBER
	SIDE 1	SIDE 2	SIDE 1	SIDE 2					
R826S-01			L R	BLANK	R826S	3	5	2	E201 E401
R826S-02			BLANK	Y	R826S	3	5	2	E201 E401
R826S-03			L R	BLANK	R826S	3	5	3	E202 E402
R826S-04			BLANK	Y	R826S	3	5	2	E202 E402
R826S-05			L R	BLANK	R826S	3	5	3	E203 E403
R826S-06			BLANK	Y	R826S	3	5	1	E203 E403
R826S-07			L R	BLANK	R826S	3	5	3	E203 E403
R826S-08			Y	BLANK	R826S	3	5	1	E203 E403
R826S-09			R	BLANK	R826S	3	5	2	E203 E403
R826S-10			R	BLANK	R826S	3	5	2	E203 E403
R826S-11			L R	BLANK	R826S	3	5	3	E204 E404
R826S-12			BLANK	Y	R826S	3	5	1	E204 E404
R826S-13			Y	BLANK	R826S	3	5	1	E204 E404
R826S-14			L R	BLANK	R826S	3	5	3	E205 E405
R826S-15			Y	BLANK	R826S	3	5	2	E205 E405
R826S-16			L R	BLANK	R826S	3	5	3	E206 E406
R826S-17			BLANK	Y	R826S	3	5	2	E206 E406
R826S-18			L R	BLANK	R826S	3	5	3	E206 E406
R826S-19			Y	BLANK	R826S	3	5	2	E206 E406
R826S-20			L R	BLANK	R826S	3	5	3	E207 E407
R826S-21			BLANK	Y	R826S	3	5	2	E207 E407
R826S-22			L R	BLANK	R826S	3	5	3	E207 E407

RUNWAY 8-26 SIGN SCHEDULE

SIGN NUMBER	SIGN MESSAGE		TYPE L-858		CIRCUIT	SIZE	STYLE	ESTIMATED MODULES	SHEET NUMBER
	SIDE 1	SIDE 2	SIDE 1	SIDE 2					
R826S-23			Y	BLANK	R826S	3	5	2	E207 E407
R826S-24			L R	BLANK	R826S	3	5	3	E208 E408
R826S-25			BLANK	Y	R826S	3	5	2	E208 E408
R826S-26			L R	BLANK	R826S	3	5	3	E208 E408
R826S-27			Y	BLANK	R826S	3	5	2	E208 E408

TAXIWAY A SIGN SCHEDULE

SIGN NUMBER	SIGN MESSAGE		TYPE L-858		CIRCUIT	SIZE	STYLE	ESTIMATED MODULES	SHEET NUMBER
	SIDE 1	SIDE 2	SIDE 1	SIDE 2					
*			Y L	BLANK	TWA	3	5	2	E203 E403

* = COORDINATE WITH AIRPORT ON TW SIGN NUMBER

RUNWAY 8-26 RDR SIGN SCHEDULE

SIGN NUMBER	SIGN MESSAGE		TYPE L-858		CIRCUIT	SIZE	STYLE	ESTIMATED MODULES	SHEET NUMBER
	SIDE 1	SIDE 2	SIDE 1	SIDE 2					
R826S-28			B	B	R826S	4	5	1	E202 E402
R826S-29			B	B	R826S	4	5	1	E203 E403
R826S-30			B	B	R826S	4	5	1	E204 E404
R826S-31			B	B	R826S	4	5	1	E205 E405
R826S-32			B	B	R826S	4	5	1	E206 E406



SAH	4/25	ADDENDUM	3	NO.	DATE	REVISION	BY

SIGN SCHEDULE
(SHEET 2 OF 2)


ISSUED FOR BID DRAWINGS

RUNWAY 8-26
REHABILITATION

PREPARED FOR
PENSACOLA INTERNATIONAL AIRPORT

DESIGNED BY: SAH
DRAWN BY: KJF
CHECKED BY: MAG
APPROVED BY: VCL
PROJECT NO: 24.0359.01
DATE: MARCH 28, 2025

SHEET NUMBER
E513

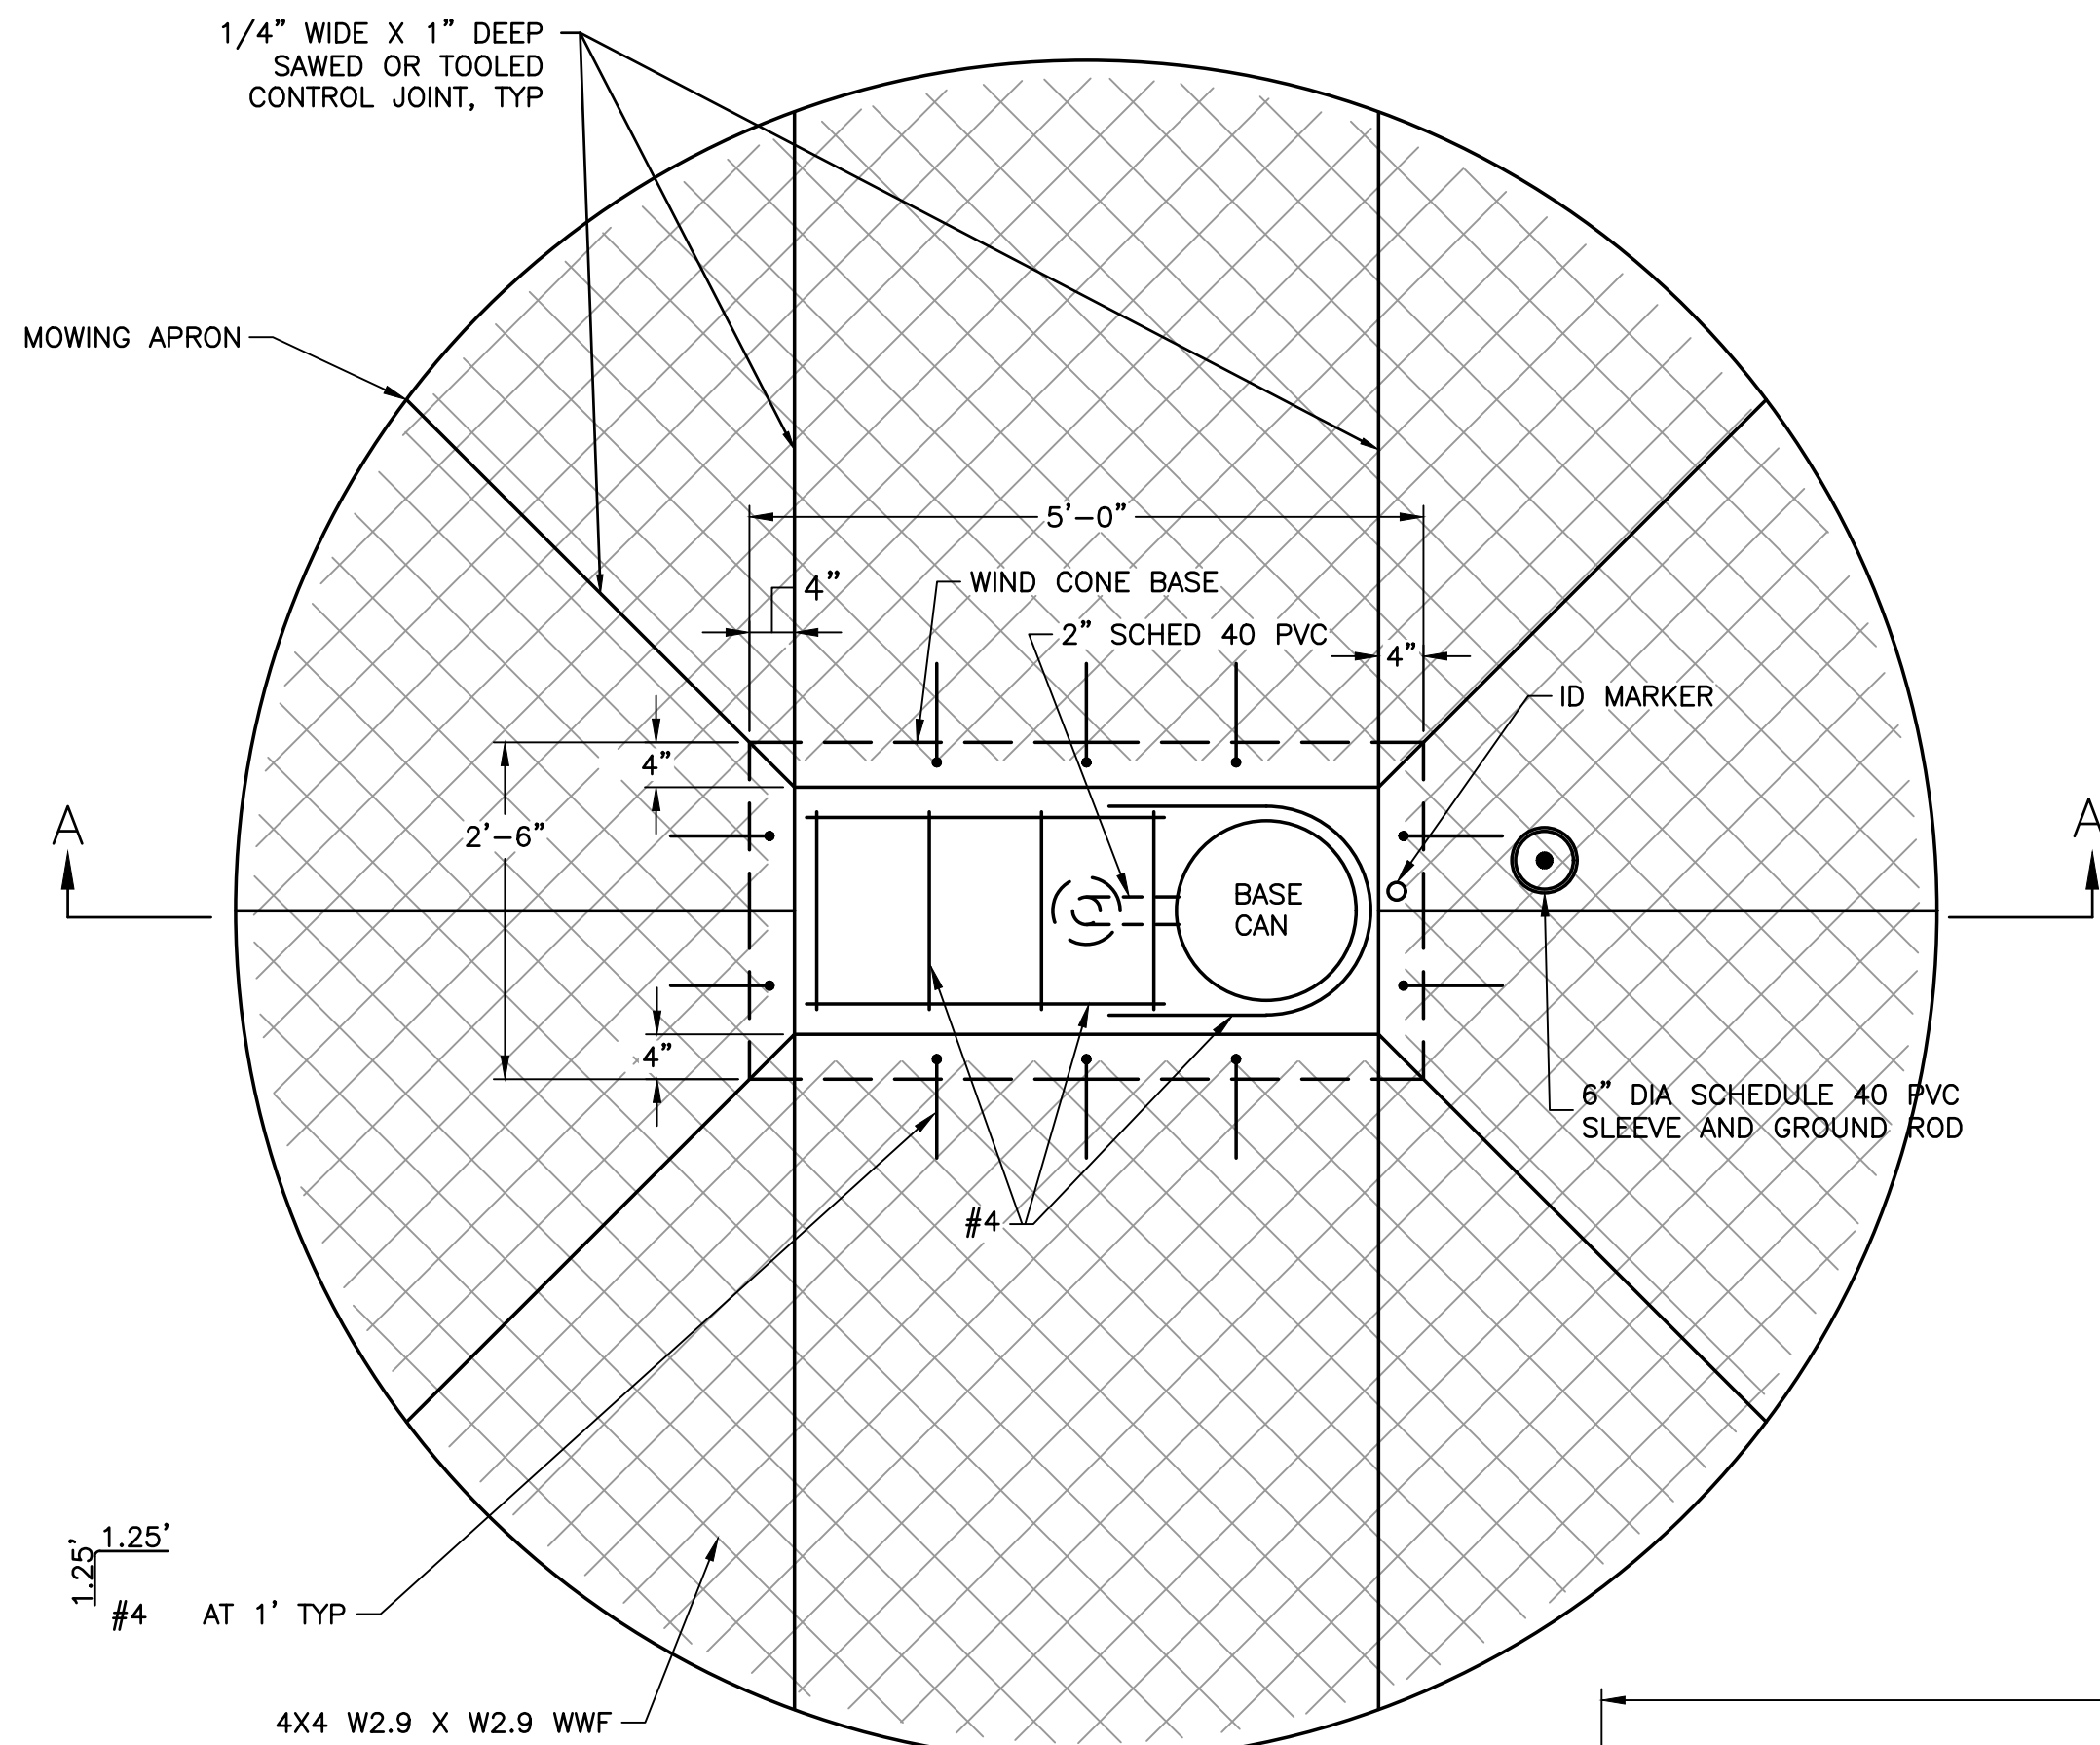

WIND CONE BASE PLAN


N.T.S.

WIND CONE NOTES:

1. ALL THREADED CONNECTIONS SHALL BE COATED WITH "NEVER-SIEZE" COMPOUND OR ACCEPTED EQUIVALENT PRIOR TO ASSEMBLY.
2. PROVIDE APPURTENANCES REQUIRED IN FRANGIBLE COUPLINGS OF WIND CONES TO DISCONNECT WIND CONES FROM POWER SOURCE SHOULD WIND CONE FRANGIBLE COUPLING BE BROKEN.
3. WIND CONE SHALL BE A STYLE 1B (INTERNALLY LIGHTED). WIND CONE SHALL COMPLY WITH AC 150/5345-27 CURRENT EDITION. WIND CONE SHALL BE LISTED AS APPROVED AIRPORT LIGHTING EQUIPMENT IN AC 150/5345-53 APPENDIX 3 CURRENT EDITION.

GROUNDING/BONDING NOTES:

1. BOND ALL METALLIC RACEWAYS AND ENCLOSURES WITH A #2 AWG COPPER EQUIPMENT GROUNDING CONDUCTOR IN ACCORDANCE WITH THE NEC.
2. ALL CONNECTIONS OF CONDUCTORS TO GROUND RODS SHALL BE MADE BY THE EXOTHERMIC METHOD OR ACCEPTED EQUIVALENT.
3. ALL GROUND RODS SHALL HAVE AN EARTH TO GROUND RESISTANCE OF 25 OHMS OR LESS.

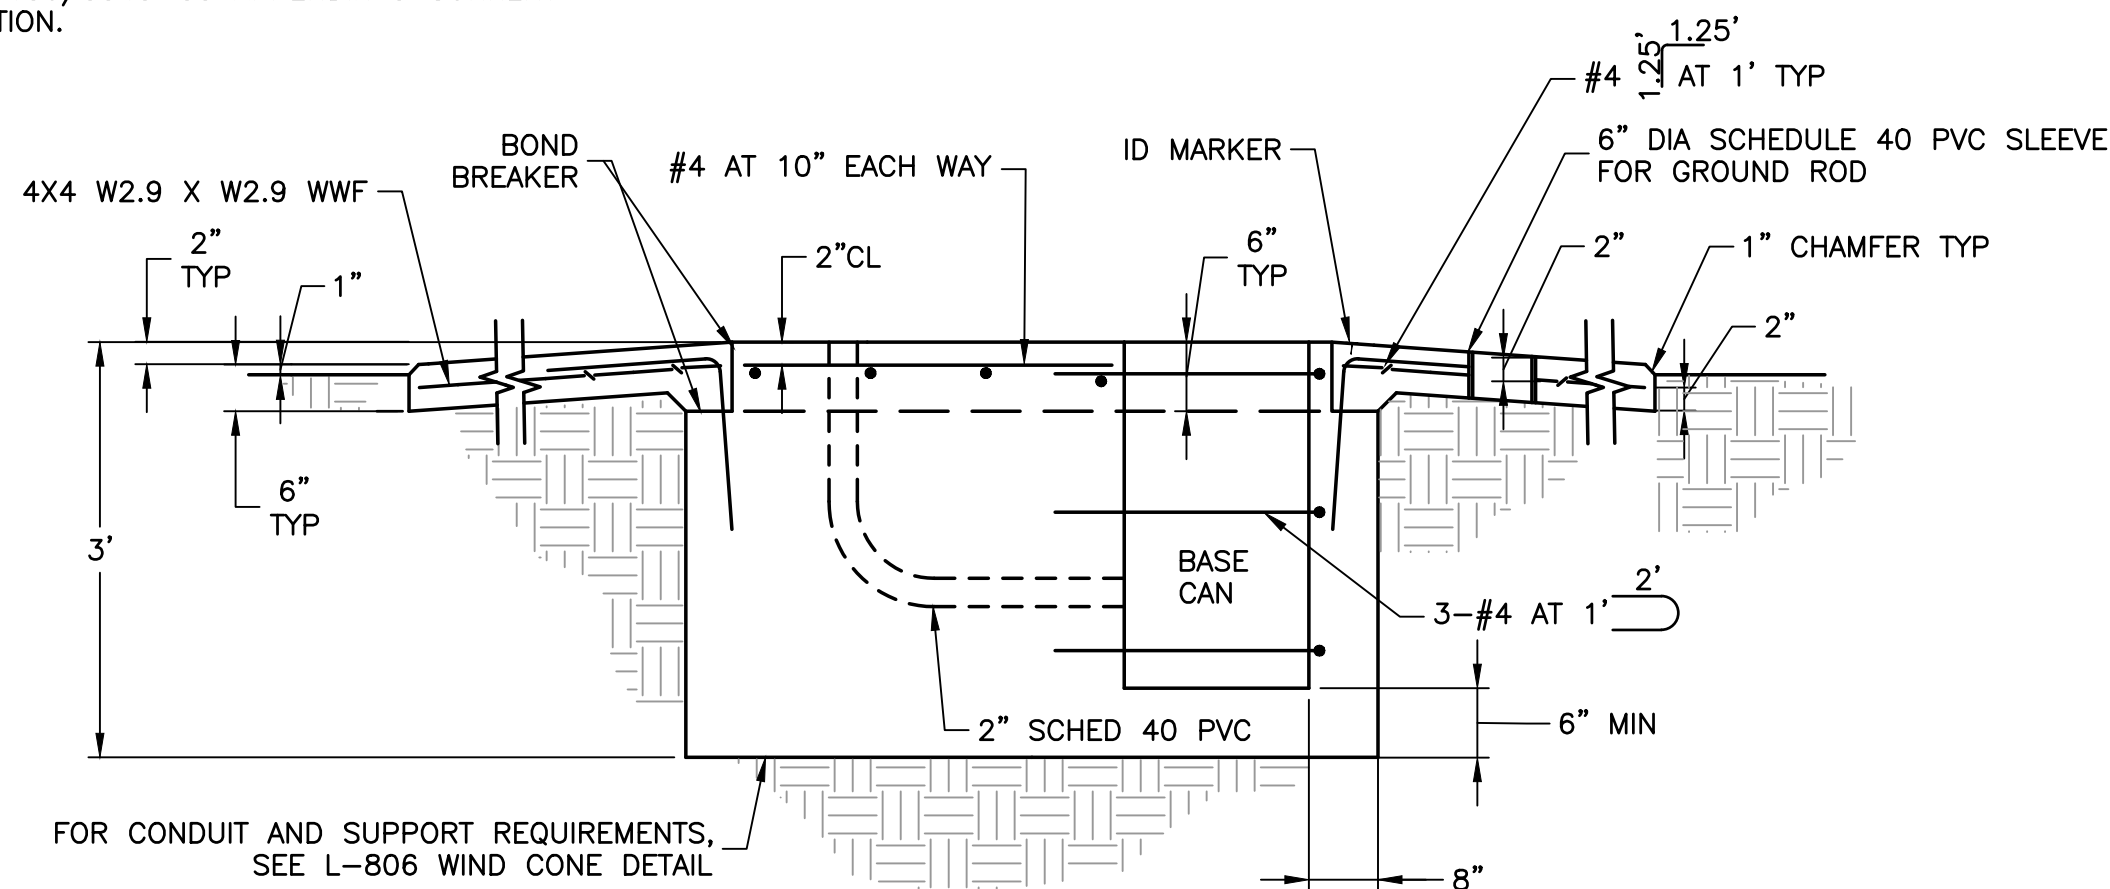

WIND CONE FOUNDATION DETAIL

SECTION A-A


N.T.S.

RACK NOTES:

1. FOR POST, USE MIN. 4000 P.S.I. CONCRETE REINFORCED WITH FOUR (4) #4 REBAR PLACED IN A 6" X 6" SQUARE CENTERED IN THE POST. ALL OTHER CONCRETE, UNO, SHALL COMPLY WITH POLE FOUNDATION MIX REQUIREMENTS.
2. ALL EDGES TO HAVE A 1/2" CHAMFER.
3. TOP HOLE WILL BE 9/16" CAST OR DRILLED THROUGH POST 4" FROM END.
4. MOUNT P-1000 SS CHANNEL USING 1/2" SS BOLTING HARDWARE THROUGH POST. DO NOT USE POWER GUN TO SHOOT FASTENERS INTO POST. DO NOT USE PLASTIC ANCHORS. ALL ATTACHMENTS TO CONCRETE POST SHALL BOLT THROUGH POST IN A DRILLED OR CAST HOLE. ALL MOUNTING HARDWARE SHALL BE STAINLESS STEEL.
5. DIMENSION TO MATCH MOUNTING HOLES IN ELECTRICAL EQUIPMENT.
6. ALL POWER AND CONTROL WIRING SHALL BE NEATLY LACED AND SECURED IN POSITION.
7. USE WEATHER PROOF CONDUIT HUBS ON ALL EXTERIOR DAMP AND WET LOCATIONS. SEALING LOCKNUTS ARE SPECIFICALLY PROHIBITED.
8. USE RIGID GALVANIZED STEEL CONDUIT FOR ALL EXPOSED WORK, UNLESS SPECIFICALLY NOTED OTHERWISE.
9. EQUIPMENT MUST NOT EXTEND PAST INSIDE FACE OF CONCRETE POST.


DISCONNECT KEY NOTES:

- 1 480V, 60A, FUSED HEAVY DUTY
SAFETY SWITCH, NEMA 4X.
- 2 PHENOLIC NAMEPLATE 1/4"
LETTERING TYP. FOR ALL
NAMEPLATES. SEE NOTE 11 ON
THIS SHEET. TYP.

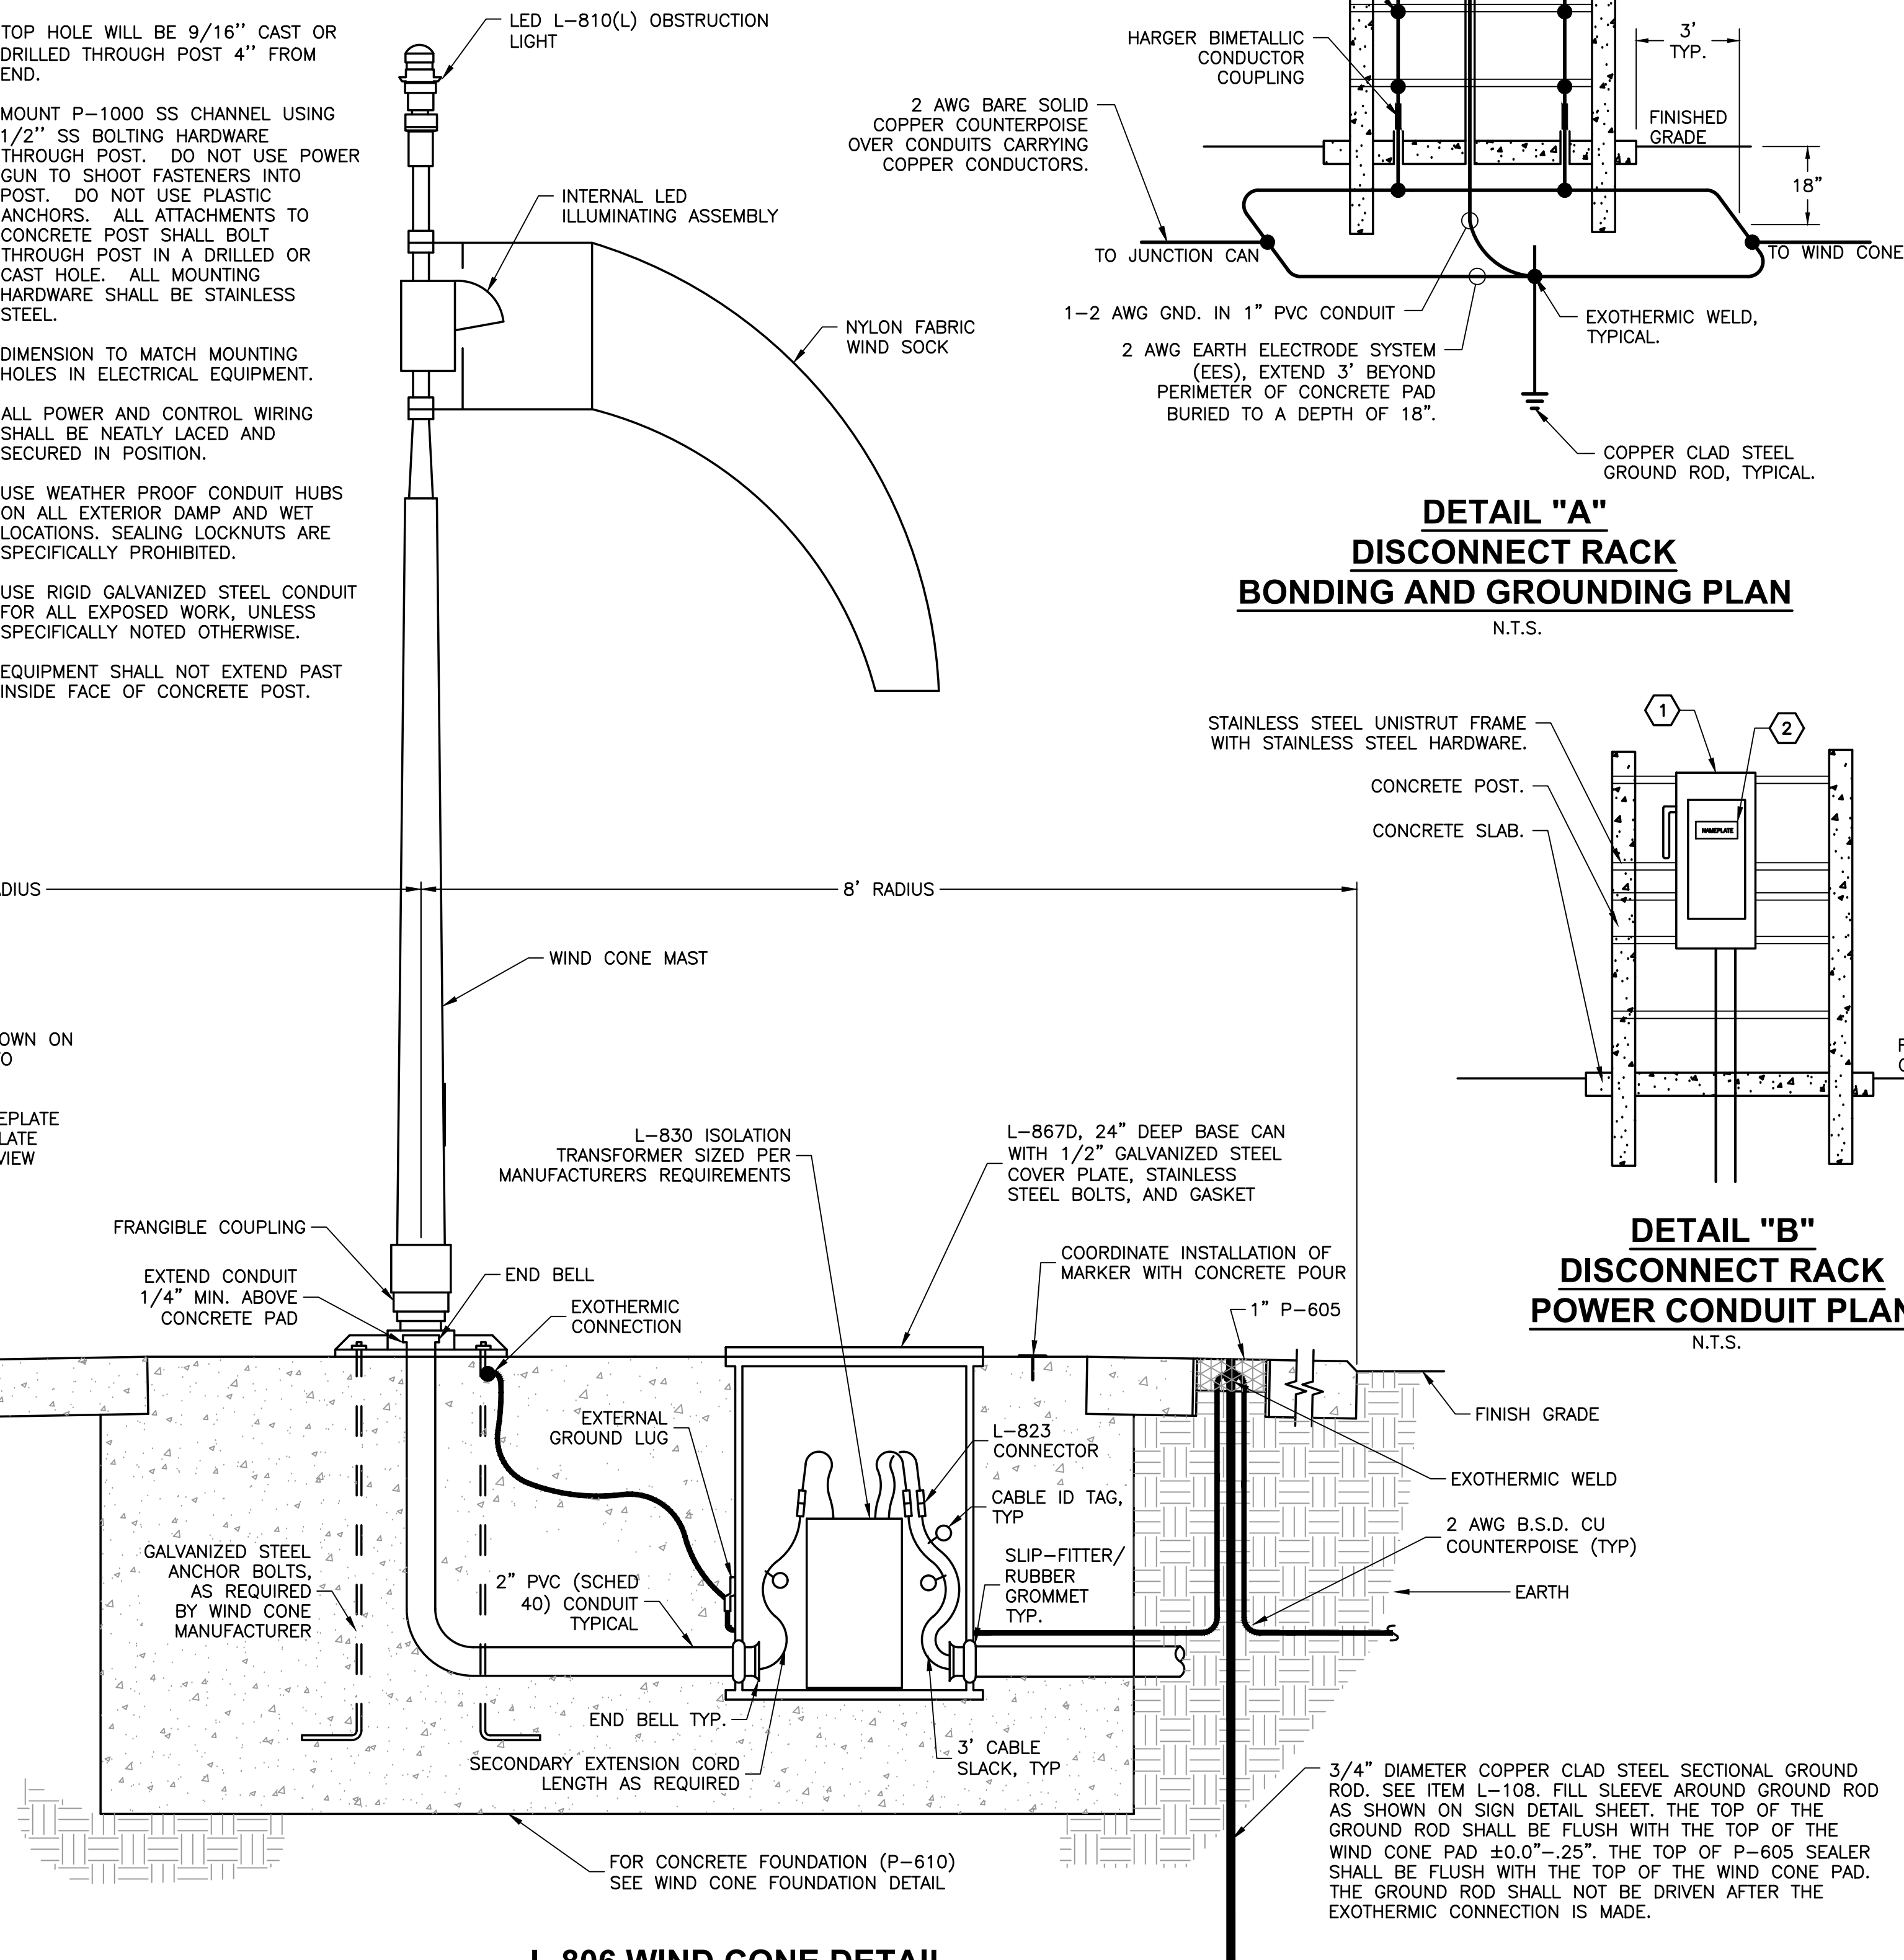


L-806 WIND CONE DETAIL

N.T.S

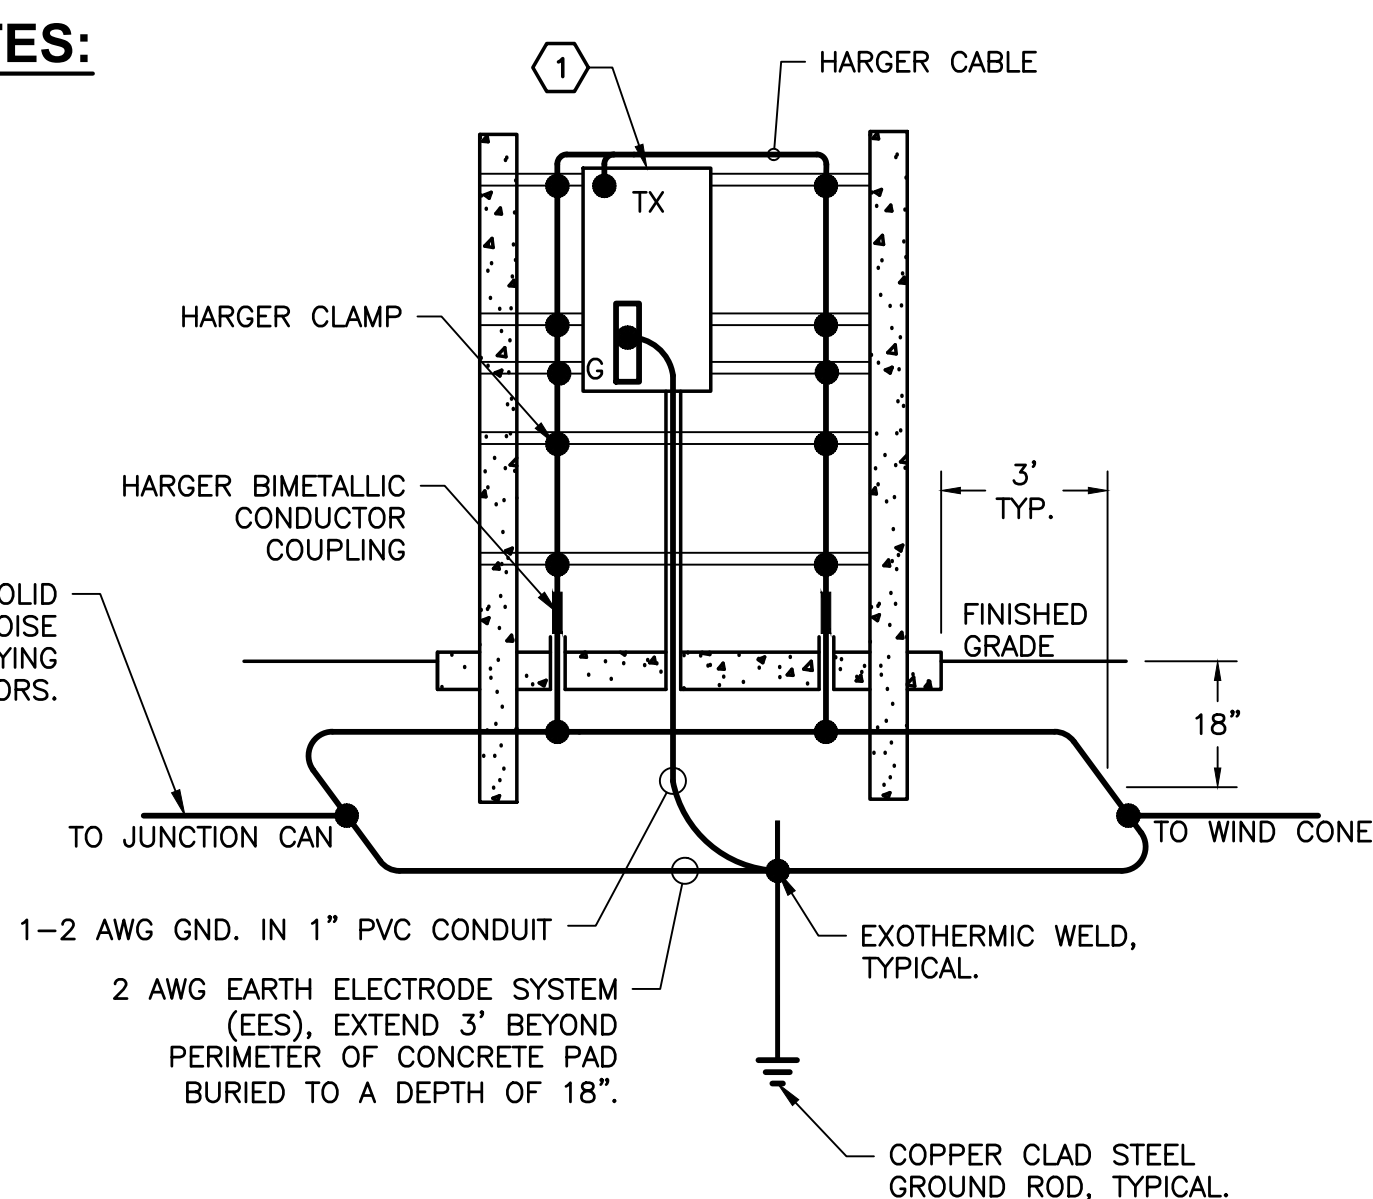

DETAIL "A"
DISCONNECT RACK
BONDING AND GROUNDING PLAN

N.T.S.

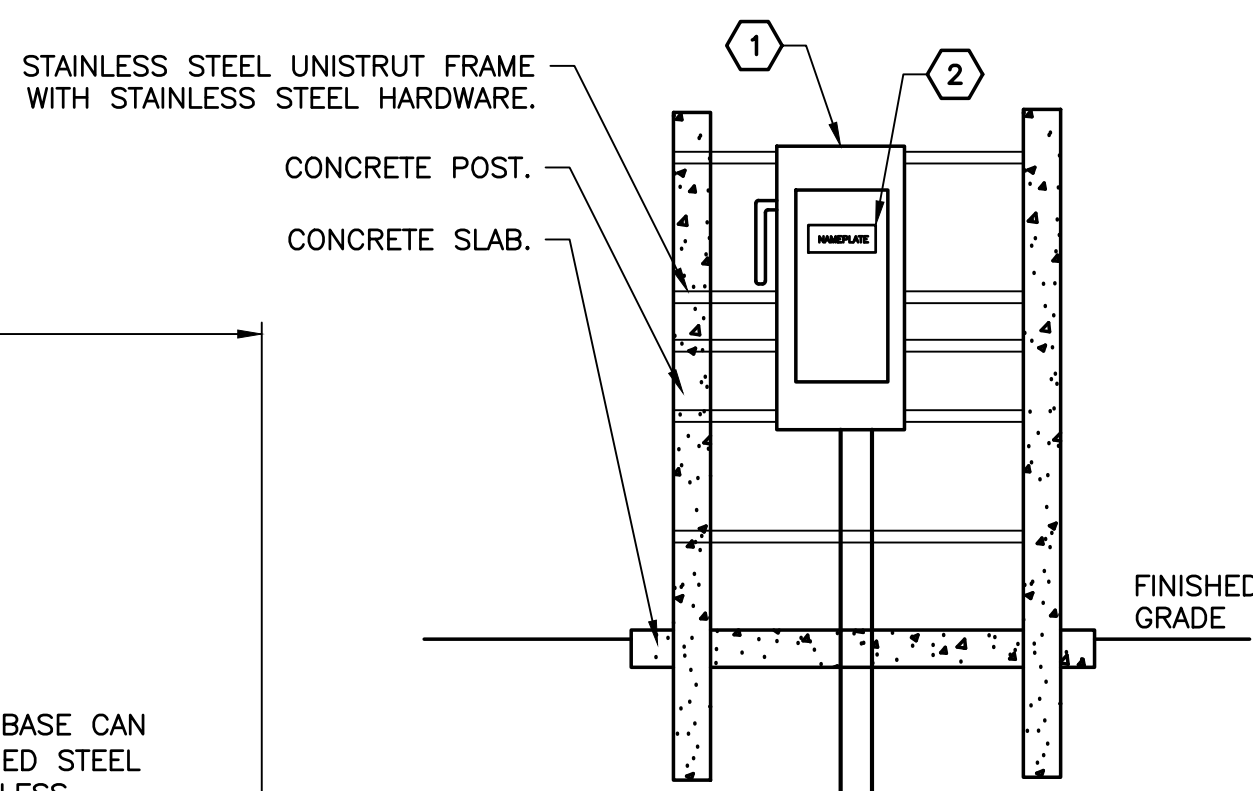

DETAIL "B"
DISCONNECT RACK
POWER CONDUIT PLAN

N.T.S.

TRANSFORMING TODAY'S IDEAS
INTO TOMORROW'S REALITY

AVCON, INC.
ENGINEERS & PLANNERS

3239 SUMMIT BLVD., SUITE 26
PENSACOLA, FL 32503
OFFICE: (850) 698-3526
CORPORATE CERTIFICATE OF
AUTHORIZATION NUMBER: 5057
www.avconinc.com

N:\MIDDLE - C&P\0505-0505\VFCS Avcon 0505 .pmc-jpg

[illegible]

WINDCONE DETAILS

RUNWAY 8-26 REHABILITATION





PREPARED FOR

PENSACOLA INTERNATIONAL AIRPORT

DESIGNED BY: SAH
DRAWN BY: KJR
CHECKED BY: MAG
APPROVED BY: VCL
PROJECT NO: 24.0359.01
DATE: MARCH 28, 2025

SHEET NUMBER

E518

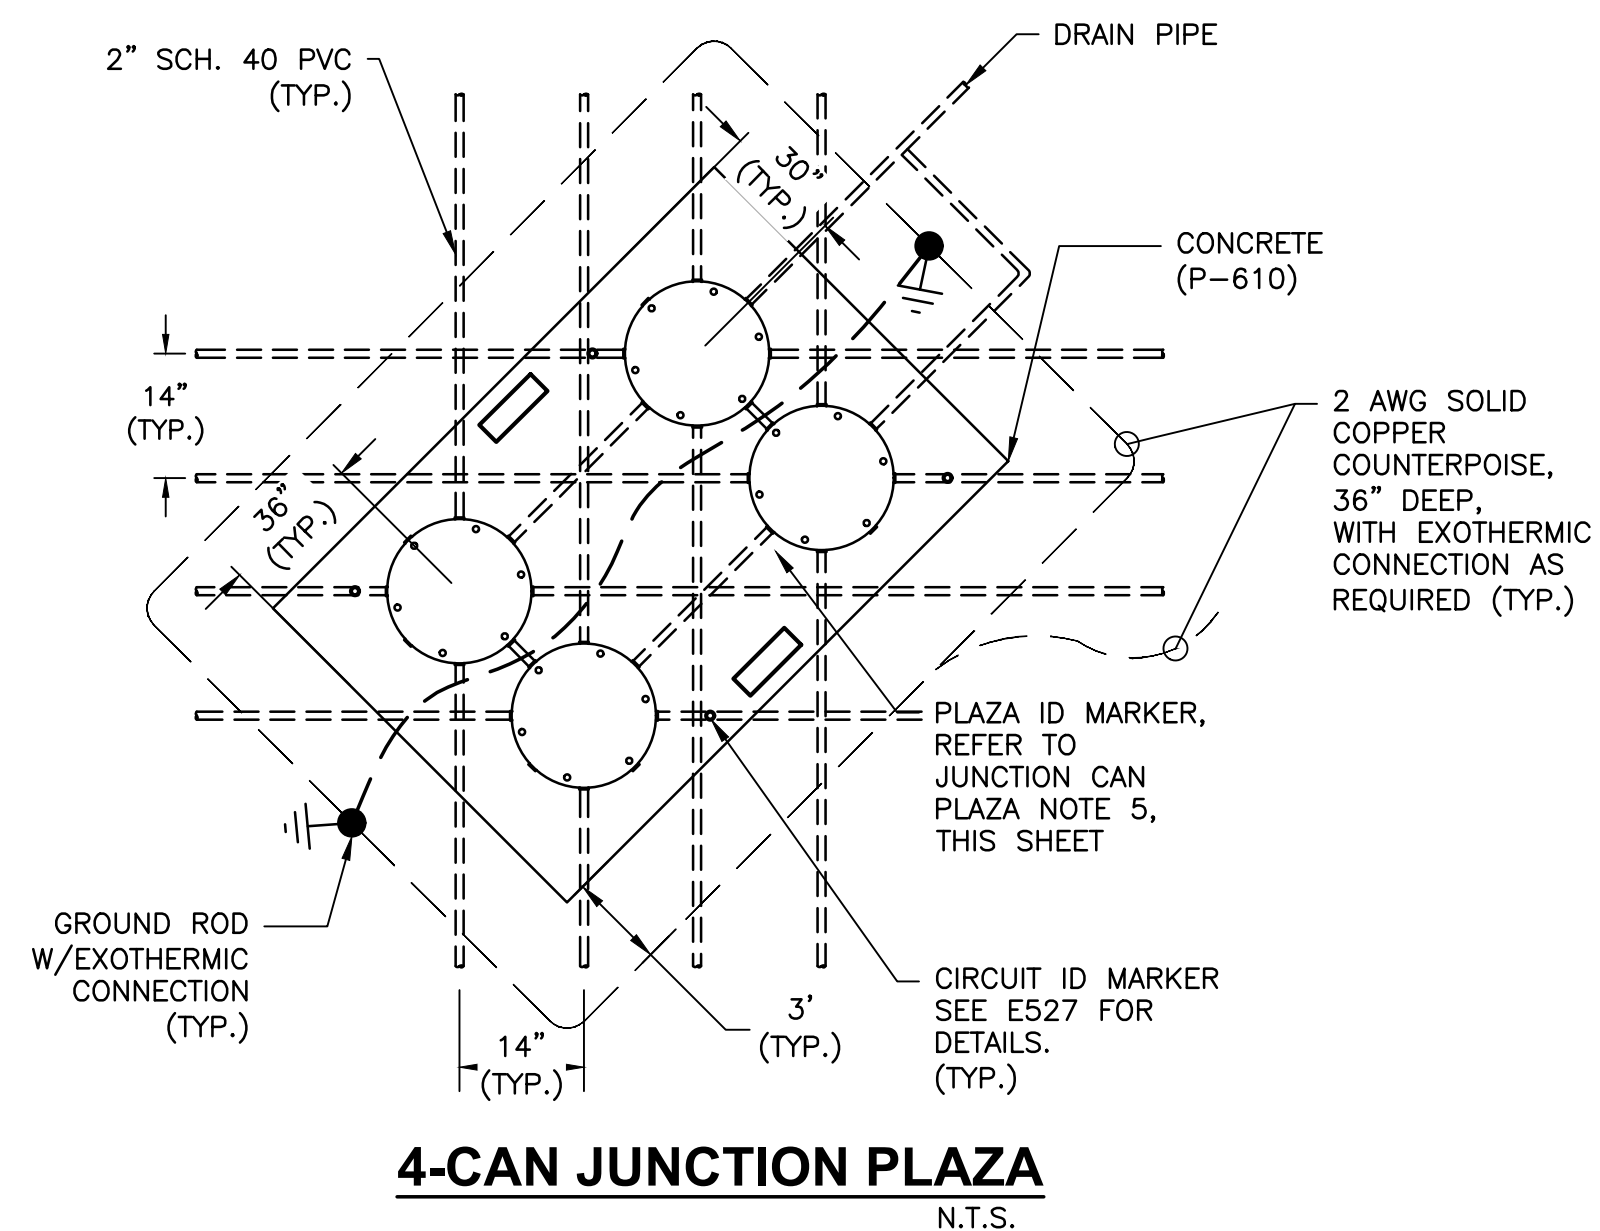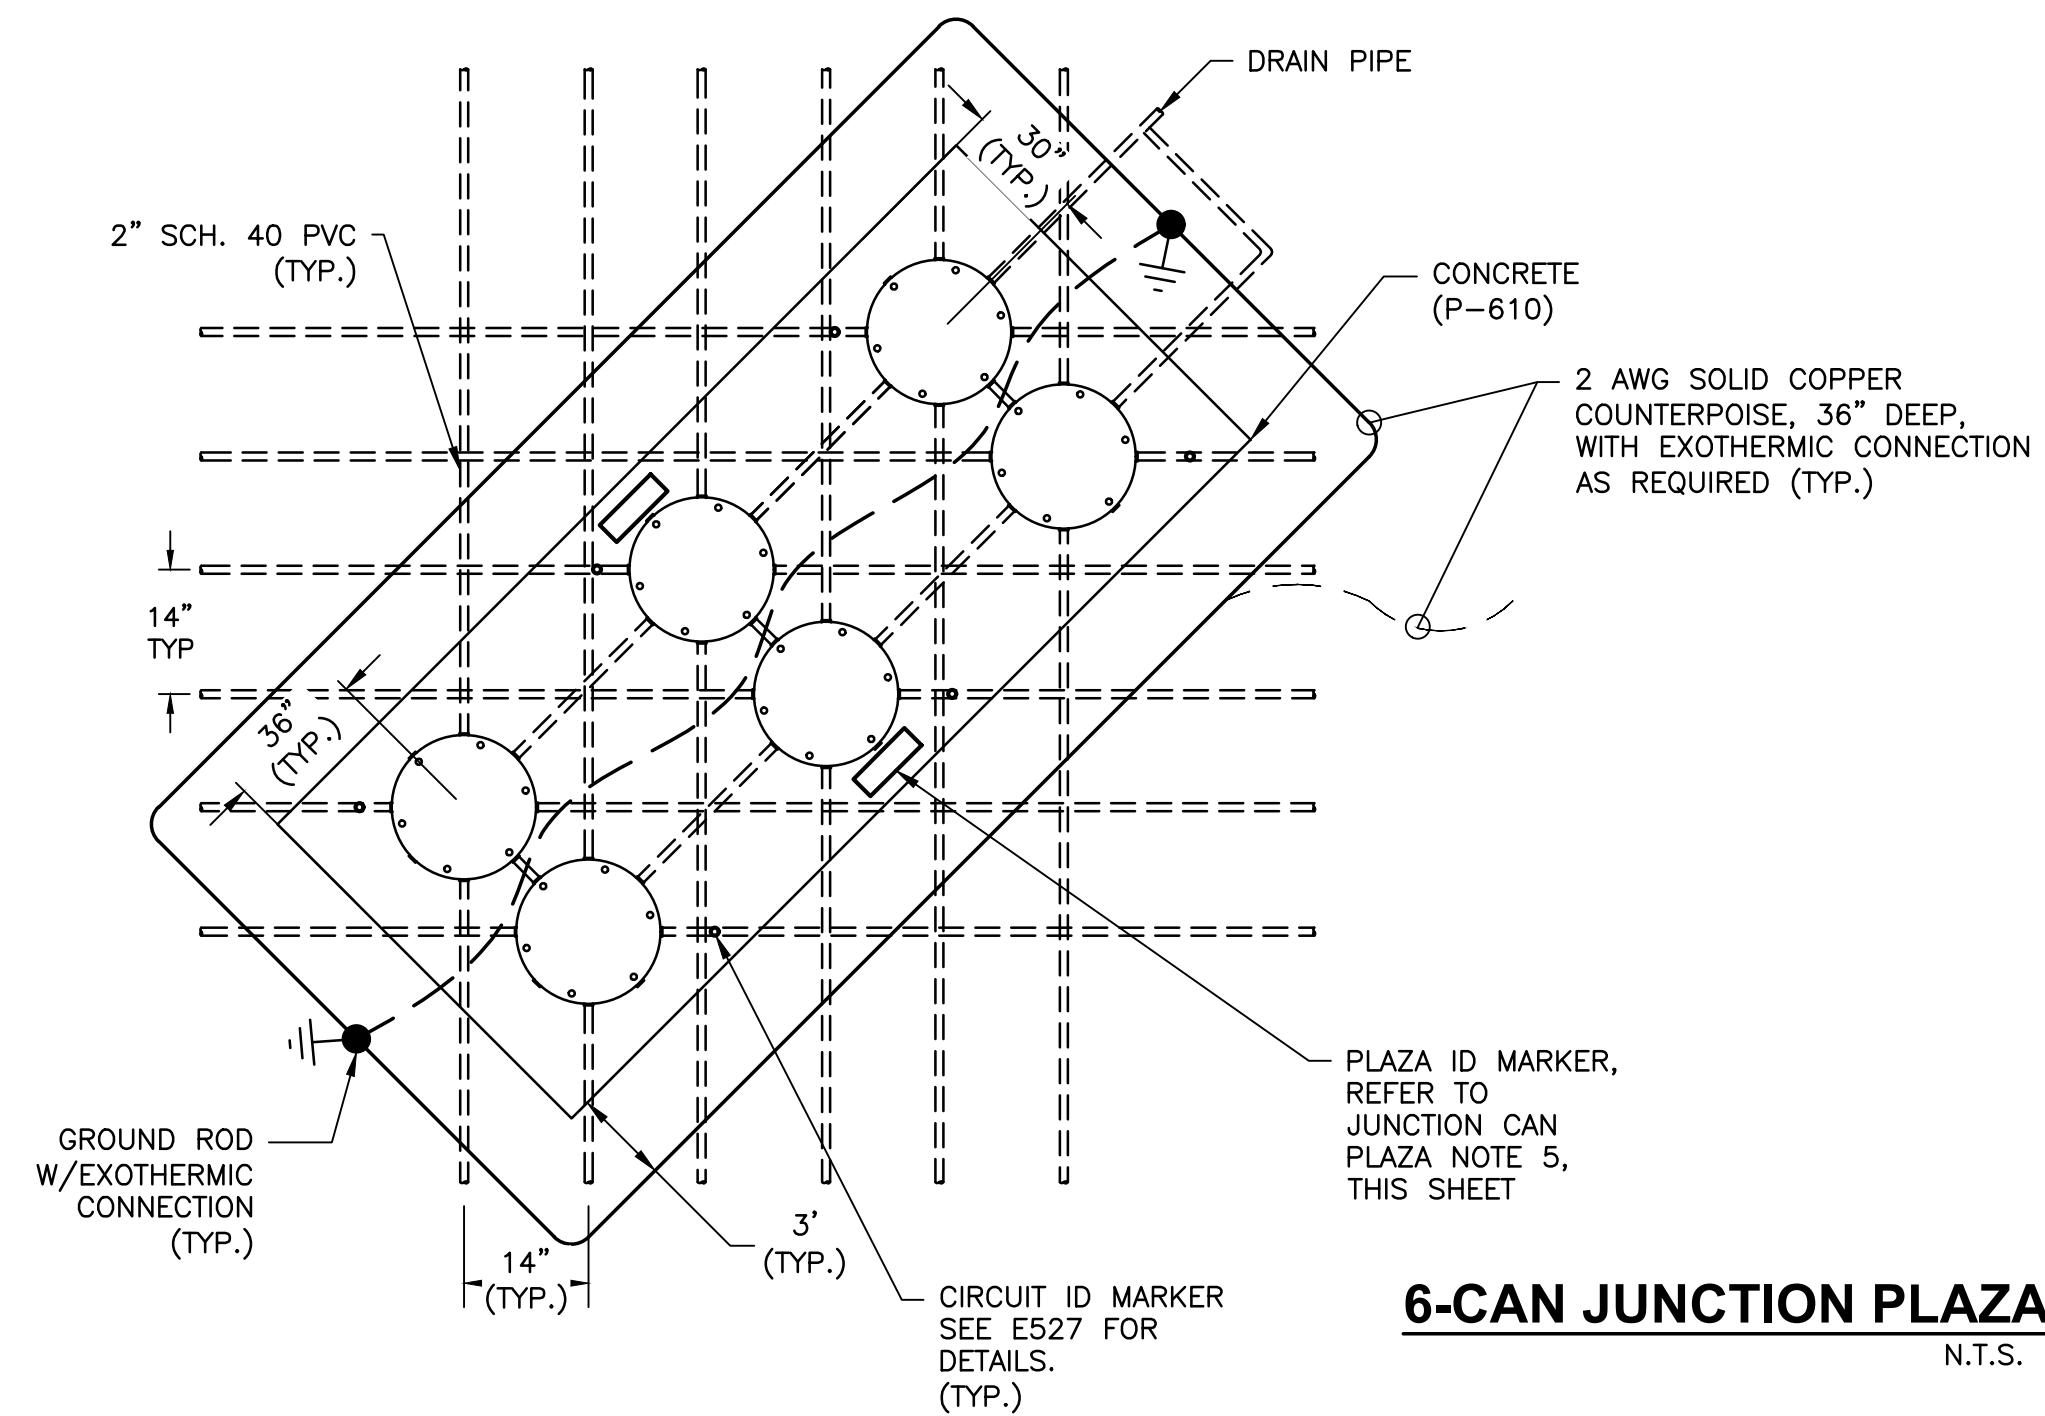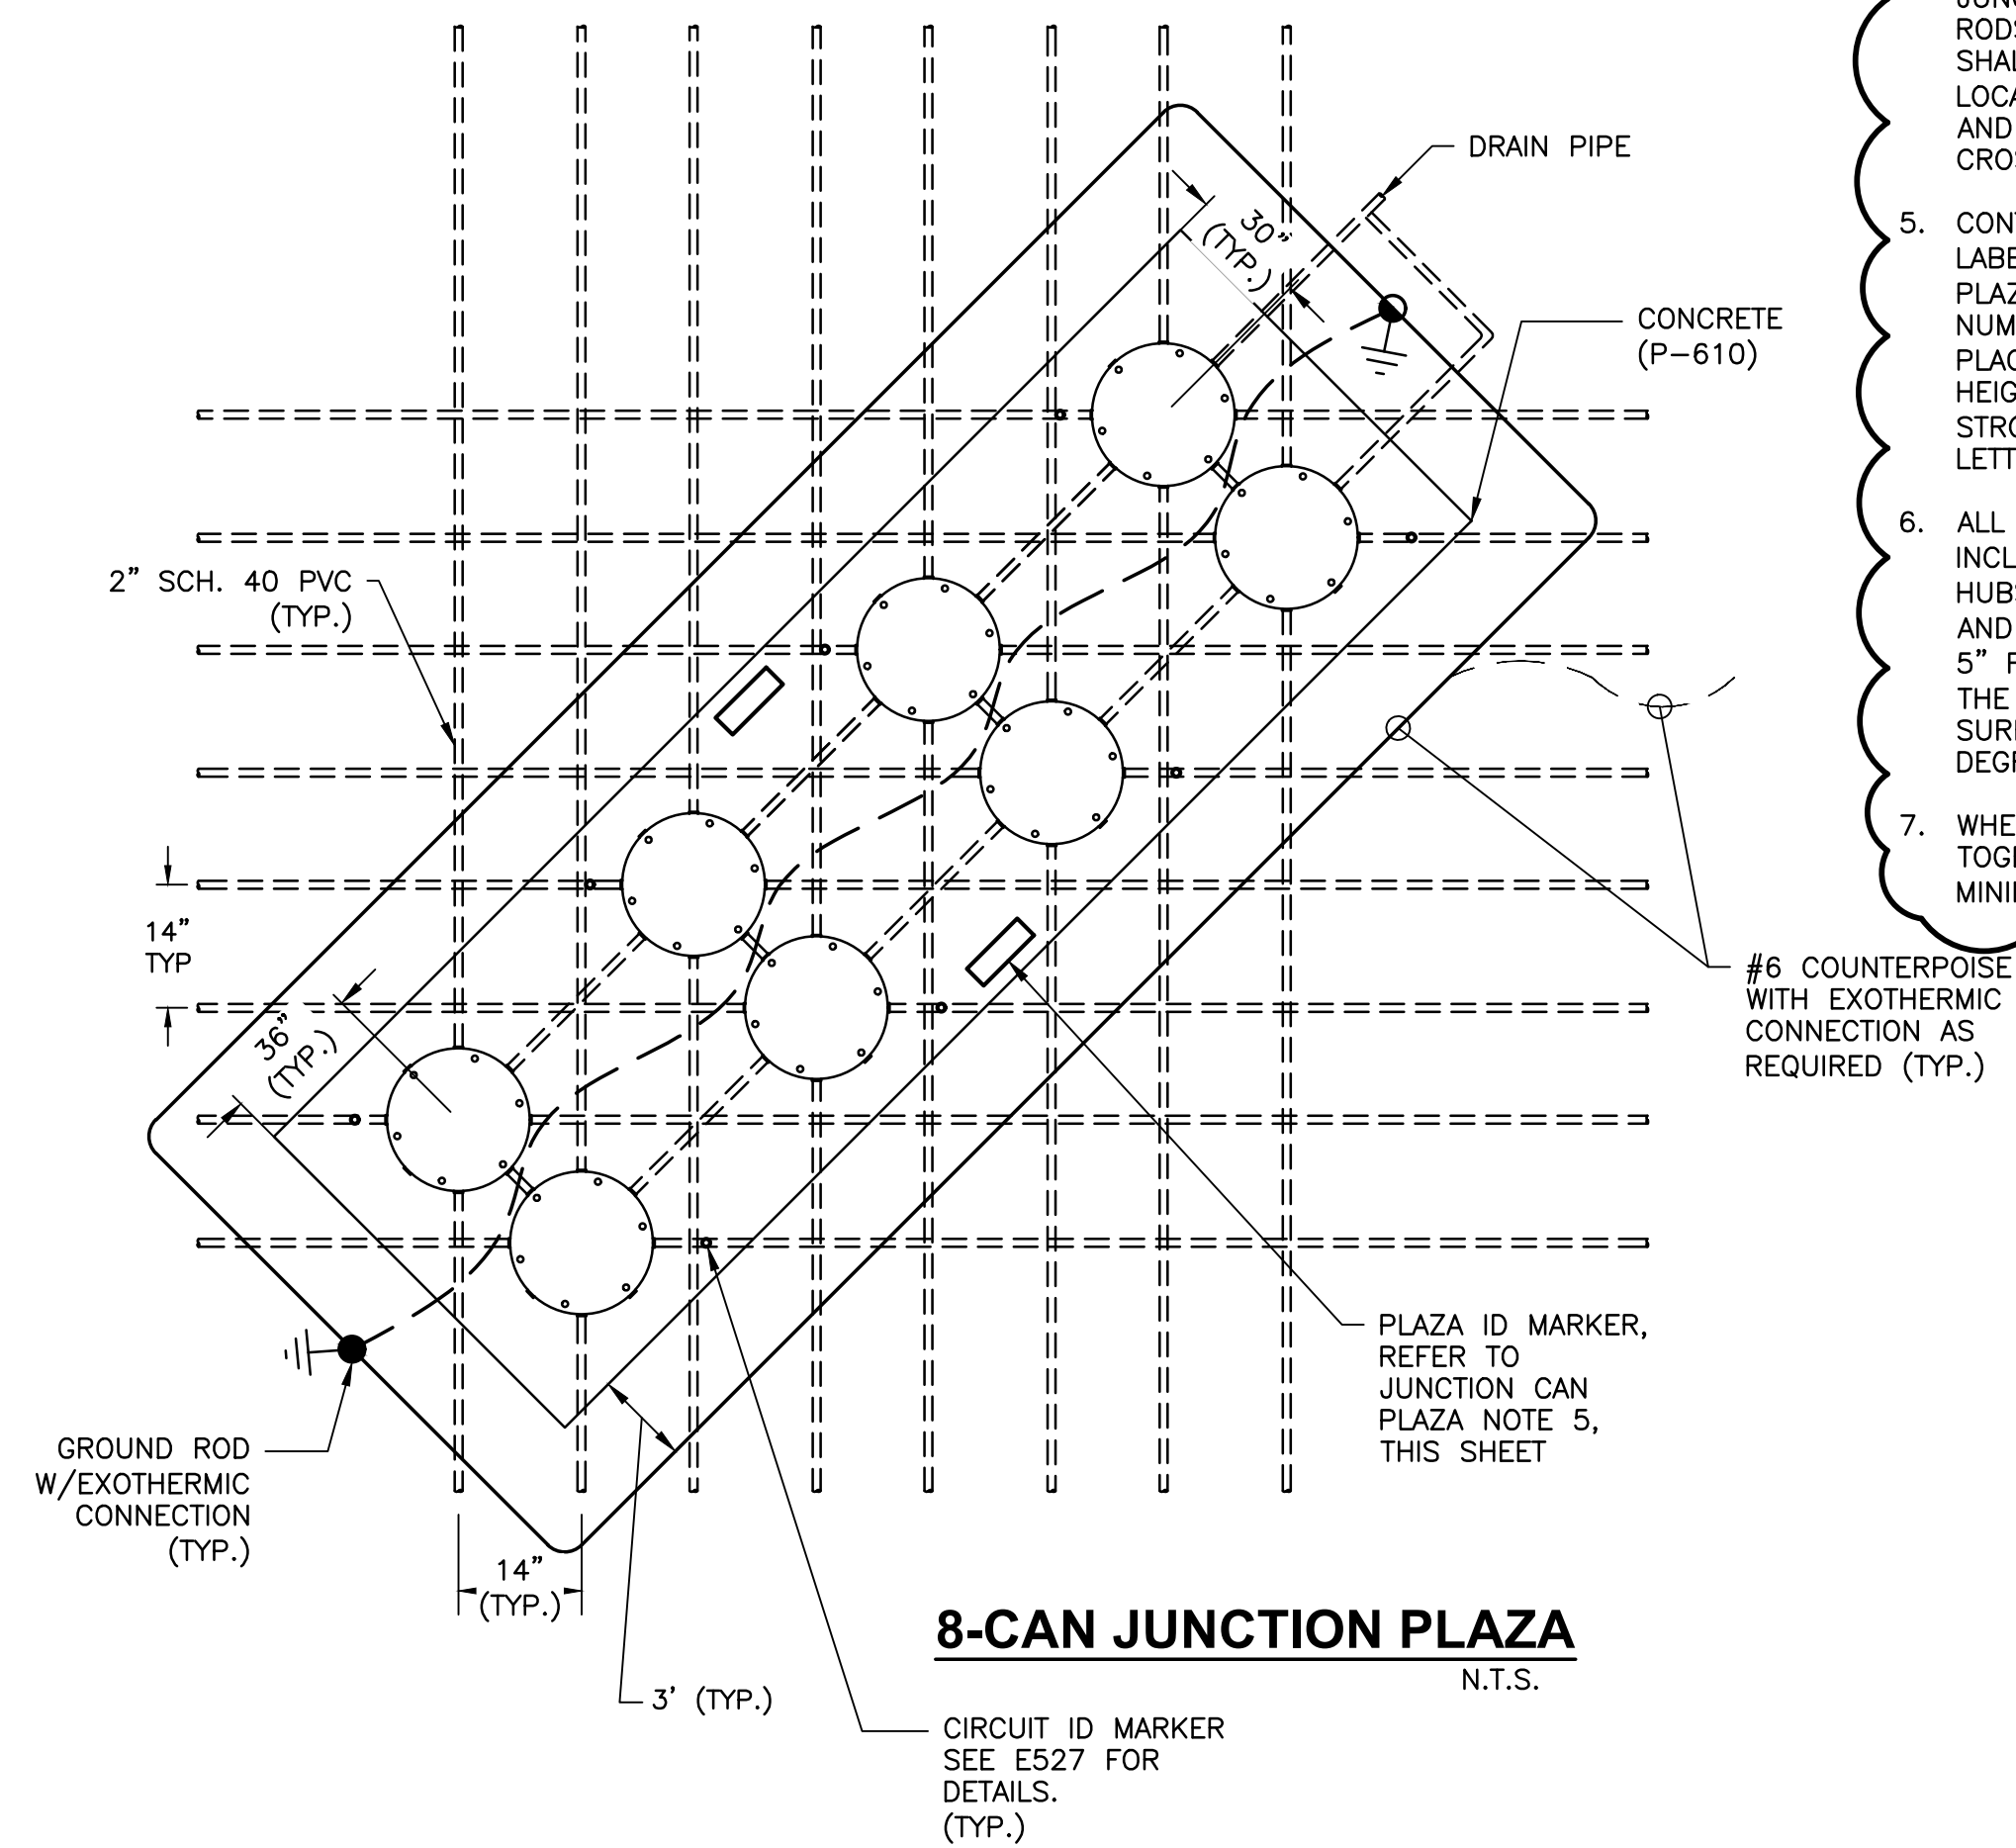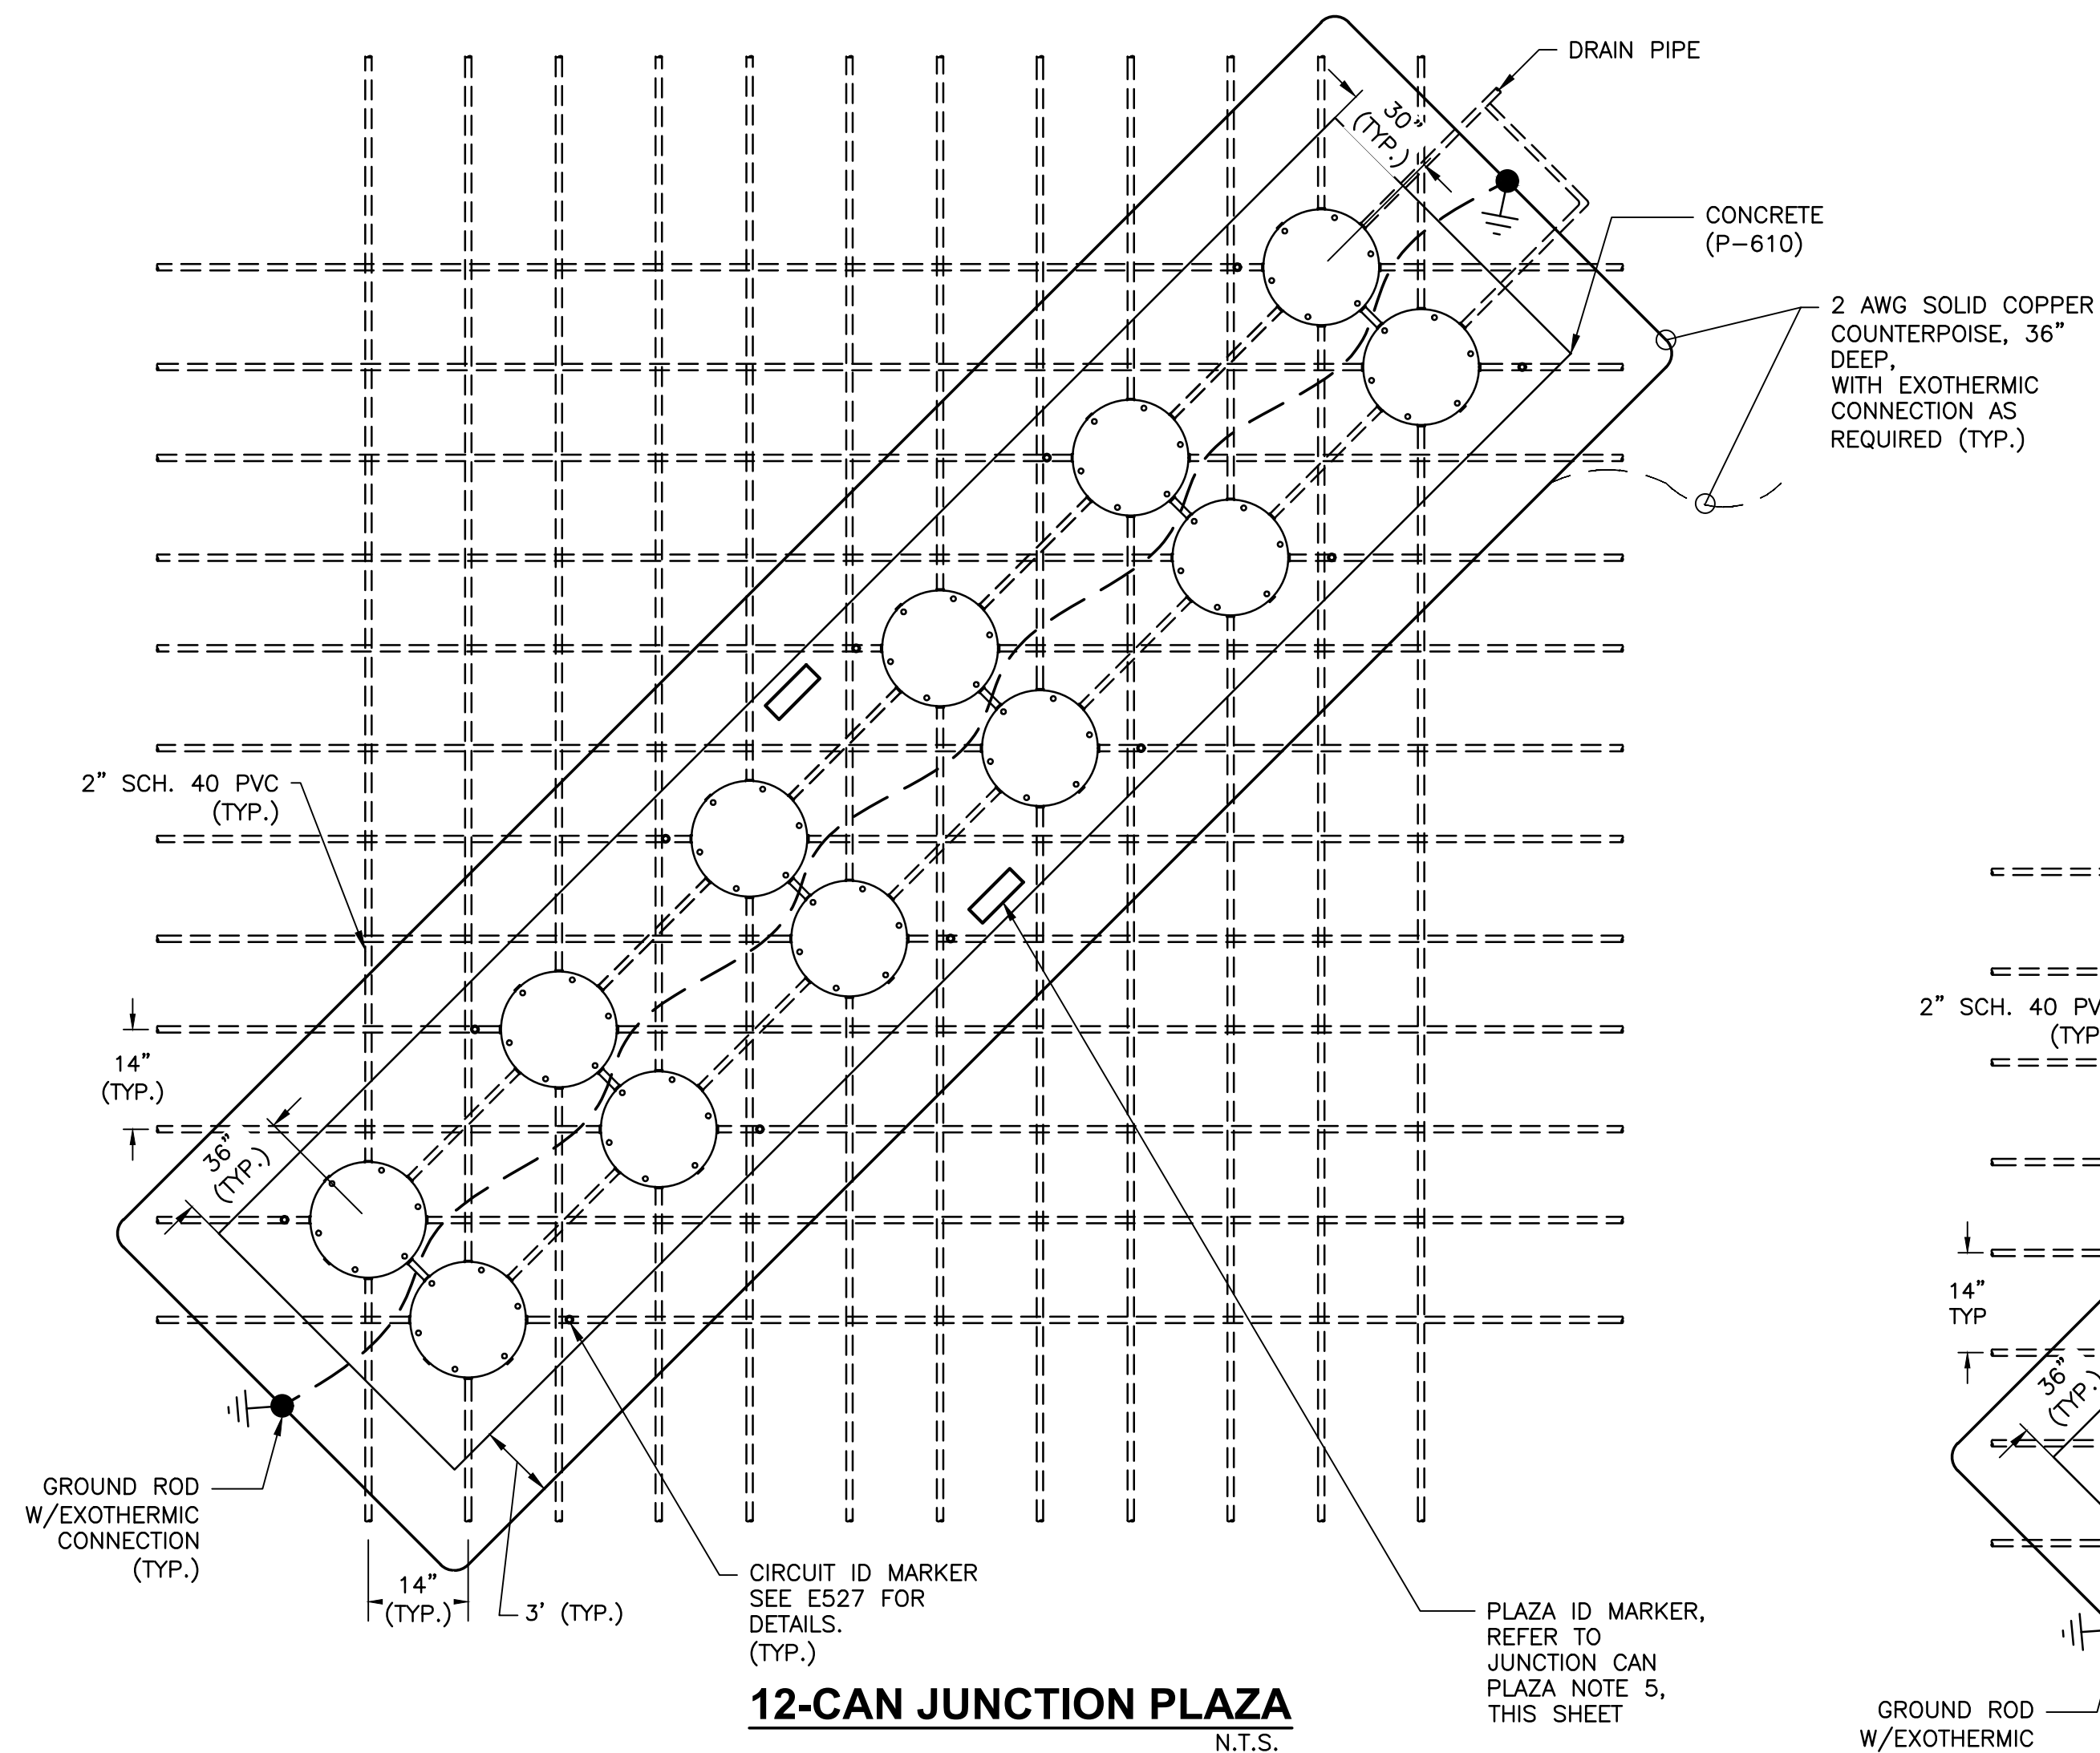

JUNCTION CAN PLAZA NOTES:

1. CONDUITS WHICH ARE NOT USED IN THE PROJECT SHALL BE SAND ENCASED AND CAPPED 12" OUTSIDE OF PLAZA CONCRETE STRUCTURE.
2. ORIENT PLAZA PARALLEL TO ADJACENT RW OR TW PAVEMENT UNLESS OTHERWISE NOTED. DIAGRAMMATIC ROTATION IS INDICATED ON PLANS.
3. CONTRACTOR SHALL PROVIDE A CIRCUIT ID MARKER AT EACH JUNCTION CAN'S FOUR DIRECTIONS AS SHOWN. MARKER SHALL BE STAMPED WITH UNIQUE IDENTIFIER AND ASSOCIATED CIRCUIT IDENTIFICATION AS INSTALLED BY THE CONTRACTOR. UNUSED RACEWAYS SHOULD BE INSTALLED WITH MARKER BUT NOT STAMPED.
4. INSTALL GROUND RODS AND GROUND LOOP AT ALL JUNCTION CAN PLAZAS AS SHOWN. TWO GROUND RODS PER PLAZA LOCATED AT OPPOSITE CORNERS SHALL BE PROVIDED. JCP COUNTERPOISE SHALL BE LOCATED NOMINALLY 12" BELOW EXISTING GRADE AND BONDED TO RACEWAY COUNTERPOISE AT EACH CROSSING.
5. CONTRACTOR SHALL INSTALL PLAZA IDENTIFICATION LABEL AT TWO (2) ENDS OF EACH JUNCTION CAN PLAZA (JCP) BY IMPRESSING THE JCP IDENTIFICATION NUMBER INTO THE CONCRETE FOUNDATION DURING PLACEMENT. LETTERS AND NUMBERS SHALL BE 4" IN HEIGHT, PROPORTIONAL IN WIDTH, AND HAVE A STROKE WIDTH OF 1/2" AND 1/4" DEPTH. HAND LETTERING IS NOT PERMITTED.
6. ALL JUNCTION CANS ARE L-867 TYPE D AND INCLUDE THREE (3) LAYERS OF HUBS. THE LOWER HUBS (2) ARE AT 2.5" FROM THE BOTTOM AT 0 AND 180 DEGREES. THE MIDDLE HUBS (2) ARE AT 5" FROM THE BOTTOM AT 90 AND 270 DEGREES. THE UPPER HUBS (4) ARE AT 6" FROM THE TOP SURFACE BOTTOM AT 45, 135, 225, AND 315 DEGREES.
7. WHERE MULTIPLE JUNCTION CAN PLAZAS ARE TIED TOGETHER FOR DRAINAGE, INCREASE DRAIN LINE TO MINIMUM 3" DRAIN PIPE.

[illegible]

**JUNCTION CAN
PLAZA DETAILS
(SHEET 2 OF 3)**

RUNWAY 8-26 REHABILITATION

PREPARED FOR
PENSACOLA INTERNATIONAL AIRPORT

DESIGNED BY: SAH
DRAWN BY: KJR
CHECKED BY: MAG
APPROVED BY: VCL
PROJECT NO: 24.0359.01
DATE: MARCH 28, 2025

SHEET NUMBER
E521

AVCON, INC.
ENGINEERS & PLANNERS


3298 SUMMIT BLVD., SUITE 26
PENSACOLA, FL 32503
OFFICE: (850) 698-3526
CORPORATE CERTIFICATE OF
AUTHORIZATION NUMBER: 5057
www.avconinc.com

**TRANSFORMING TODAY'S IDEAS
INTO TOMORROW'S REALITY**

N:\NICEVILLE\CAD\002 | NCOS\IBFC\Nicos | NCN nicos.jpg

THIS DOCUMENT CONTAINS PRIVILEGED AND PROPRIETARY INFORMATION, ALL OF WHICH IS EXPRESSLY PROVIDED BY AVCON, INC. FOR USE BY THE INTENDED RECIPIENT, AND FOR A SPECIFIC PURPOSE. WITHOUT THE EXPRESS WRITTEN CONSENT OF AVCON, INC. ANY DISTRIBUTION, REPRODUCTION, OR OTHER USE OF THIS DOCUMENT, IN WHOLE OR IN PART, IS STRICTLY PROHIBITED.

N:\359 CITY OF PENSACOLA-AIRPORT\2024-0359.01-PNS RUNWAY 8-26\000 CAD\24035901_E522.DWG 4/11/2025 9:16 AM

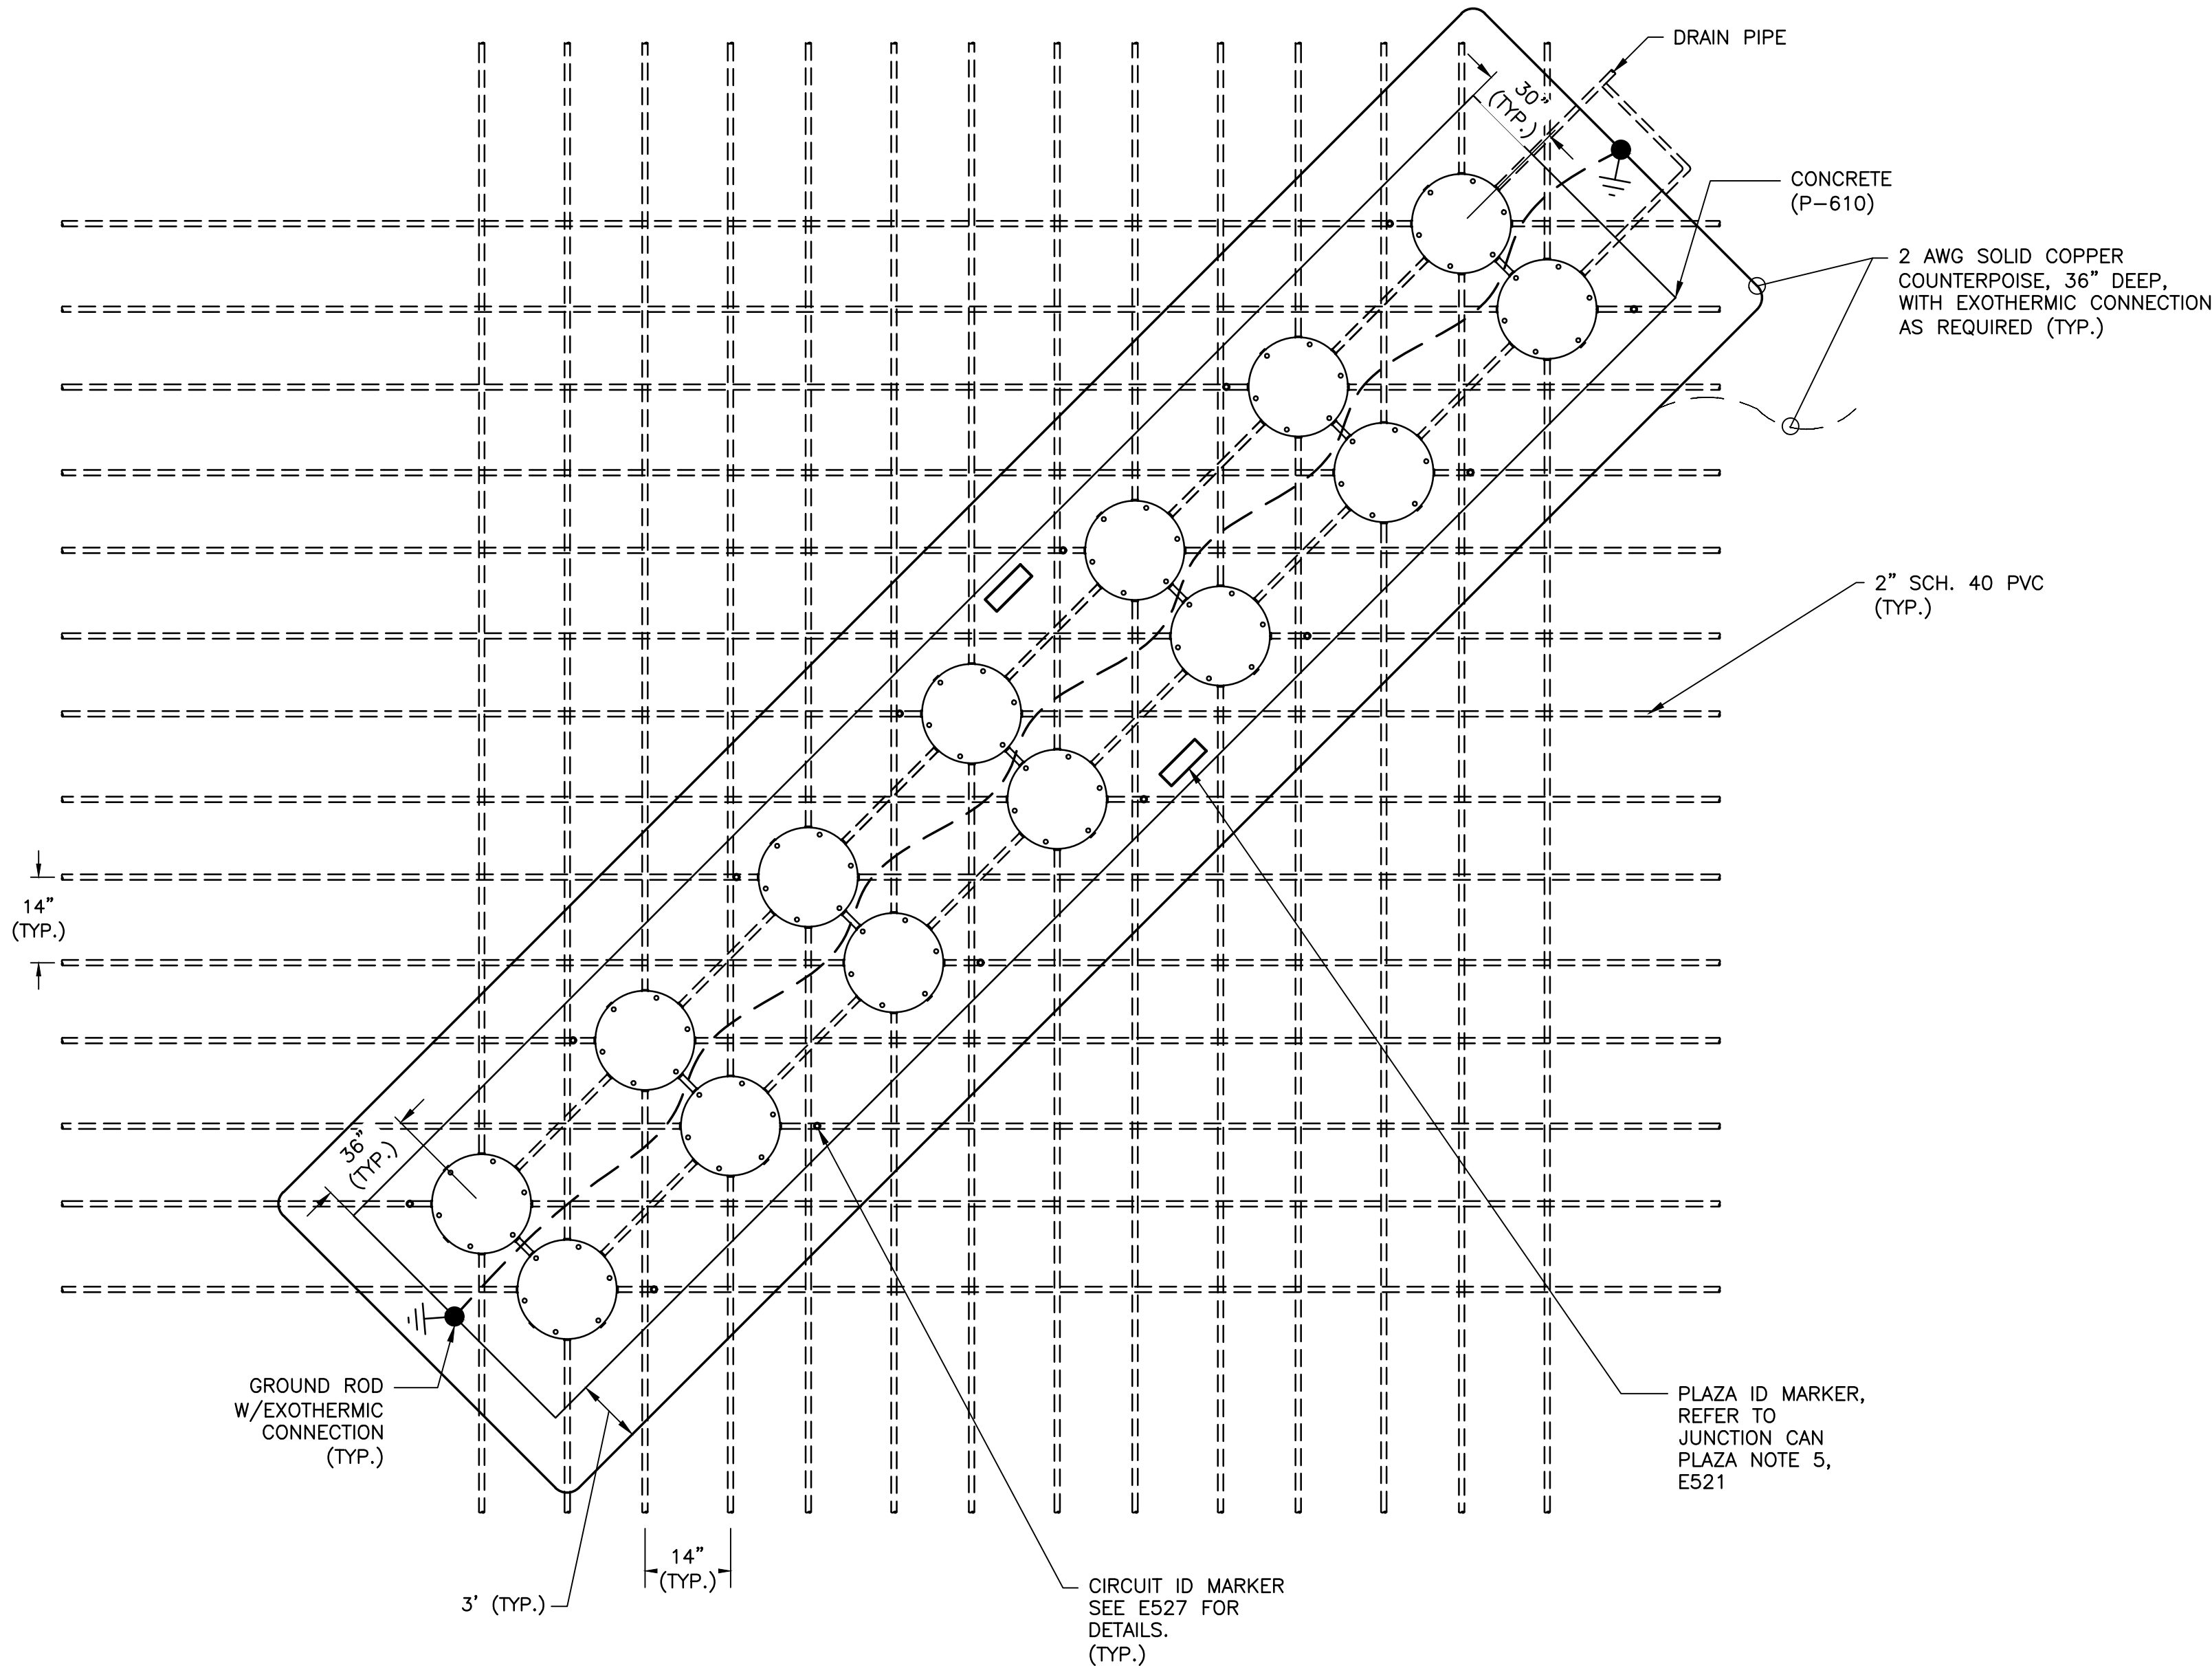

14-CAN JUNCTION PLAZA
N.T.S.

SHEET NOTES:

- 14 CAN L-867D JUNCTION CAN PLAZA SHOWN, NUMBER AND SIZE OF JUNCTION CANS AND CONDUIT CONFIGURATIONS VARY. SEE CIRCUITING PLANS FOR ORIENTATION. MODIFY OVERALL PAD SIZE TO ACCOMMODATE THE QUANTITY AND SIZE OF JUNCTION CANS SHOWN IN THE PLANS.
- CONDUITS WHICH ARE NOT USED IN THE PROJECT SHALL BE CAPPED 12" OUTSIDE OF PLAZA CONCRETE. CONCRETE DUCT ENCASEMENT SHALL BE PLACED CAREFULLY AND SHALL NOT OBSTRUCT UNUSED DUCTS.
- ORIENT PLAZA AS SHOWN ON AIRFIELD CIRCUITING PLAN SHEETS
- CONTRACTOR SHALL PROVIDE A 2" DIA BRONZE MARKER AT EACH JUNCTION CAN AS SHOWN. MARKER SHALL BE STAMPED IF JUNCTION CAN IS UTILIZED WITH CIRCUIT IDENTIFICATION AS SHOWN ON AIRFIELD CIRCUITING PLAN SHEETS, OTHERWISE LEAVE MARKER BLANK.
- INSTALL GROUND ROD AND GROUND LOOP AT ALL JUNCTION CAN PLAZAS AS SHOWN. GROUND RODS SHALL BE 3/4" DIAMETER, 10 FEET LONG, COPPER CLAD STEEL SECTIONAL RODS. EACH GROUND ROD SHALL BE INDIVIDUALLY TESTED PRIOR TO CONNECTION TO THE GROUND GRID OR COUNTERPOISE. EACH INDIVIDUAL ROD SHALL HAVE AN EARTH RESISTANCE OF ~~100~~ **10** OHMS OR LESS. ADDITIONAL SECTIONS SHALL BE ADDED TO THE ROD TO ACHIEVE THE ~~100~~ **10** OHM REQUIREMENTS. SEE ITEM L-108. GROUND RODS REQUIRED FOR JUNCTION CAN PLAZAS ARE NOT SHOWN ON THE PLANS BUT ARE REQUIRED. GROUND RODS ARE PAID FOR UNDER THE L-108 PAY ITEM.
- SEE AIRFIELD CIRCUITING PLAN SHEETS FOR JCP IDENTIFICATION NUMBERS. CONTRACTOR SHALL LABEL 2 ENDS OF EACH JUNCTION CAN PLAZA (JCP) BY IMPRESSING THE JCP IDENTIFICATION NUMBER INTO THE CONCRETE FOUNDATION DURING PLACEMENT. LETTERS AND NUMBERS SHALL BE 4" IN HEIGHT, PROPORTIONAL IN WIDTH, AND HAVE A STROKE WIDTH OF 1/2" AND 1/4" DEPTH. HAND LETTERING IS SPECIFICALLY PROHIBITED.
- CONTRACTOR SHALL GRADE AROUND JUNCTION CAN PLAZAS AS NECESSARY TO PREVENT SILT/DIRT INFILTRATION ONTO JUNCTION CAN PLAZAS. EXCAVATION, GRADING, FILL, SOD, ETC. FOR JUNCTION CAN PLAZAS IS INCIDENTAL TO THE RESPECTIVE JUNCTION CAN PLAZA PAY ITEM.
- LEAVE APPROXIMATELY 8' OF EACH CABLE COILED IN JUNCTION CAN SO THAT EACH CABLE MAY BE RAISED A MINIMUM OF 3' ABOVE TOP OF CAN.
- CONTRACTOR SHALL PROVIDE CABLE CIRCUIT IDENTIFICATION MARKERS ATTACHED TO EACH CABLE IN JUNCTION CANS, SEE CABLE IDENTIFICATION REQUIREMENTS.
- TRANSITION FROM MULTI-WAY CONDUIT TRENCH TO JUNCTION CAN PLAZAS REQUIRES DISTRIBUTION OF RESPECTIVE DUCT TO EACH JUNCTION CAN. CONTRACTOR SHALL LIMIT CONDUIT BENDS TO 30 DEGREES MAXIMUM.
- EACH JUNCTION CAN HAS 7 HUBS. HUBS SHALL BE PLACED IN 3 LAYERS. THE TWO HUBS IN EACH OF THE THREE LAYERS SHALL BE 180' APART. THE BOTTOM TWO LAYERS SHALL BE 90' APART FROM EACH OTHER. THE UPPER LAYER IS ROTATED APPROXIMATELY 54'. CCW. FROM THE BOTTOM SET OF HUBS.
- VERTICAL SPACING FOR L-867D JUNCTION CAN BOTTOM LAYERS OF HUBS IS 2 1/2" AND FOR L-867E JUNCTION CAN 5".
- THE LAST 10 FEET OF DUCT BANK IMMEDIATELY ADJACENT TO THE JUNCTION CAN PLAZA IS NOT REQUIRED TO BE CONCRETE ENCASED. ALL OTHER DUCT BANK (EXCEPT DIRECTIONAL BORE) SHALL BE CONCRETE ENCASED. THE TRANSITION BETWEEN DIRECTIONAL BORE AND THE CONCRETE ENCASEMENT IS EXPECTED TO OCCUR 36" TO 48" BELOW FINISHED GRADE.
- THREADED HUBS SHALL BE USED FOR 2" AND SMALLER CONDUIT ENTRY. CONDUIT ENTRY LARGER THAN 2" SHALL BE USE RUBBER GROMMET AND PVC BOX ADAPTER WITH COUPLING.
- CONDUIT SIZE ENTRY VARIES WITH LOCATION. CONTRACTOR SHALL INVESTIGATE EACH LOCATION FOR SPECIFIC CONDUIT ENTRY SIZE.



**JUNCTION CAN
PLAZA DETAILS
(SHEET 3 OF 3)**

**RUNWAY 8-26
REHABILITATION**
PREPARED FOR
PENSACOLA INTERNATIONAL AIRPORT

DESIGNED BY: SAH
DRAWN BY: KJF
CHECKED BY: MAG
APPROVED BY: VCL
PROJECT NO: 24.0359.01
DATE: MARCH 28, 2025

**SHEET NUMBER
E522**

N:\MICHELLE-CAD\02-LOGS\JWES\Jwesc 1.000.png


AVCON, INC.
ENGINEERS & PLANNERS
3298 SUMMIT BLVD., SUITE 26
PENSACOLA, FL 32503
OFFICE: (850) 688-5526
CORPORATE CERTIFICATE OF
AUTHORIZATION NUMBER: 5057
WWW.AVCONINC.COM

TRANSFORMING TODAY'S IDEAS
INTO TOMORROW'S REALITY

NO.	DATE	REVISION	BY
1	4/25	ADDENDUM 3	SAH


THIS DOCUMENT CONTAINS PRIVILEGED AND PROPRIETARY INFORMATION, ALL OF WHICH IS EXPRESSLY PROVIDED BY AVCON, INC., FOR USE BY THE INTENDED RECIPIENT, AND FOR A SPECIFIC PURPOSE. WITHOUT THE EXPRESS WRITTEN CONSENT OF AVCON, INC. ANY DISTRIBUTION, REPRODUCTION, OR OTHER USE OF THIS DOCUMENT, IN WHOLE OR IN PART, IS STRICTLY PROHIBITED.

N:\359 CITY OF PENSACOLA-AIRPORT\2024-0359.01-PNS RUNWAY 8-26\000 CAD\24035901_E524-DWG 4/11/2025 8:57 AM

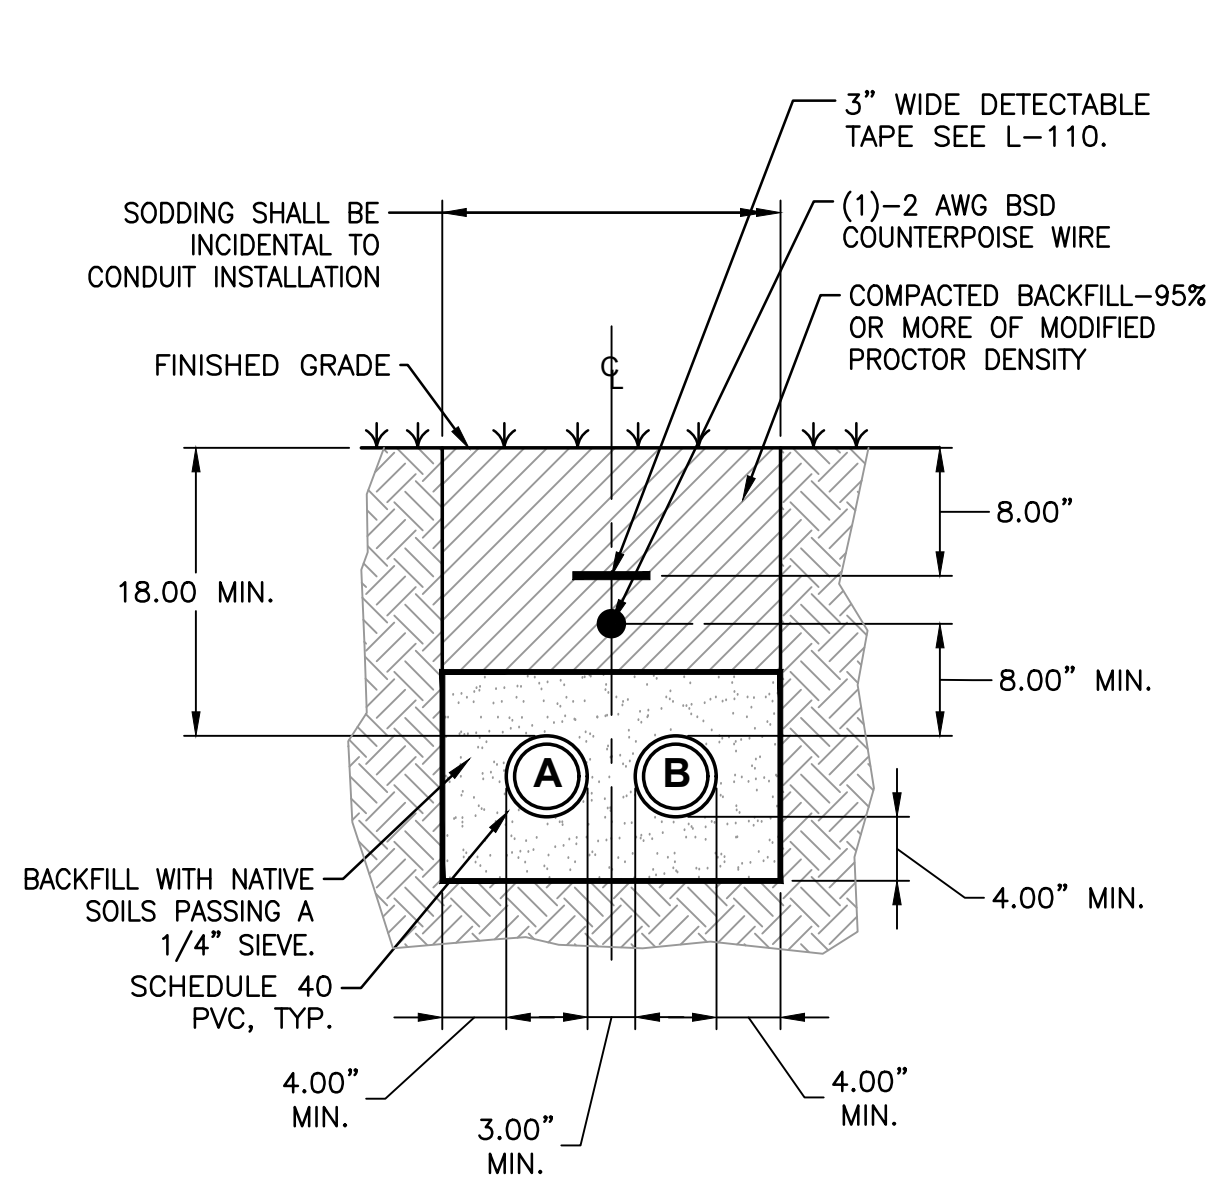


**2 WAY 2" DUCT BANK
DIRECT BURIED**

NTS

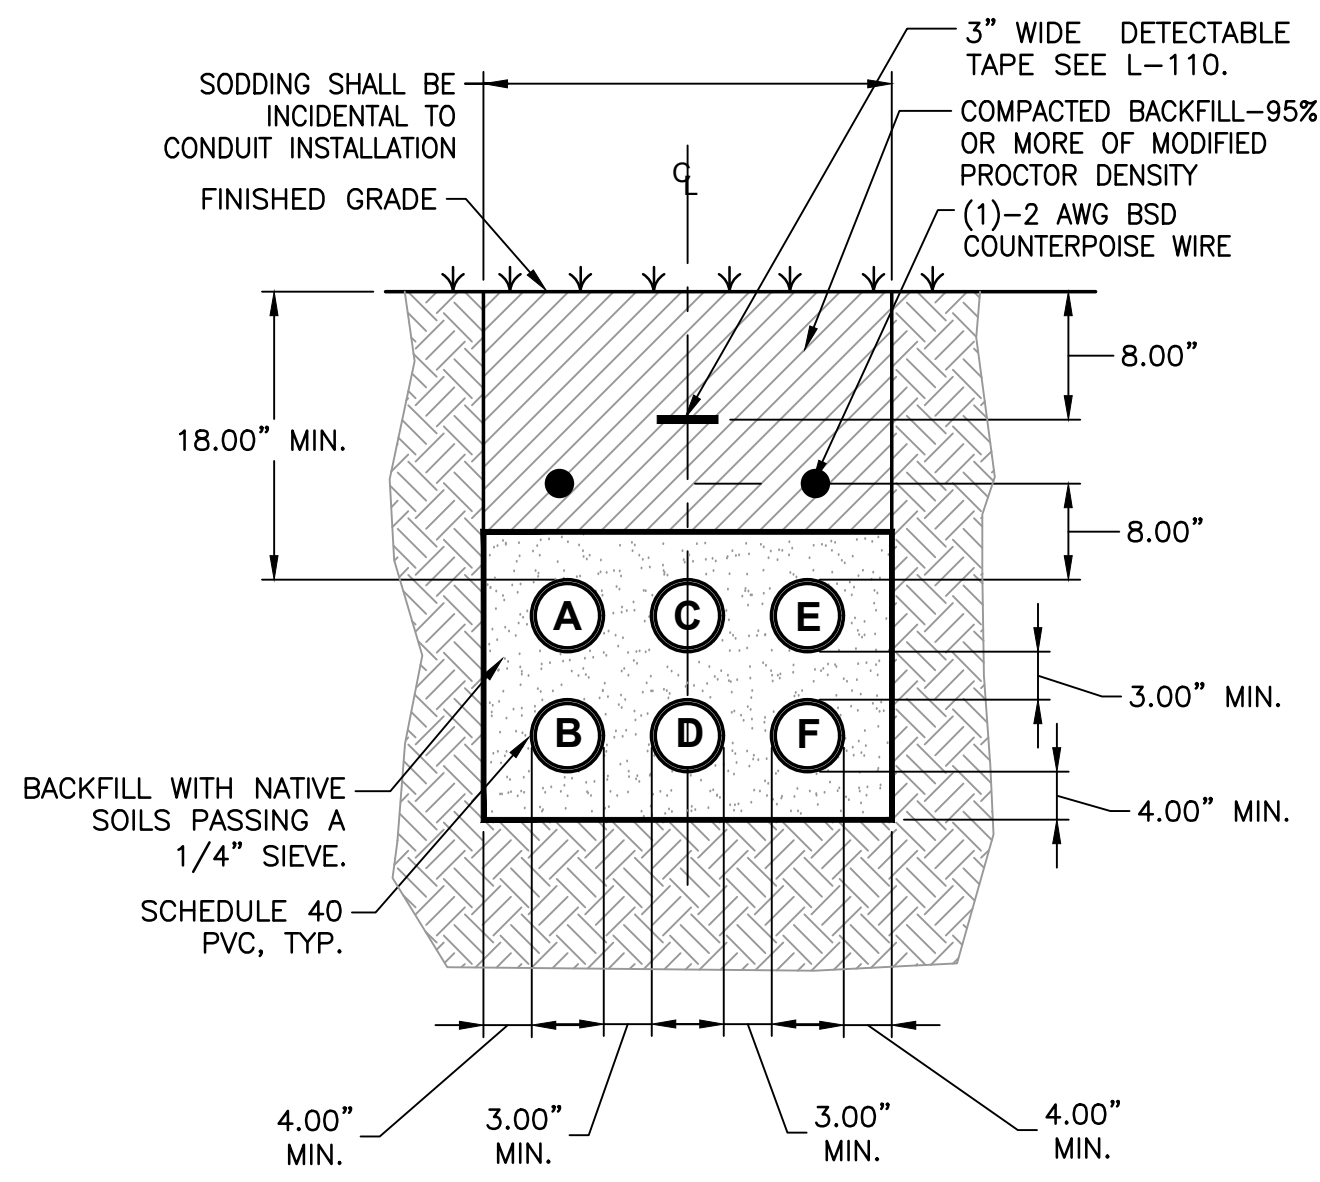

**6 WAY 2" DUCT BANK
DIRECT BURIED**


NTS

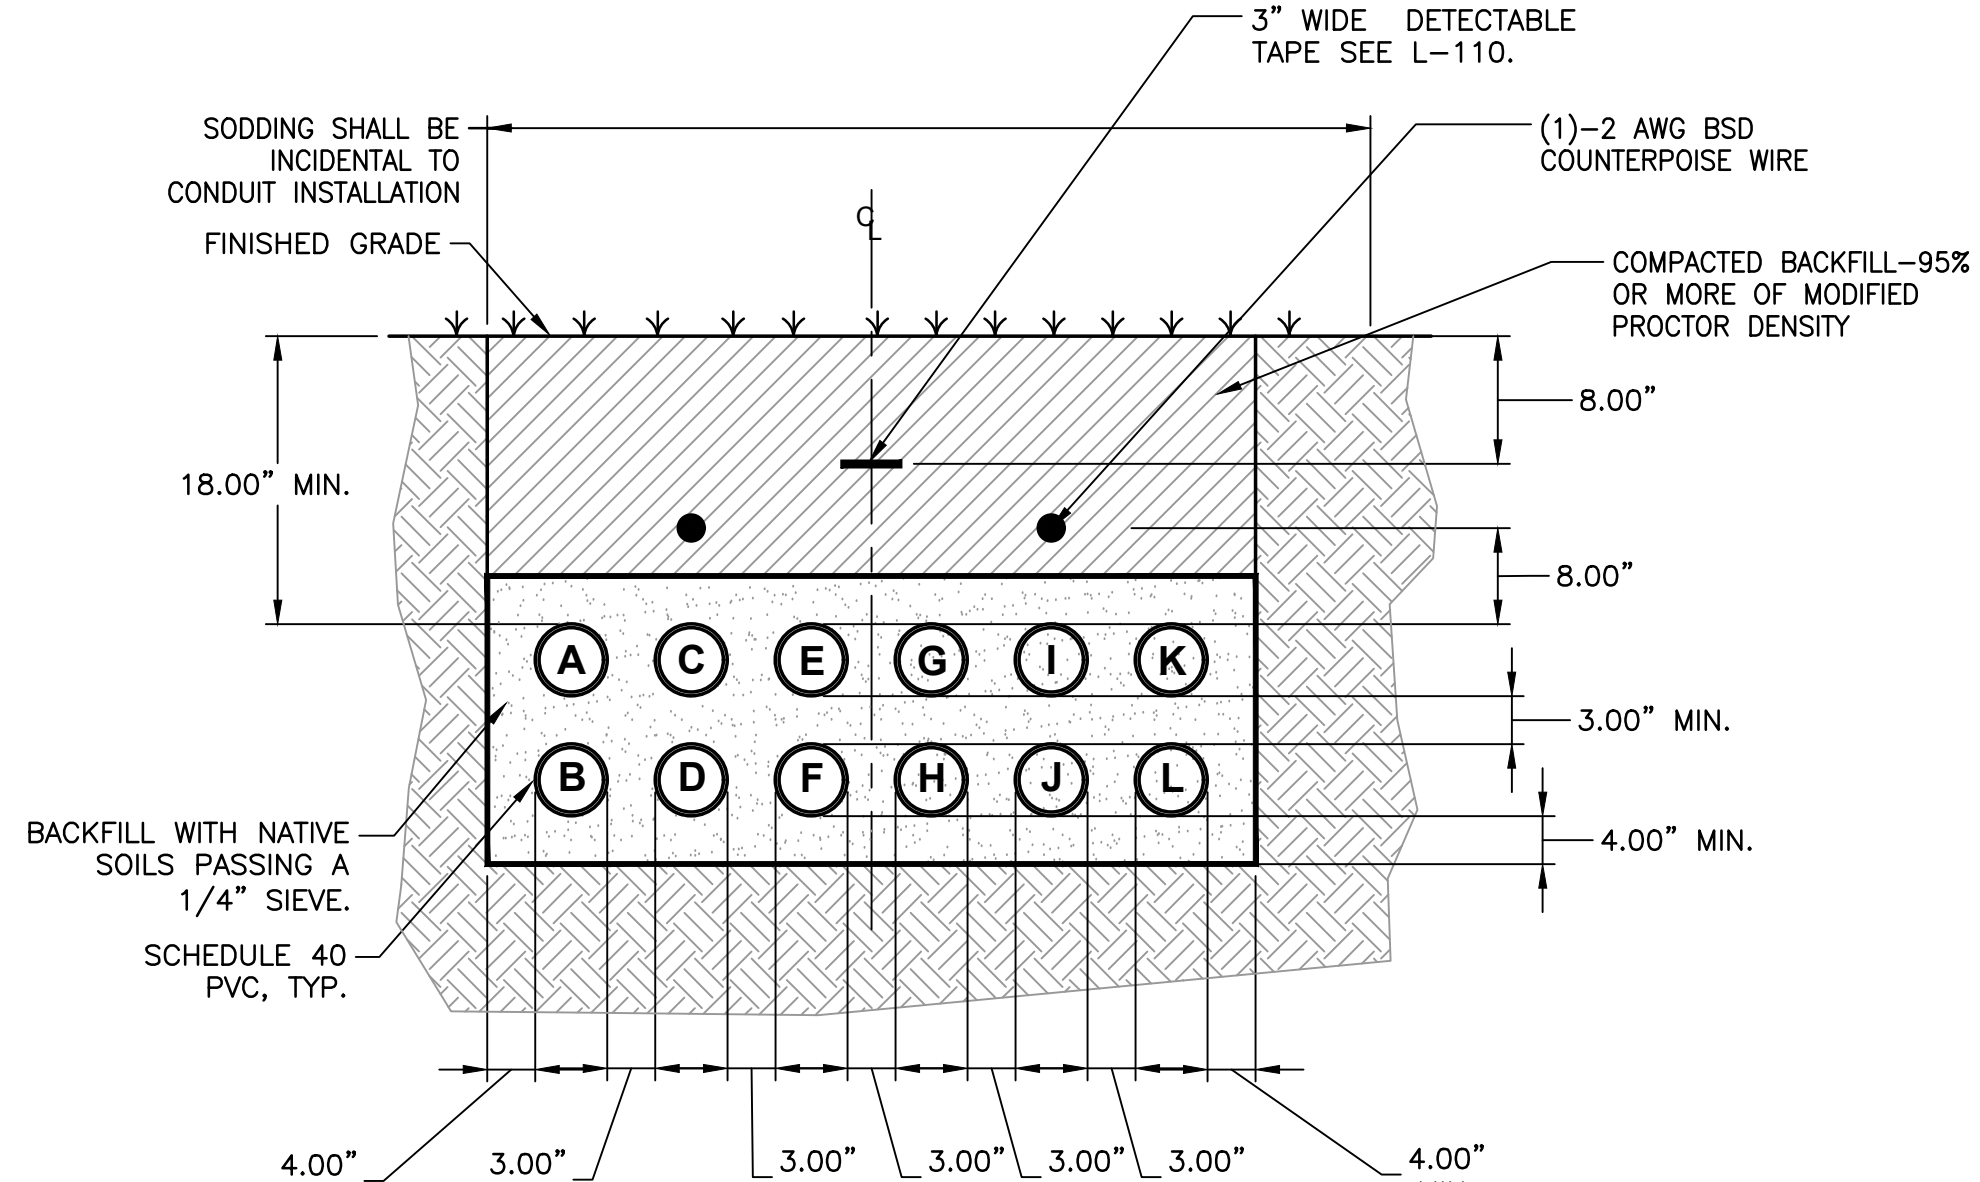

**12 WAY 2" DUCT BANK
DIRECT BURIED**


NTS

1

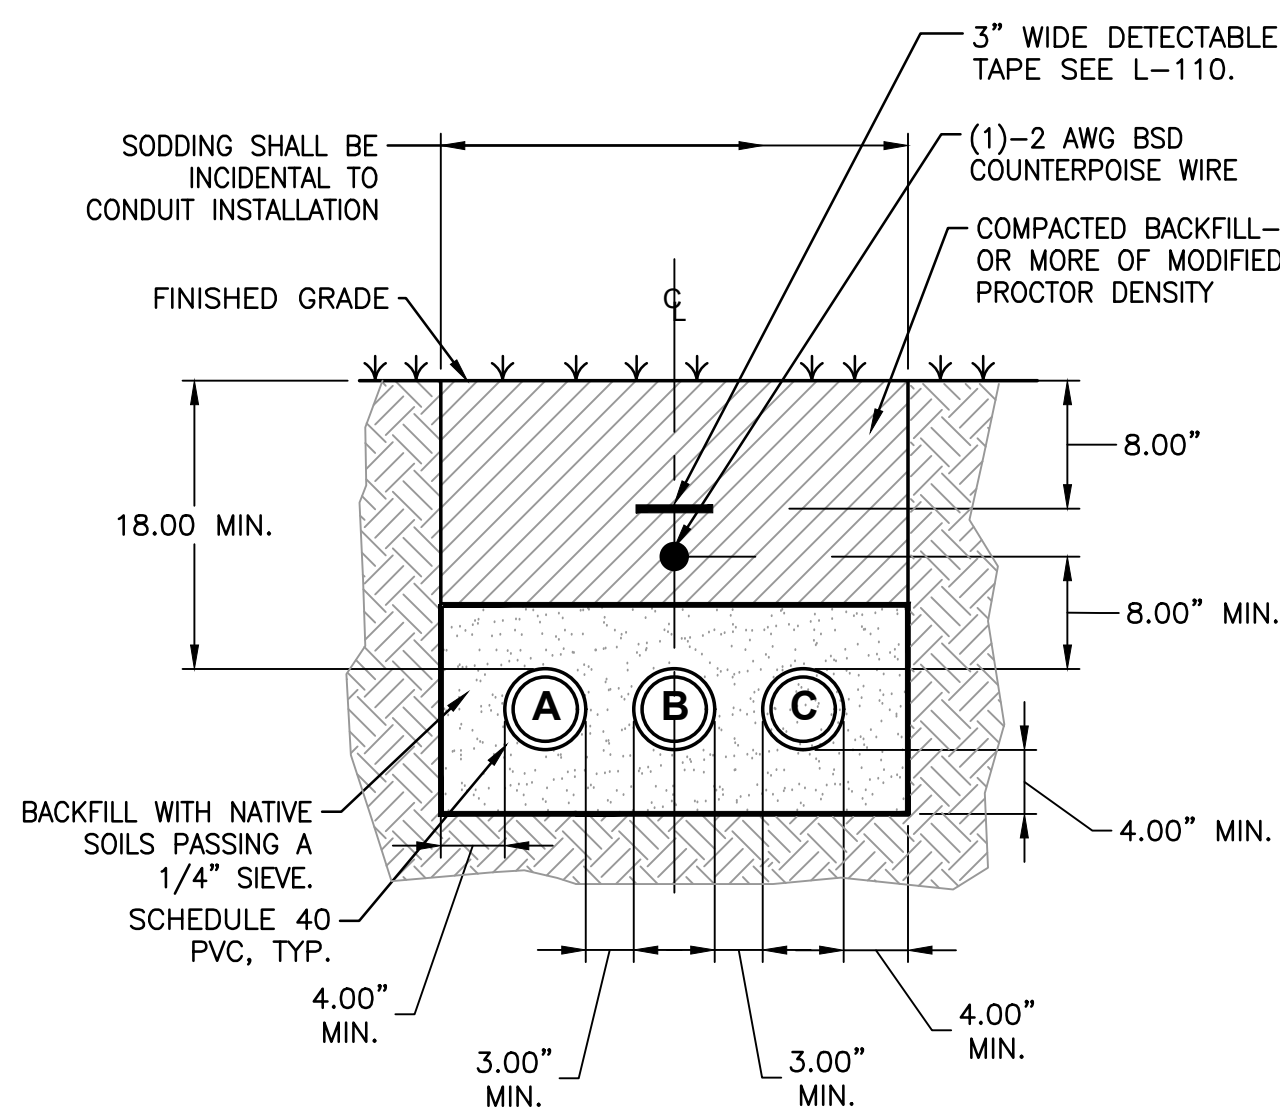

**3 WAY 2" DUCT BANK DIRECT
BURIED**

NTS

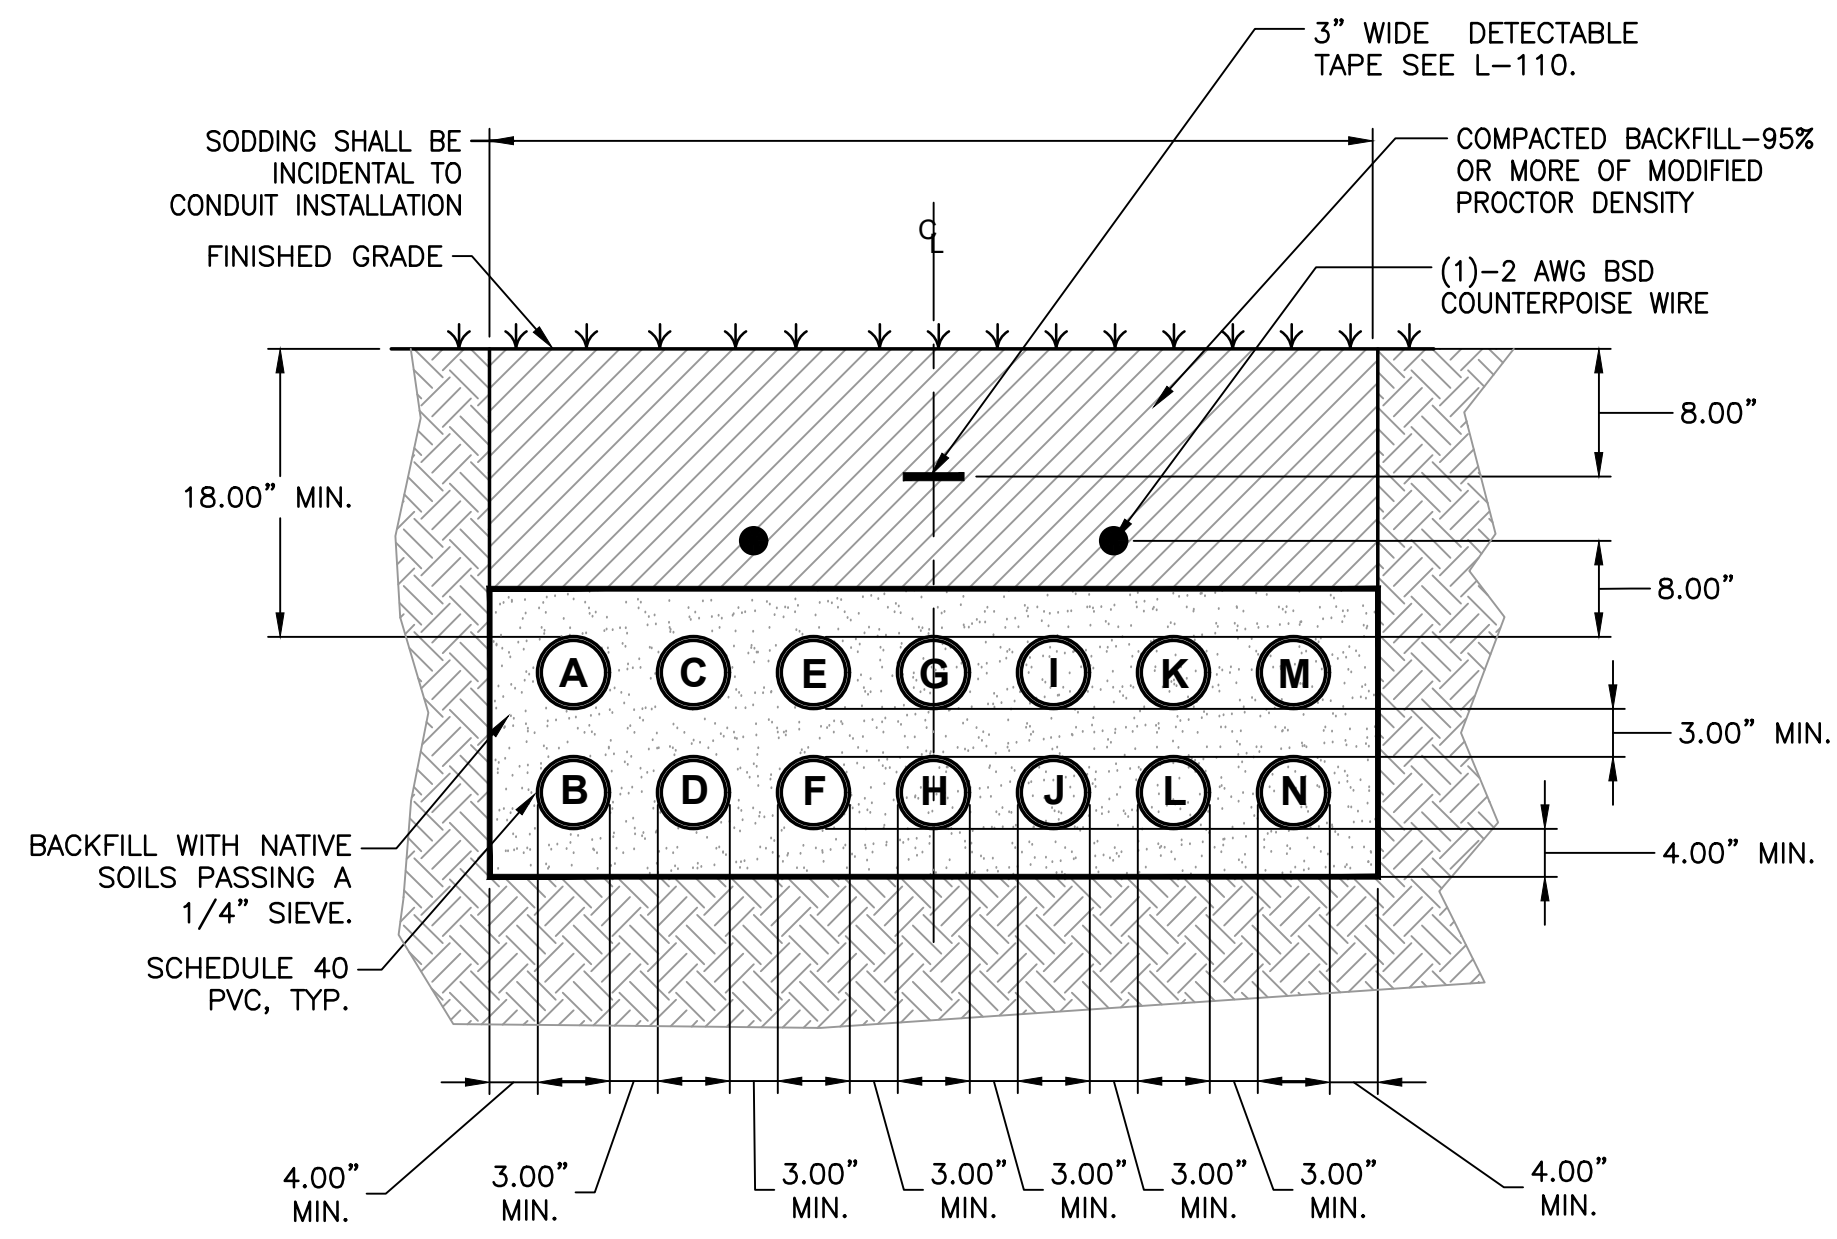

**14 WAY 2" DUCT BANK
DIRECT BURIED**

NTS


NO.	DATE	REVISION	BY
1	4/25	ADDENDUM 3	SAH
2			
3			
**CONDUIT AND DUCT
BANK DETAILS
(SHEET 2 OF 3)**
ISSUED FOR BID DRAWINGS

**RUNWAY 8-26
REHABILITATION**
PREPARED FOR
PENSACOLA INTERNATIONAL AIRPORT


DESIGNED BY: SAH
DRAWN BY: KJF
CHECKED BY: MAG
APPROVED BY: VCL
PROJECT NO: 24.0359.01
DATE: MARCH 28, 2025

**SHEET NUMBER
E524**

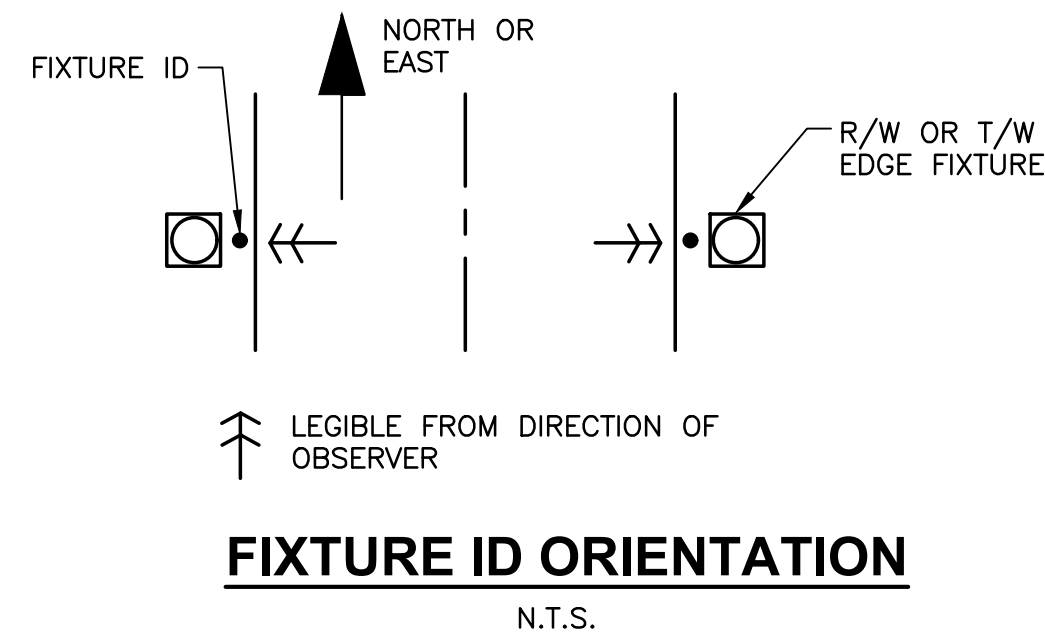

1. ALL L-824 CABLES SHALL BE IDENTIFIED WITH AN 18-GAUGE, 2" DIAMETER STAINLESS STEEL ID TAG ENGRAVED OR LASER ETCHED WITH ITS RESPECTIVE CIRCUIT/LOOP NUMBER AT ALL ACCESSIBLE LOCATIONS. ACCESSIBLE LOCATIONS ARE DEFINED IN THE NEC. ATTACH ID TAG 12 INCHES FROM THE L-823 CONNECTORS. CABLES SHALL BE IDENTIFIED ON EACH SIDE OF A CONNECTOR IN ACCORDANCE WITH THE CONTRACT DOCUMENTS. WHERE NO CONNECTORS ARE INSTALLED, INSTALL TWO CABLE ID TAGS. ONE ON EACH SIDE OF WHERE A FUTURE CONNECTOR WOULD BE INSTALLED. CIRCUIT/LOOP NUMBERS SHALL BE ENGRAVED OR LASER ETCHED AND BLACK FILLED INTO THE STAINLESS STEEL TAGS WITH, 3/8" LETTER HEIGHT, HELVETICA MEDIUM OR ACCEPTED EQUIVALENT FONT. THE CONTRACTOR'S SUBMITTAL SHALL INCLUDE TWENTY-FOUR ID TAGS STAMPED WITH THE CHARACTERS "R826E". PARTIAL ACCEPTANCE OF THE TWENTY-FOUR ID TAGS WILL REQUIRE RESUBMITTAL OF THE UNACCEPTABLE ID TAGS PRIOR TO CONSTRUCTION BEGINNING. ONCE THE TAGS ARE ACCEPTED, THE OAR WILL USE THEM AS A BASIS OF ACCEPTANCE FOR THE FIELD INSTALLED ID TAGS.
2. FURNISHING AND INSTALLING ALL L-823 CONNECTORS, TAPE, STAINLESS STEEL ID TAGS, NUMBERED L-824 CABLE, TY-RAPS, AND ALL APPURTENANCES ARE INCIDENTAL TO THE RESPECTIVE CABLE PAY ITEM OF WHICH IT IS A COMPONENT PART.
3. ALL LIGHT BASE AND DUCT BANK COUNTERPOISE CONDUCTORS SHALL BE BONDED AT EACH CROSSING OF THE GROUND GRID AND SHALL BE BONDED TO A "DRIVEN GROUND ROD AT 500" MAXIMUM INTERVALS.
4. EACH GROUND ROD SHALL MEASURE 10 OHMS OR LESS, PRIOR TO CONNECTION TO THE GROUND SYSTEM. ADDITIONAL GROUND ROD SECTIONS SHALL BE ADDED TO OBTAIN THE 10 OHM VALUE.
5. EDGE LIGHTS SHALL BE WIRED IN NUMERICAL SEQUENCE WITHOUT ZIG-ZAGGING BACK AND FORTH ACROSS THE TAXIWAY. THE 5KV L-824 AIRFIELD SERIES CIRCUIT LIGHTING CABLE SHALL BE SUPPLIED WITH FACTORY IMPRINTED NUMBERS.

1. CLEAN HOLE WITH WIRE BRUSH AND DRY COMPRESSED AIR IMMEDIATELY PRIOR TO PLACING THE P-606. THE P-606 FILL TUBE SHALL BE KEPT WITHIN 1/8" OF THE BOTTOM OF THE DRILLED HOLE DURING FILLING TO PREVENT AIR ENTRAPMENT. INSTALL MARKER AND ROTATE 1/4 TURN. VOLUME OF P-606 USED SHALL BE SUFFICIENT TO ALLOW A SMALL AMOUNT TO SQUEEZE OUT EVENLY AROUND THE PERIMETER OF THE MARKER TOP. ANY OVER OR UNDER POURS SHALL BE CORRECTED IMMEDIATELY.
2. INSTALLATION OF ID MARKERS AND ENGRAVING OF ID'S ARE INCIDENTAL TO FIXTURE, DUCT, HANDHOLE/MANHOLE, CABLE, ETC., PAY ITEMS. TEXT FONT SHALL BE HELVETICA MEDIUM OR ACCEPTED EQUIVALENT.
3. THE P-606 SHALL BE COMPATIBLE WITH THE TYPE OF PAVEMENT AND ENVIRONMENT IN WHICH IT IS BEING USED. THE MARKER MAY BE PLACED IN WET CONCRETE AS IT IS BEING INSTALLED.
4. THE ID MARKER IS PERMITTED TO BE SEMI FLUSH MOUNTED IN AREAS OUTSIDE THE FULL STRENGTH PAVEMENT. DRILL A .75" DIA. HOLE 1/4" DEEPER THAN THE STEM ON THE ID MARKER. INSTALL EPOXY PER NOTE 1 ABOVE AND INSTALL MARKER.
5. CONTRACTOR SHALL COORDINATE ITEM/FIXTURE IDENTIFICATION/NUMBERING WITH ENGINEER.
6. BRASS MARKER SHALL BE M/M-B2 BY SURV-KAP OF TUCSON ARIZONA, MANUFACTURED OF B115 BRASS AND SHALL WEIGHT 0.50 POUNDS EACH OR ACCEPTED EQUIVALENT.

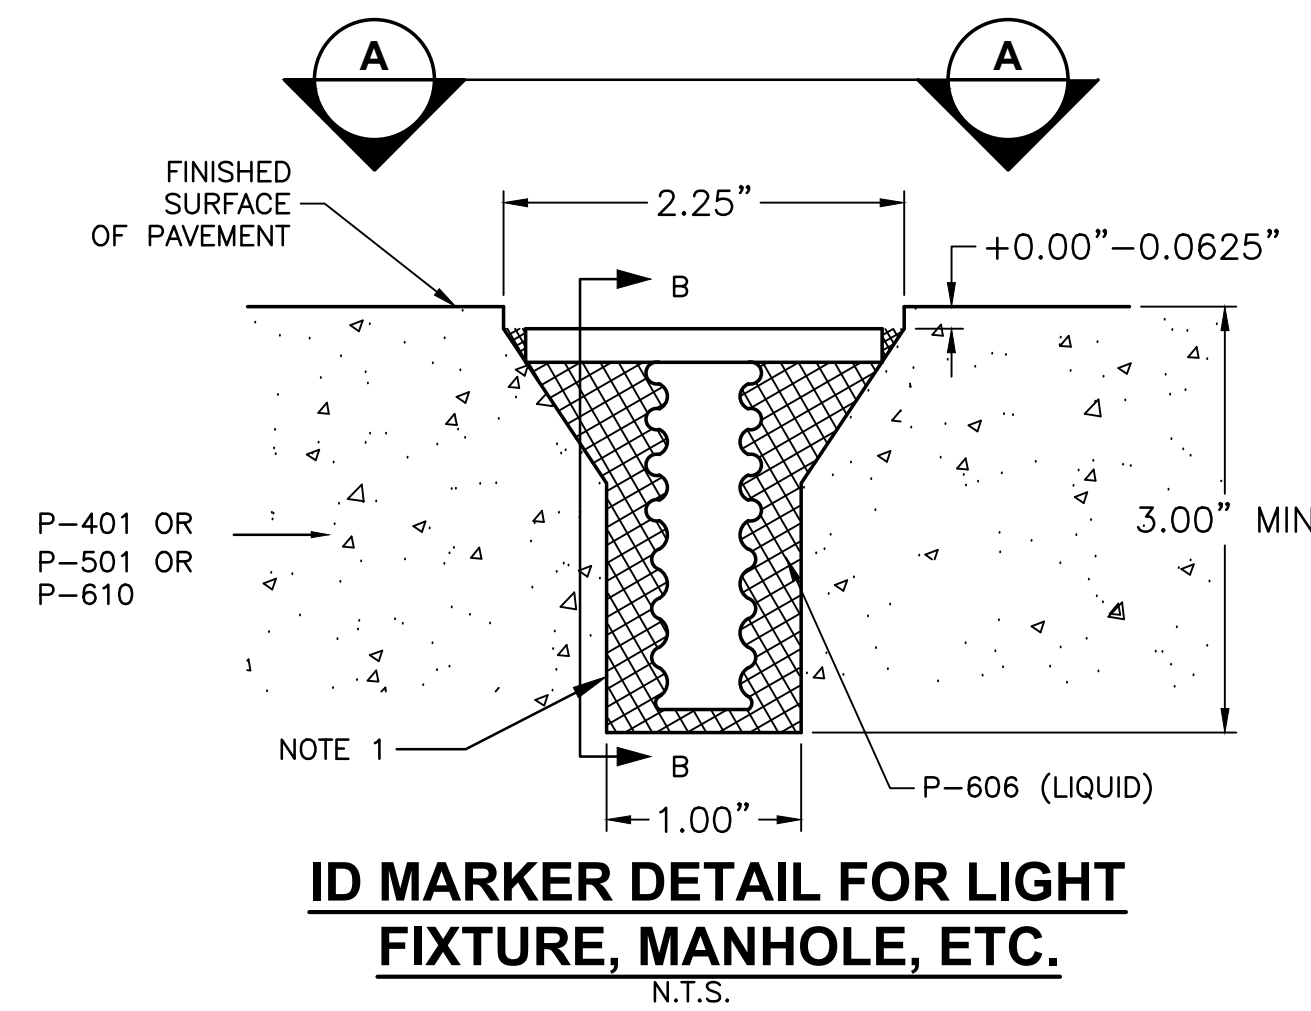



BRASS MARKER
SURV-KAP #M/M-B2
FLAT TOP OR
ACCEPTED EQUIVALENT


0.375" TEXT
TYP. SEE
NOTE 2.

R826E
-002

≈ 2.0625" DIA


SECTION A-A
N.T.S.

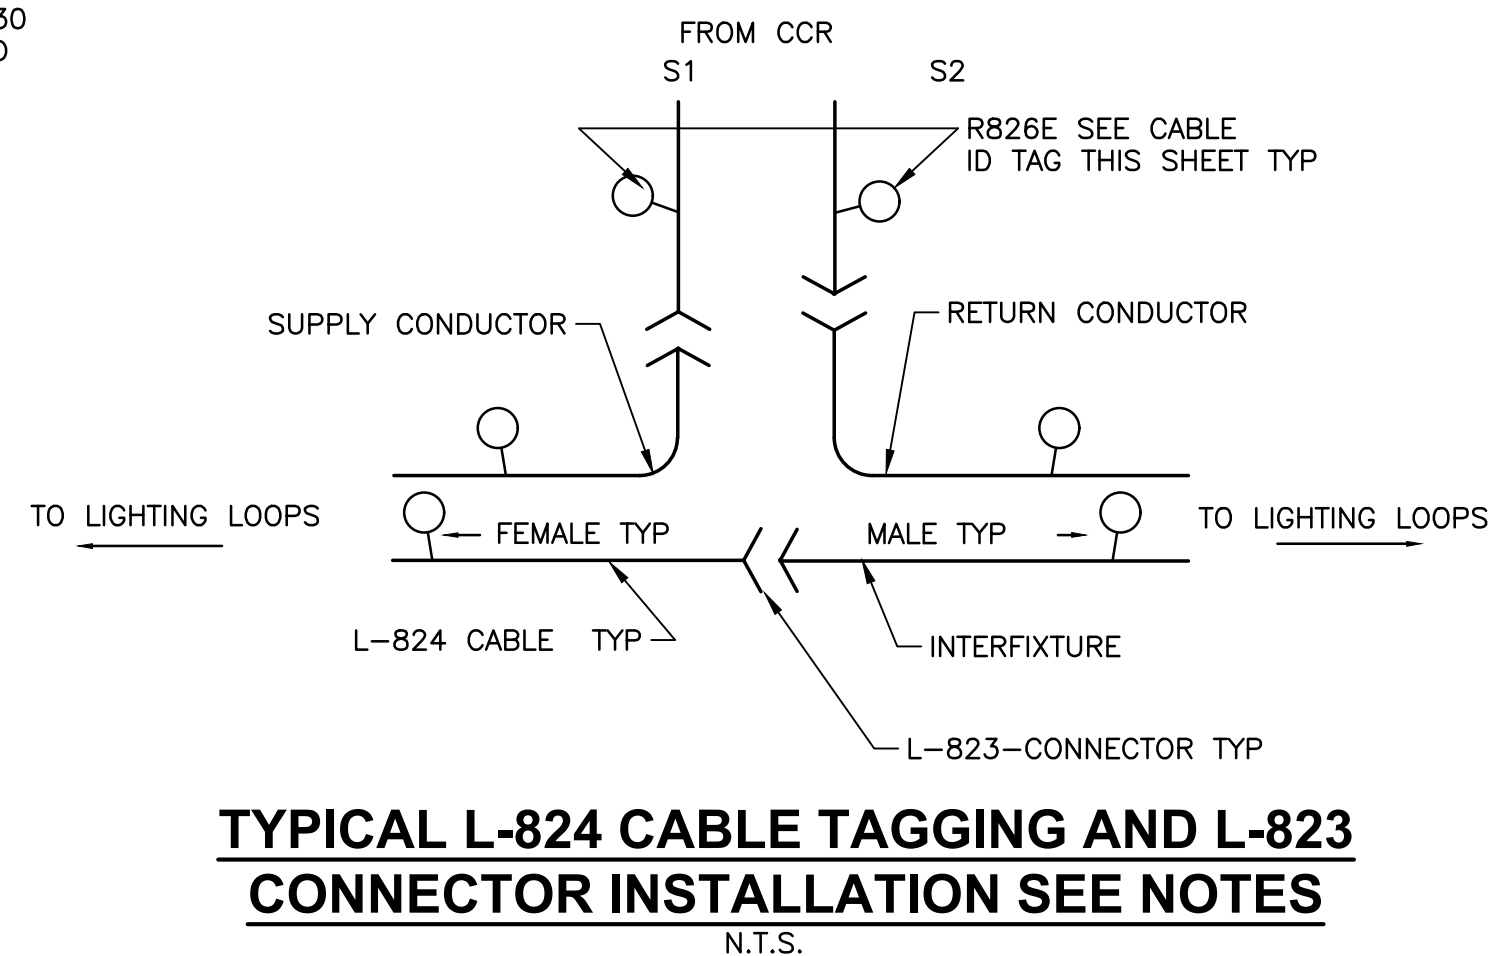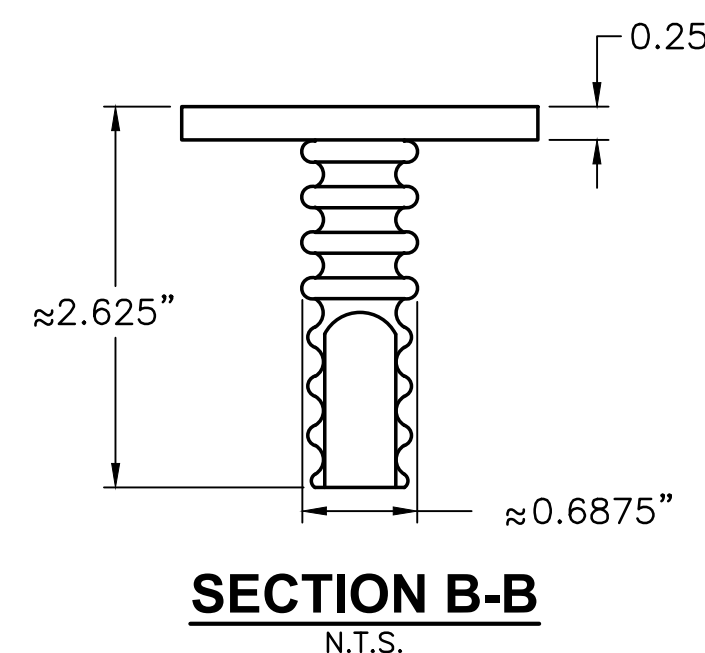

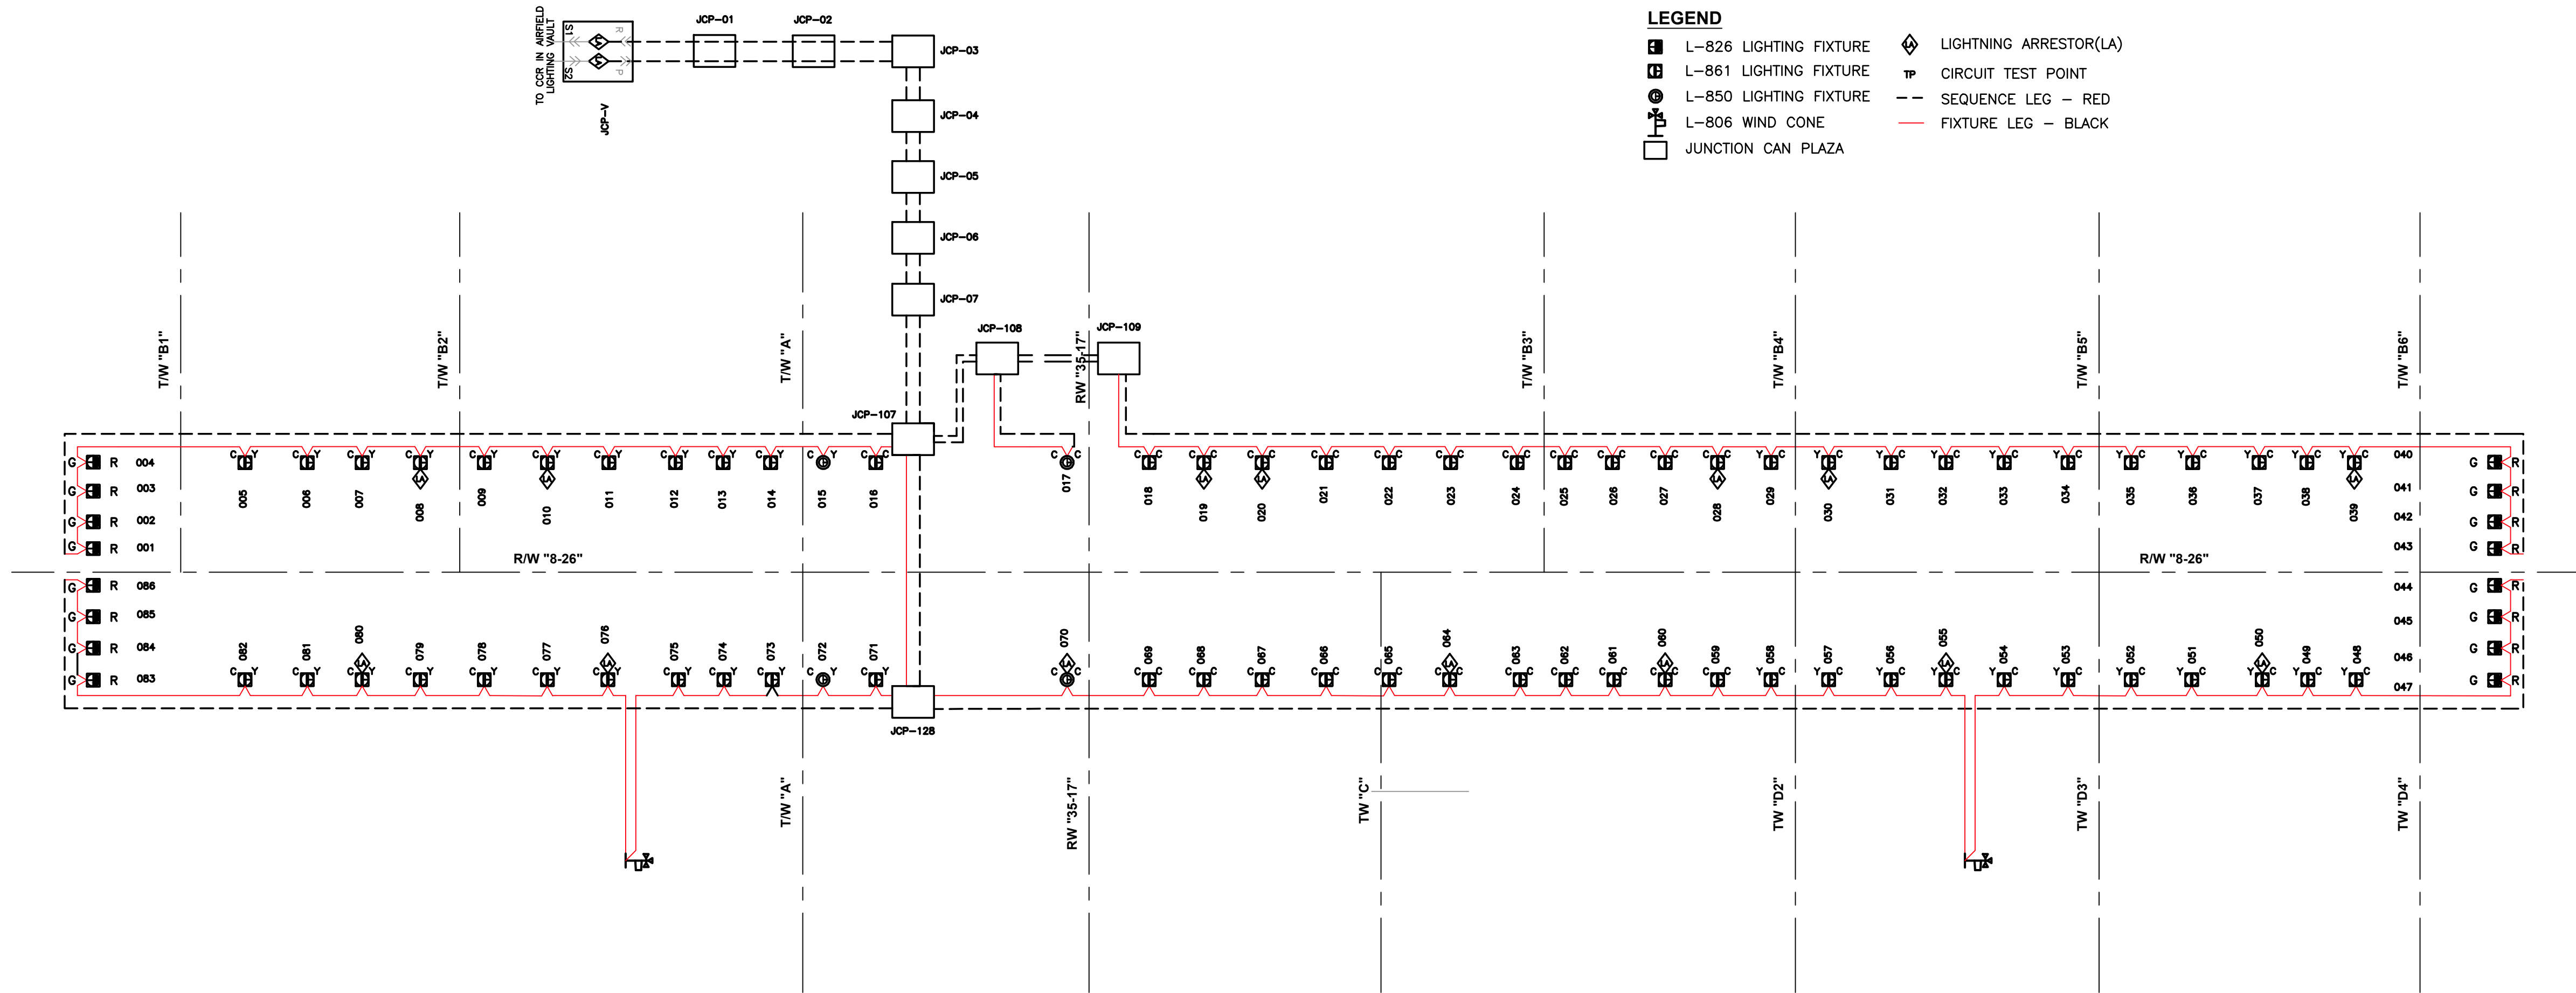

LEGEND

	L-826 LIGHTING FIXTURE		LIGHTNING ARRESTOR (LA)
	L-861 LIGHTING FIXTURE		CIRCUIT TEST POINT
	L-850 LIGHTING FIXTURE		SEQUENCE LEG - RED
	L-806 WIND CONE		FIXTURE LEG - BLACK
	JUNCTION CAN PLAZA		

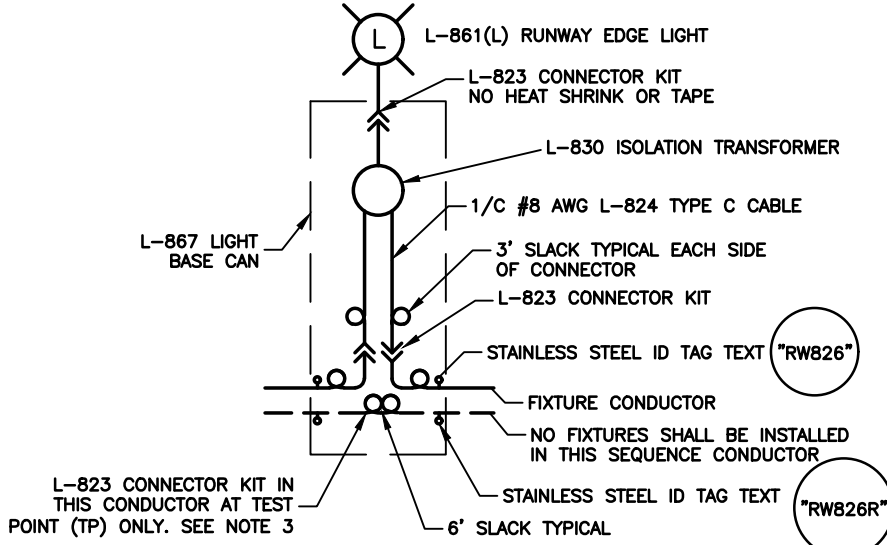

TYPICAL BASE CAN WIRING DETAILS


- NOTES:**
- L-823 CONNECTOR KITS SHALL BE INSTALLED SO THAT A PORTION OF THE LOOP CAN BE BYPASSED. THE FEMALE CONNECTORS SHALL BE ON THE LEAD FROM THE S1 TERMINAL OF THE COR.
 - SEE FIELD LIGHTNING ARRESTOR ASSEMBLY WIRING DETAILS.
 - RECORD LOCATION OF ALL ADDITIONAL L-823 CONNECTORS INSTALLED IN CABLE ON E-30X SERIES DRAWINGS AND THIS SHEET.

RUNWAY 8-26 (R826E) WIRING SCHEMATIC



AVCON, INC.
ENGINEERS & PLANNERS
3298 SUMMIT BLVD., SUITE 26
PENSACOLA, FL 32503
OFFICE: (850) 688-5526
CORPORATE CERTIFICATE OF
AUTHORIZATION NUMBER: 5057
WWW.AVCONINC.COM

TRANSFORMING TODAY'S IDEAS
INTO TOMORROW'S REALITY

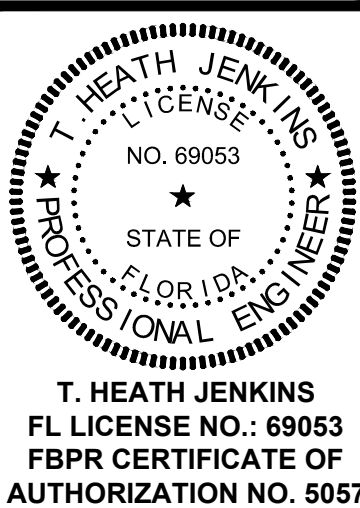

T. HEATH JENKINS
FL LICENSE NO.: 69053
FBPR CERTIFICATE OF
AUTHORIZATION NO. 5057

NO.	DATE	REVISION	BY
1			
2			
WIRING DETAILS
(SHEET 3 OF 3)


RUNWAY 8-26
REHABILITATION

DESIGNED BY: THJ
DRAWN BY: JLN
CHECKED BY: THJ
APPROVED BY: VCL
PROJECT NO: 24.0359.01
DATE: MARCH 28, 2025

SHEET NUMBER
E529


PREPARED FOR
PENSACOLA INTERNATIONAL AIRPORT

N:\359 CITY OF PENSACOLA-AIRPORT\2024-0359.01-PNS RUNWAY 8-26\000 CAD\24035901_E533.DWG 4/11/2025 11:46 AM

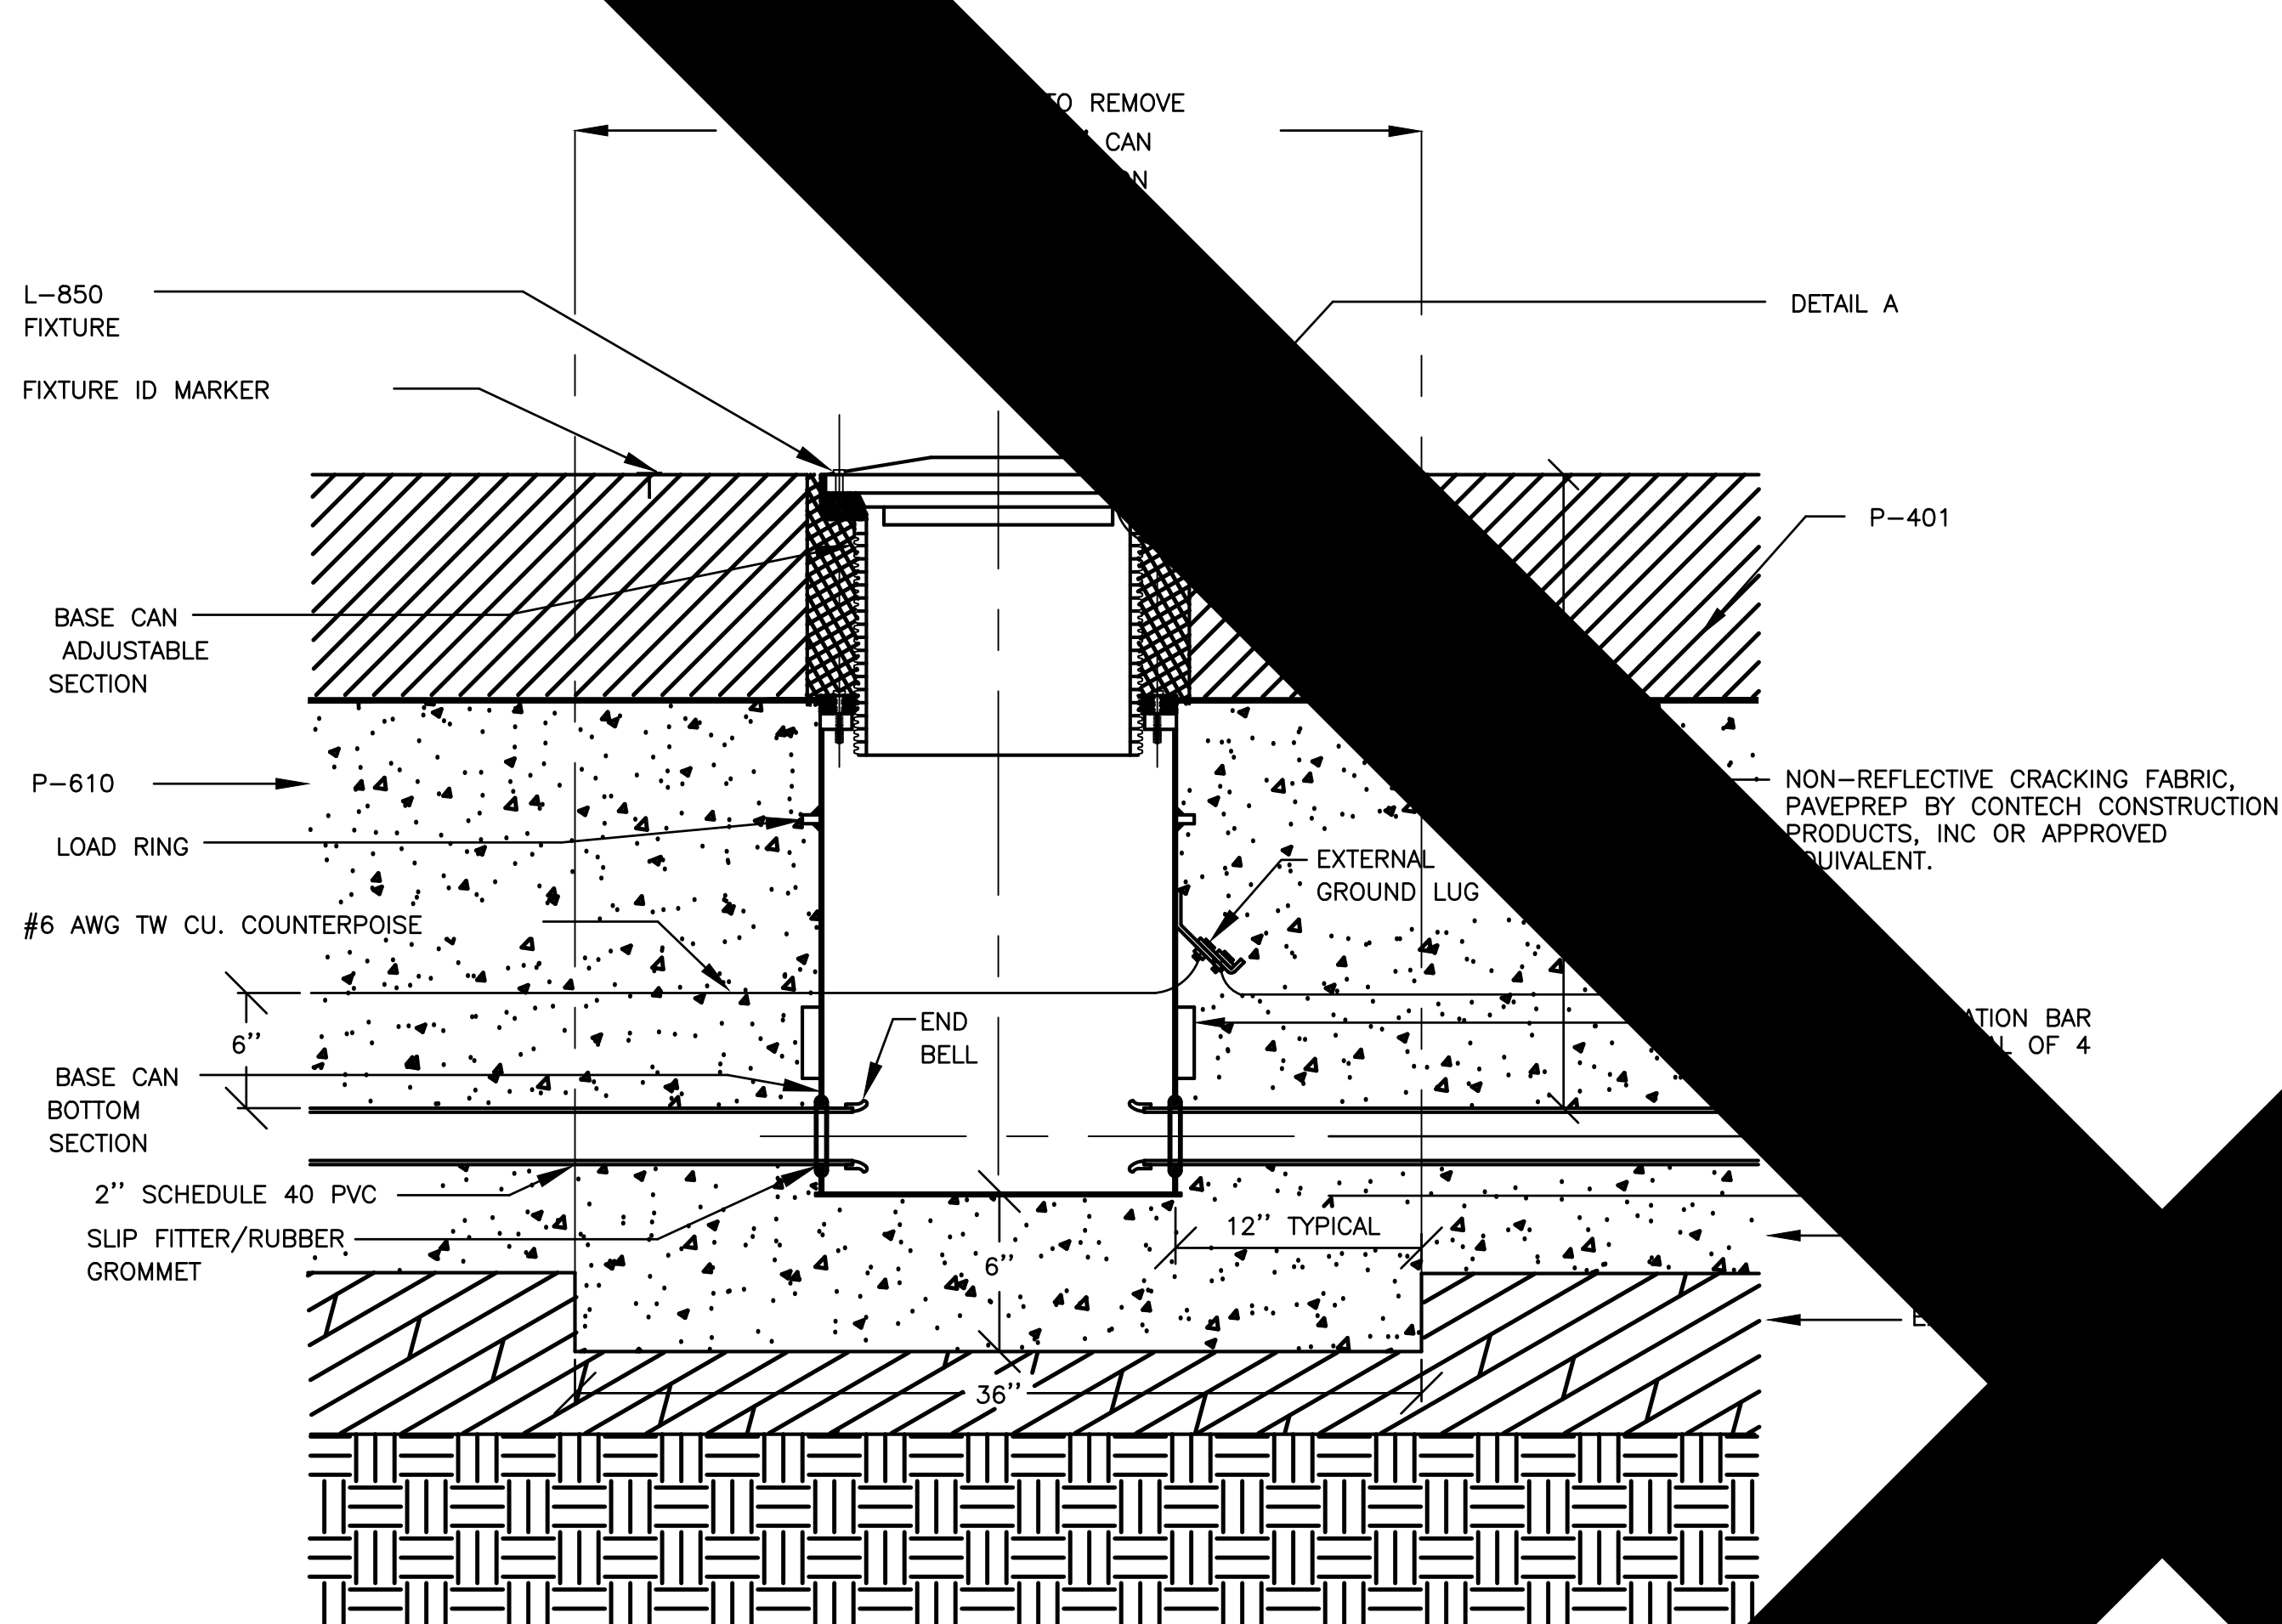


L-850 IN EXISTING ASPHALT W/ TWO PIECE "SAFE" BASE CAN

N.T.S.

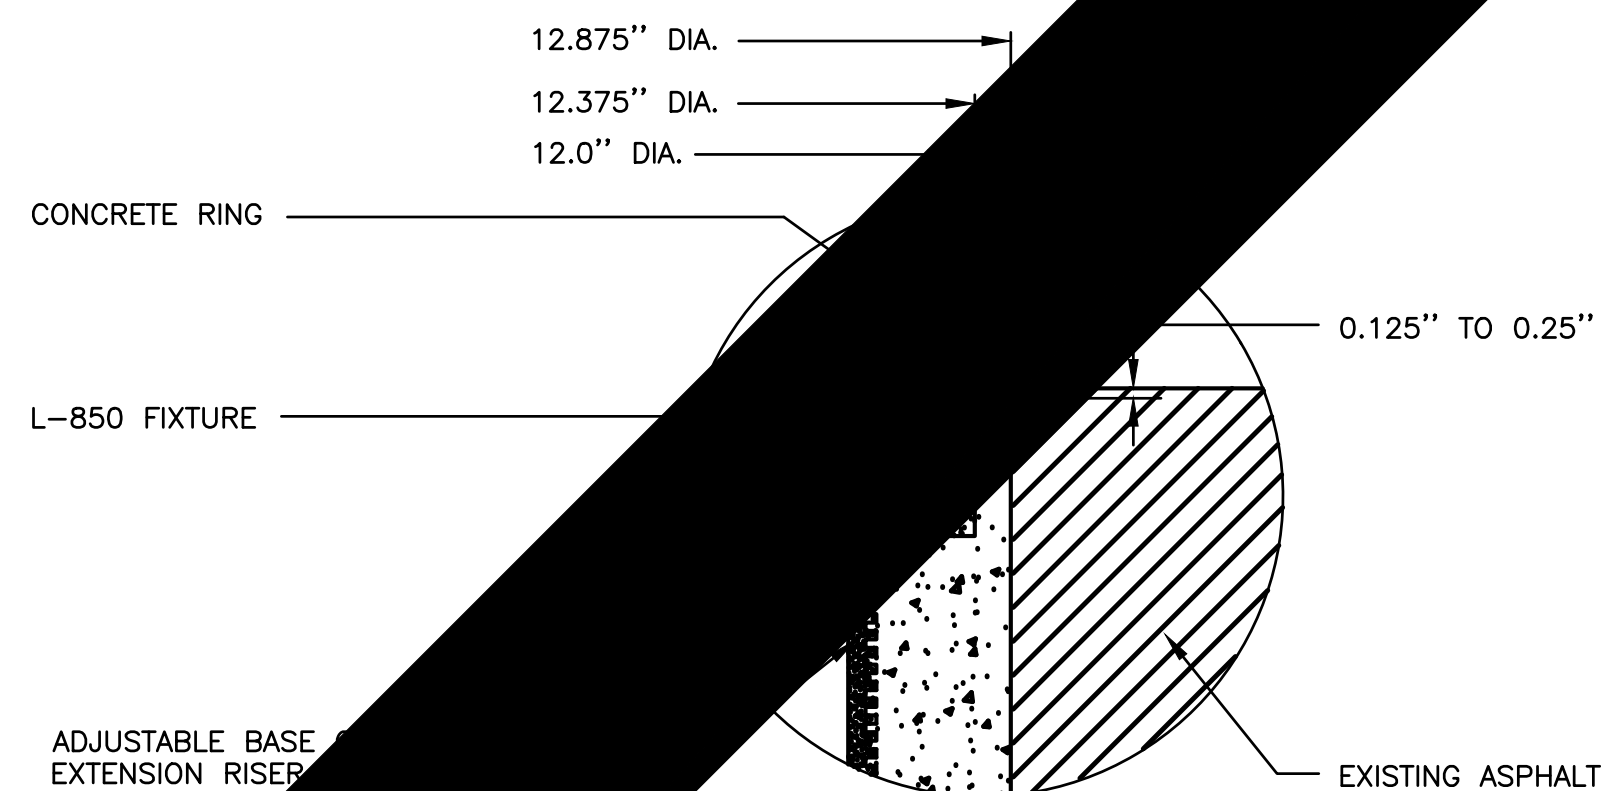


DETAIL "A"

N.T.S.

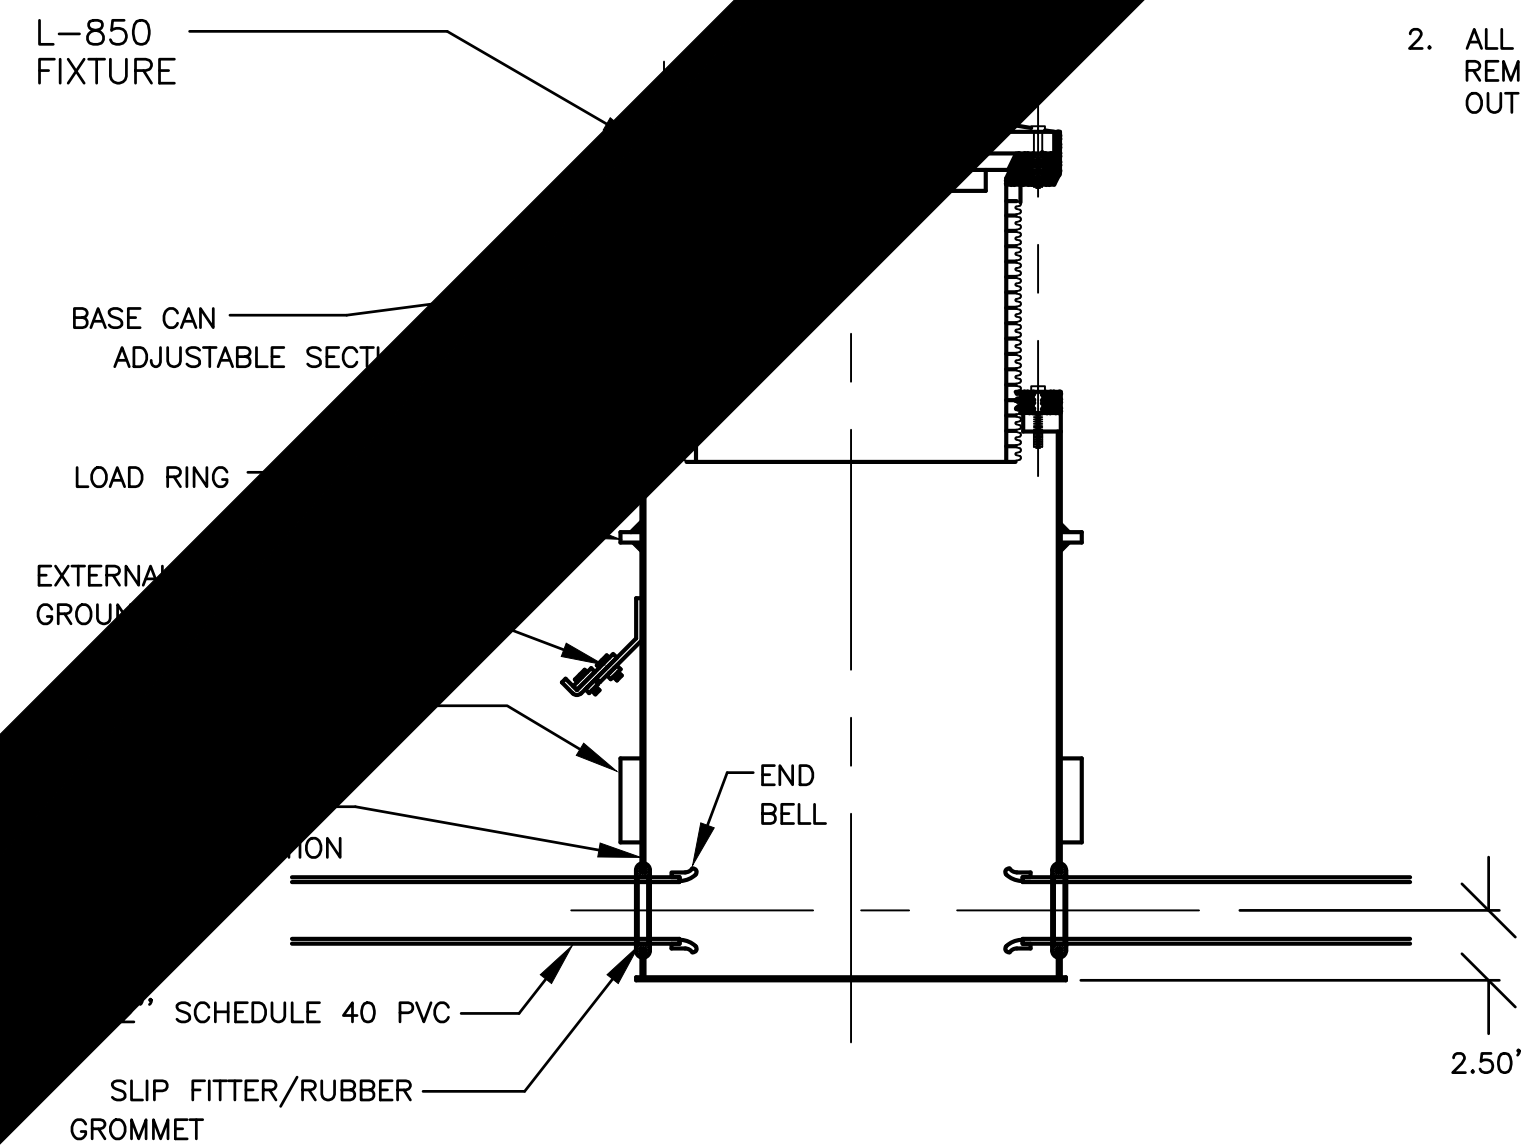

TYPICAL L-850 TWO PIECE ADJUSTABLE "SAFE" BASE CAN

N.T.S.

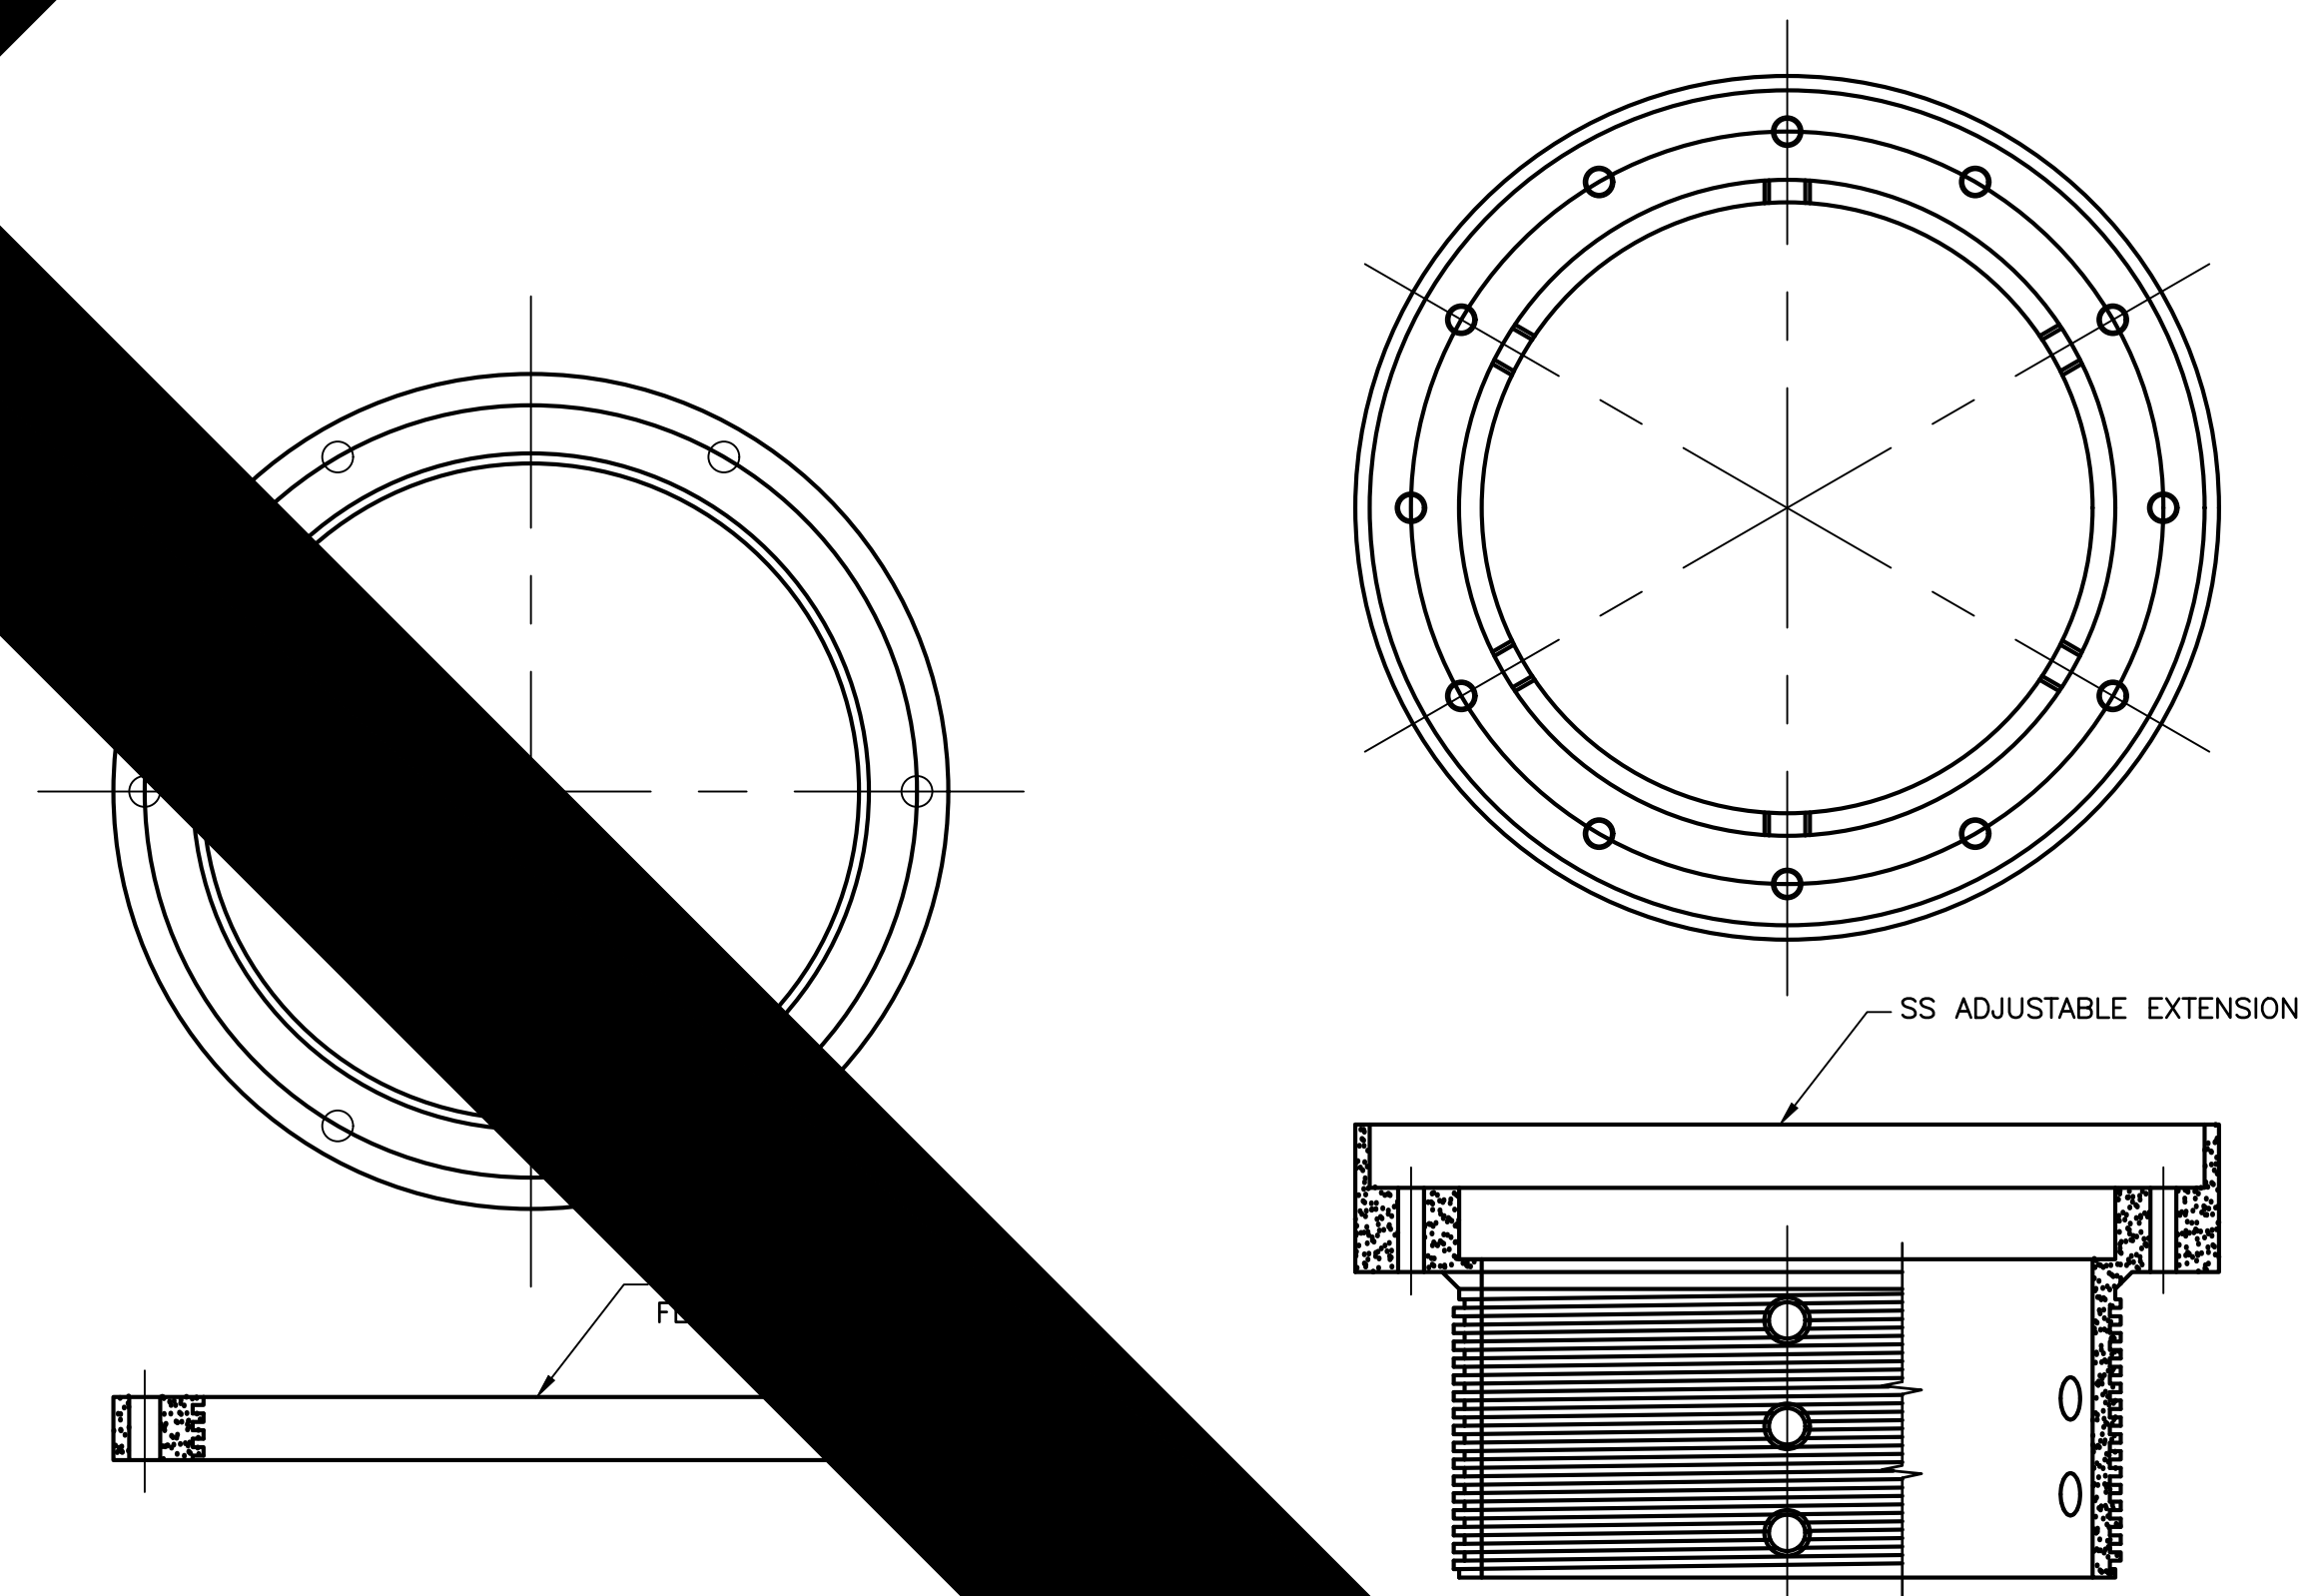

L-868B SAFE ADJUSTABLE BASE CAN WITH 12\"

NOTES:

1. THIS SHEET WITH DETAILS HAS BEEN INCLUDED TO PROVIDE THE CONTRACTOR WITH INFORMATION PERTINENT TO THE 'SAFE' CAN INSTALLATION IN ASPHALT PAVEMENT TO BE MILLED AND OVERLAY.
2. ALL 'SAFE' CAN INSTALLATIONS SHALL BE REMOVED FROM THE AIRFIELD BY CORING OUT THE EXISTING ASSEMBLY.



AVCON, INC.
ENGINEERS & PLANNERS

3298 SUMMIT BLVD., SUITE 26
PENSACOLA, FL 32503
OFFICE: (850) 688-3526
CORPORATE CERTIFICATE OF
AUTHORIZATION NUMBER: 5057
WWW.AVCONINC.COM

N:\MICHAEL-CAD\24035901_E533.dwg 4/11/2025 11:46 AM

TRANSFORMING TODAY'S IDEAS
INTO TOMORROW'S REALITY

NO.	DATE	REVISION	BY
1	4/25	ADDENDUM 3	SAH
2			
3			
4			
5			
6			
7			
8			
9			
10			

**SAFE BASE CAN
MITIGATION
DETAIL**

ISSUED FOR BID DRAWINGS

**RUNWAY 8-26
REHABILITATION**


PREPARED FOR
PENSACOLA INTERNATIONAL AIRPORT

DESIGNED BY: SAH
DRAWN BY: KJF
CHECKED BY: MAG
APPROVED BY: VCL
PROJECT NO: 24.0359.01
DATE: MARCH 28, 2025

SHEET NUMBER

E533

N:\359 CITY OF PENSACOLA-AIRPORT\2024.0359.01-PNS RUNWAY 8-26\000 CAD\24035901_E701.DWG 4/11/2025 11:47 AM

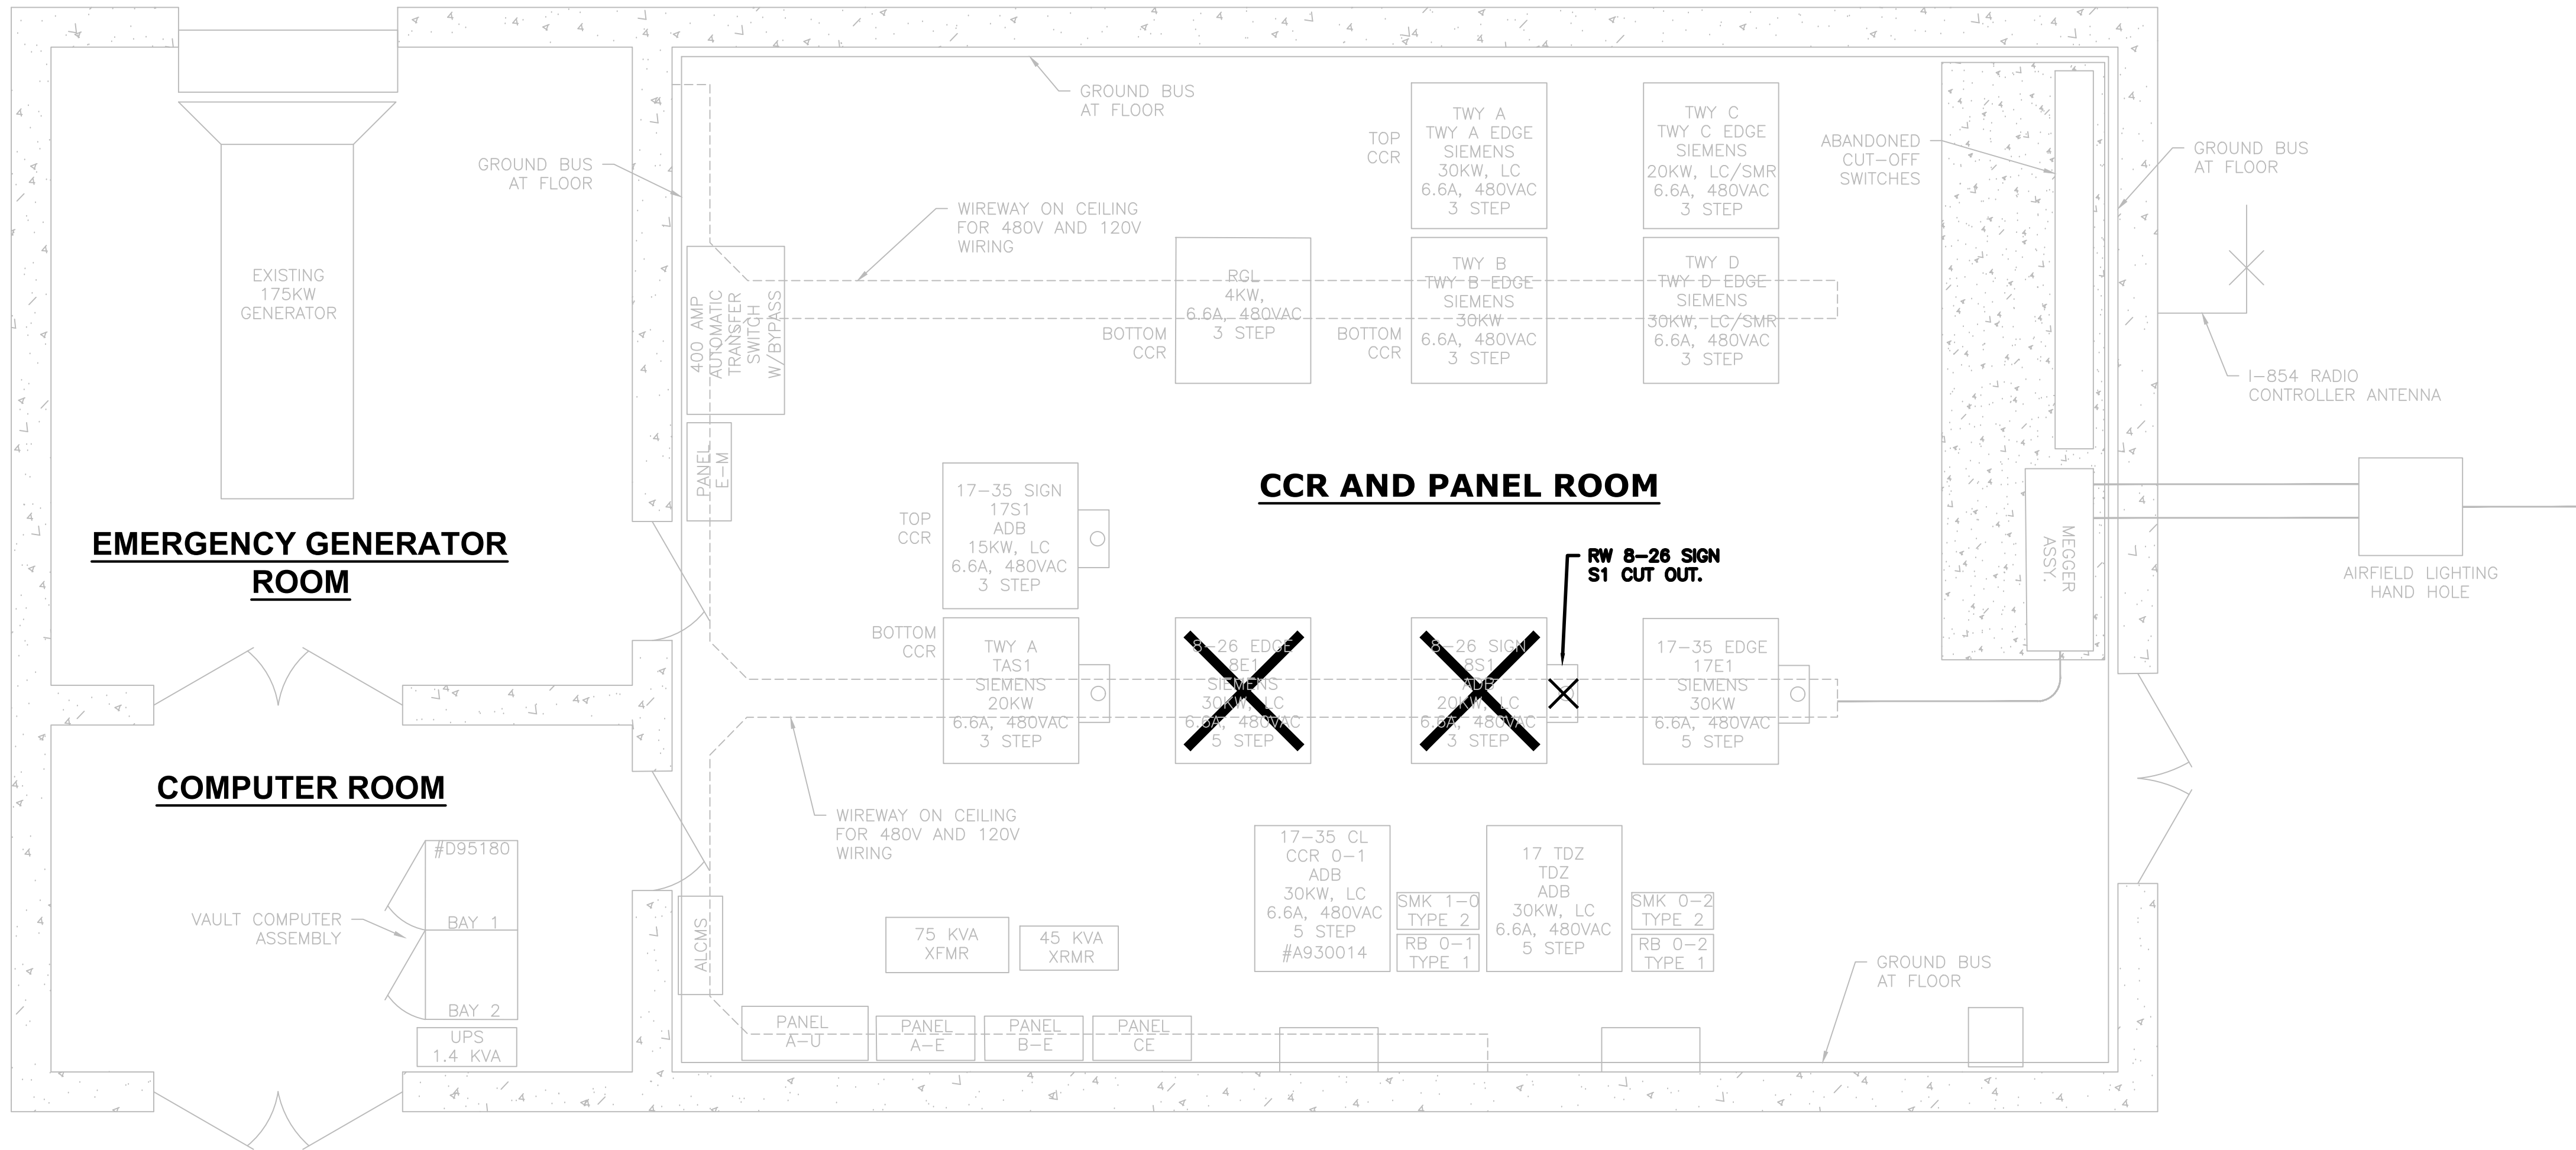

1

EXISTING AIRFIELD LIGHTING VAULT EQUIPMENT LAYOUT

EXISTING CCR S1 CUT OUT TO BE DEMOLISHED.



**EXISTING RUNWAY 8-26
SIGN CCR**



**EXISTING AIRFIELD LIGHTING VAULT
EQUIPMENT**



**EXISTING RUNWAY 8-26
EDGE LIGHT CCR**

1

AVCON, INC.
ENGINEERS & PLANNERS
3298 SUMMIT BLVD., SUITE 26
PENSACOLA, FL 32503
OFFICE: (850) 688-3526
CORPORATE CERTIFICATE OF
AUTHORIZATION NUMBER: 5057
WWW.AVCONINC.COM

TRANSFORMING TODAY'S IDEAS
INTO TOMORROW'S REALITY

NO.	DATE	REVISION	BY
1	4/25	ADDENDUM 3	SAH


**EXISTING AIRFIELD
LIGHTING VAULT**
ISSUED FOR BID DRAWINGS

**RUNWAY 8-26
REHABILITATION**
PREPARED FOR
PENSACOLA INTERNATIONAL AIRPORT

DESIGNED BY: SAH
DRAWN BY: KJF
CHECKED BY: MAG
APPROVED BY: VCL
PROJECT NO: 24.0359.01
DATE: MARCH 28, 2025

**SHEET NUMBER
E701**

N:\359 CITY OF PENSACOLA-AIRPORT\2024-0359.01-PNS RUNWAY 8-26\000 CAD\24035901_E702.DWG 4/11/2025 11:47 AM

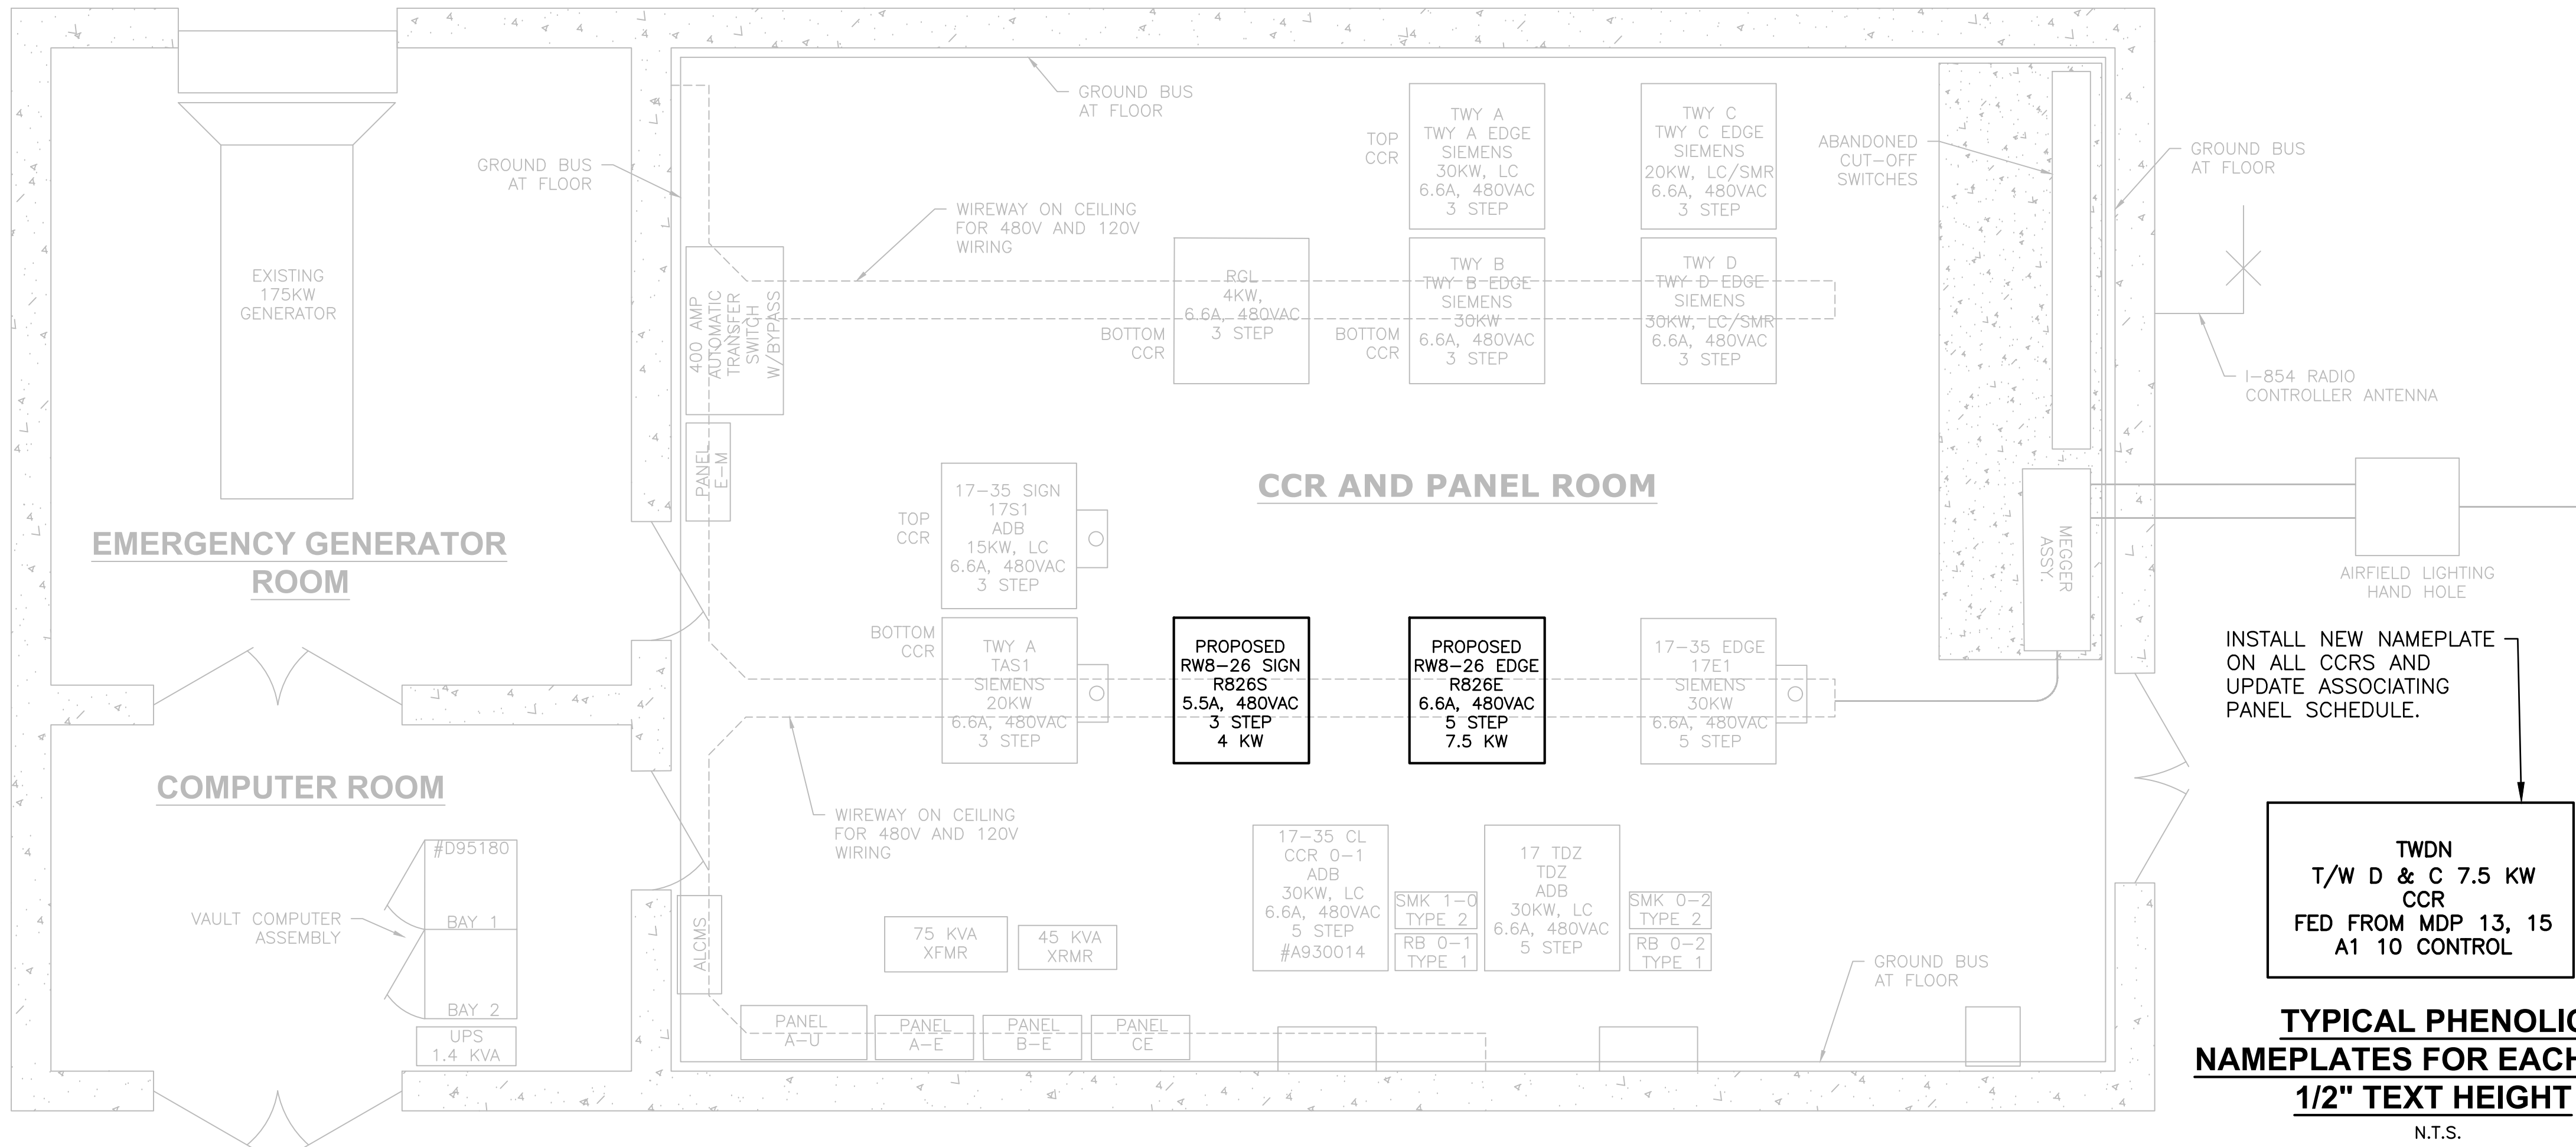

NOTES:

- THESE DOCUMENTS WERE DESIGNED IN ACCORDANCE WITH NFPA 70, NATIONAL ELECTRICAL CODE, 2020.
- ALL SERVICE AND DISTRIBUTION EQUIPMENT SHALL COMPLY WITH NFPA 70, NATIONAL ELECTRICAL CODE (NEC), AND SPECIFICALLY ARTICLES 110.9 AND 110.10 AND SHALL HAVE A MINIMUM UL LISTED INTEGRATED SHORT CIRCUIT RATING OF THE UPSTREAM DISTRIBUTION EQUIPMENT, OR VALUE AS NOTED IN THE CONTRACT DOCUMENTS, OR AS CALCULATED BY THE SHORT CIRCUIT/COORDINATION/ARC-FLASH HAZARD ANALYSIS, WHICHEVER VALUE IS GREATER.
- THIS CONTRACTOR SHALL FURNISH AND INSTALL ALL RECOMMENDED OVERCURRENT PROTECTION AND SHORT CIRCUIT PROTECTION REQUIRED BY THE NEC, EQUIPMENT MANUFACTURERS AND THESE DOCUMENTS AND SPECIFICATION. THE OVERCURRENT PROTECTION SHALL BE SIZED IN ACCORDANCE WITH THE MANUFACTURERS RECOMMENDATIONS AND THE NEC.
- UNLESS NOTED OTHERWISE, ALL WIRE SIZES ARE BASED ON A 75 DEG. C., THWN-2, 600 VOLT INSULATION, COPPER CONDUCTORS, NOT MORE THAN THREE SINGLE INSULATED CONDUCTORS, IN RACEWAY, IN FREE AIR. THE CONDUIT/DUCT SIZES ARE BASED ON THE USE OF THWN-2, 600 VOLT INSULATED CONDUCTORS. THE CONTRACTOR SHALL MAKE THE NECESSARY INCREASE IN CONDUIT/DUCT SIZES FOR OTHER TYPES OF WIRE INSULATION. IN NO CASE SHALL THE CONDUIT/DUCT SIZE BE REDUCED. THE MINIMUM POWER CIRCUIT WIRE SIZE SHALL BE 12 AWG COPPER. ALL ELECTRICAL CONDUCTORS SHALL BE COPPER.
- SPD WIRING SHALL BE IN ACCORDANCE WITH THE MANUFACTURER'S PUBLISHED INSTRUCTIONS. FOR TAP CONNECTIONS, INSTALLATIONS SHALL COMPLY WITH THE NEC ART. 240-21. SPD SHALL BE MANUFACTURED BY SURGE SUPPRESSION INCORPORATED OF DESTIN FLORIDA OR ACCEPTED EQUIVALENT. PRODUCT SHALL HAVE A 25 YEAR WARRANTY; VERIFY AND CONFIRM VOLTAGE/PHASE PRIOR TO SUBMITTAL.
- THE CONTRACTOR SHALL FURNISH AND INSTALL MAIN AND BRANCH CIRCUIT BREAKERS, PANELBOARDS AND EQUIPMENT CAPABLE OF ACCEPTING THE WIRE SIZES SHOWN ON THE CONTRACT DOCUMENTS. CONDUCTOR SIZES MAY HAVE BEEN ADJUSTED DUE TO VOLTAGE DROP OR OTHER ENGINEERING CONSIDERATIONS. THE CONTRACTOR SHALL PROVIDE EQUIPMENT CAPABLE OF ACCEPTING THE QUANTITY AND SIZES OF CONDUCTORS SHOWN IN THE CONTRACT DOCUMENTS. CONTRACTOR SHALL PROVIDE LUGS FOR EXISTING EQUIPMENT CAPABLE OF ACCEPTING THE QUANTITY AND SIZES OF CONDUCTORS SHOWN IN THE CONTRACT DOCUMENTS. ALL CONDUCTOR PIGTAILS, CABLE STEP-DOWN ADAPTERS, CABLE STEP-UP ADAPTERS, TERMINAL BLOCKS, SPLICING MATERIALS NECESSARY TO COMPLETE THE CABLE TERMINATION SHALL BE CONSIDERED INCIDENTAL TO THE PAY ITEMS PROVIDED.
- ALL BELOW GROUND CONDUITS SHALL BE SEALED TO PREVENT AIR CIRCULATION WITHIN THE ENCLOSURE/CABINET WITH THE OUTSIDE ATMOSPHERE.
- ALL GROUND RODS SHALL HAVE AN EARTH TO GROUND RESISTANCE OF 10 OHMS OR LESS. ALL CONNECTIONS OF CONDUCTORS TO GROUND RODS SHALL BE MADE BY EXOTHERMIC METHOD OR ACCEPTED EQUIVALENT.
- BOND ALL METALLIC RACEWAYS AND ENCLOSURES WITH A 2 AWG COPPER (MINIMUM SIZE) EQUIPMENT GROUNDING CONDUCTOR SIZED IN ACCORDANCE WITH THE NEC.


SHORT CIRCUIT / COORDINATION / DEVICE EVALUATION / ARC FLASH ANALYSIS NOTES:

CONTRACTOR SHALL, BASED UPON THE EQUIPMENT PROVIDED, INCLUDE AS PART OF THE SUBMITTAL PROCESS THE SYSTEM SHORT CIRCUIT CURRENT, COORDINATION STUDY AND ARC FLASH STUDY. THE STUDIES SHALL BE PERFORMED BY THE EQUIPMENT MANUFACTURER/SUPPLIER. A SHORT CIRCUIT, COORDINATION, DEVICE EVALUATION AND ARC FLASH ANALYSIS SHALL CONSIST OF THE TASKS LISTED BELOW:

- THIS ANALYSIS WILL INCLUDE: ONE LINE DIAGRAMS, SHORT CIRCUIT ANALYSIS, COORDINATION ANALYSIS AND ARC FLASH ANALYSIS AND LABELS.
- THE SELECTED FIRM'S FIELD SERVICE ENGINEER WILL PERFORM DATA GATHERING FOR ANALYSIS COMPLETION AND DEVICE SETTINGS, PERFORM DEVICE SETTING AS RECOMMENDED BY THE ANALYSIS AND WILL PROVIDE ARC FLASH LABELS WITH THE ARC FLASH ANALYSIS. THE COMPONENTS WORST CASE VALUE WILL BE CONSIDERED THE AVAILABLE ARC FLASH ENERGY AT THAT POINT IN THE SYSTEM. THE ARC FLASH LABELS WILL BE SIMILAR TO THE EXAMPLE BELOW. THE CONTRACTOR SHALL INSTALL THE NEW ARC FLASH LABELS.
- FIVE COPIES OF THE WRITTEN ANALYSIS AND DRAWINGS SHALL BE PROVIDED DURING THE EQUIPMENT SUBMITTAL PHASE. THREE COPIES SHALL BE ASSIGNED TO THE OWNER, TWO COPIES ASSIGNED TO THE ELECTRIC ENGINEER.

! WARNING	
Arc Flash and Shock Hazard	
Nominal System Voltage _____	Incident Energy (cal/cm ²) _____
Arc Flash Boundary _____	Working Distance _____
Limited Approach _____	OR
Restricted Approach _____	PPE Hazard Category _____
	Arc Rating of Clothing _____
Arc-rated PPE:	☐ Face shield ☐ Coverall
☐ Long-sleeve shirt ☐ Balaclava ☐ Hard hat liner	☐ Hard hat
☐ Flash suit jacket ☐ Gloves ☐	☐ Safety goggles ☐
☐ Flash suit pants ☐ Jacket ☐	☐ Safety glasses ☐
☐ Flash suit hood ☐ Parka ☐	☐ Hearing protection ☐
☐ Pants ☐ Rainwear ☐	☐ Heavy duty leather gloves ☐
☐ Leather footwear	
Equipment ID: _____	
BRADY® #145972 BRADYID.COM Y4118036	

ARC FLASH HAZARD LABEL

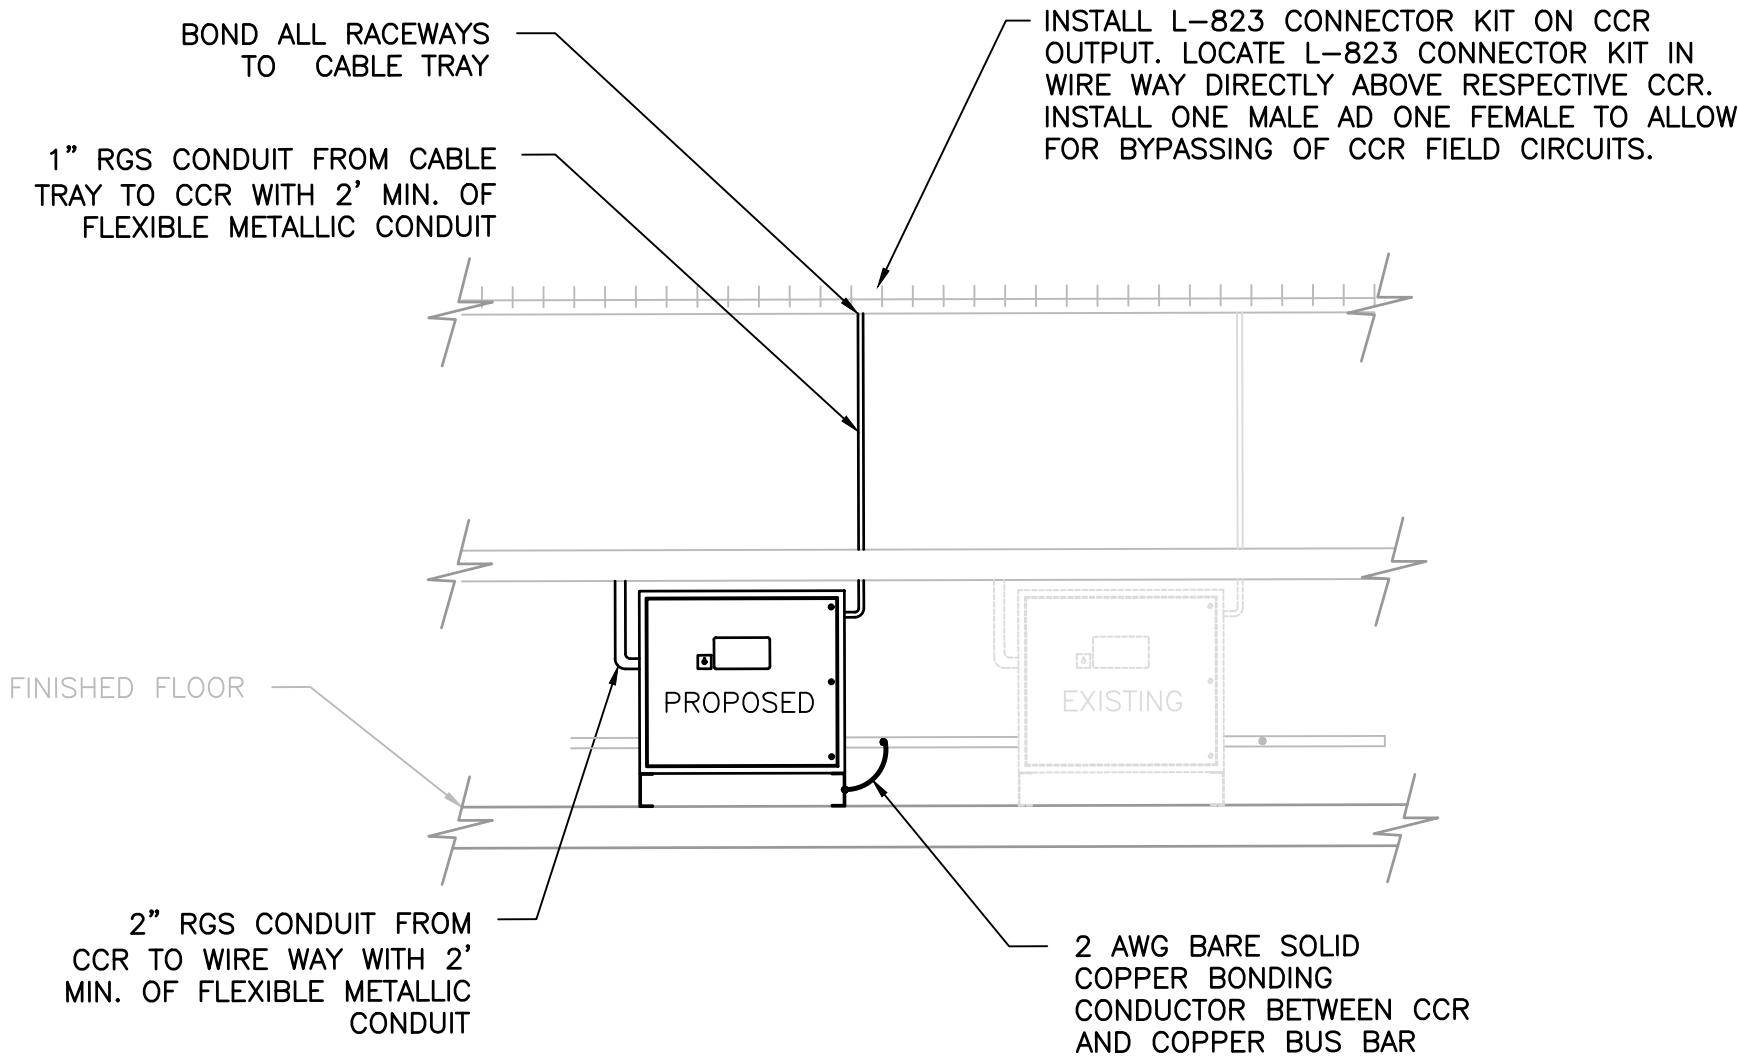

1

PROPOSED AIRFIELD LIGHTING VAULT LAYOUT

AVCON, INC.
ENGINEERS & PLANNERS

3298 SUMMIT BLVD., SUITE 26
PENSACOLA, FL 32503
OFFICE: (850) 688-3526
CORPORATE CERTIFICATE OF
AUTHORIZATION NUMBER: 5057
WWW.AVCONINC.COM

TRANSFORMING TODAY'S IDEAS
INTO TOMORROW'S REALITY

SAH

4/25

ADDENDUM 3

**PROPOSED
AIRFIELD
LIGHTING VAULT**
ISSUED FOR BID DRAWINGS

**RUNWAY 8-26
REHABILITATION**

PREPARED FOR
PENSACOLA INTERNATIONAL AIRPORT

DESIGNED BY: SAH
DRAWN BY: KJF
CHECKED BY: MAG
APPROVED BY: VCL
PROJECT NO: 24.0359.01
DATE: MARCH 28, 2025

SHEET NUMBER

E702

N:\359 CITY OF PENSACOLA-AIRPORT\2024-0359.01-PNS RUNWAY 8-26\000 CAD\24035901_E704.DWG 4/11/2025 11:47 AM

DESIGNATION: PANEL "EM" LOCATION: VOLTAGE: 480/277 VOLTS PHASE: 3 PHASE, 4 WIRE							MAIN: 300 AMP MAIN CIRCUIT BREAKER BUS RATING: PANEL MOUNTING: SURFACE AIC RATING:						
CKT. NO.	LOAD DESCRIPTION		CKT. BKR.		KVA			CKT. BKR.			LOAD DESCRIPTION	CKT. NO.	
		KVA	AMPS	POLE	A	B	C	AMPS	POLE	KVA			
1	R/W 17-35 EDGE LIGHTS "17E1"	E	100	2	E			✕	2	✕	R/W 8-26 ✕NS "8S1"	2	
3						E						4	
5	"CE" VIA XFMR 75KVA	E	125	3			E	20	3	E	SPARE	6	
7					E							8	
9						E						10	
11	TAXIWAY A SIGN "TAS1"	E	70	2			E	100	2	E	TAXIWAY D EDGE LIGHTS	12	
13					E							14	
15	MAYBE SPARE	E	50	2		E		50	2	E	R/W 17-35 SIGN "17S1"	16	
17							E					18	
19	R/W 8-2✕HIRL "8E1"	✕	1✕	2	E			--	--	--	SPACE	20	
21						E		--	--	--	SPACE	22	
23	CCR "RGL"	4.94	20	2			2.47	--	--	--	SPACE	24	
25					2.47			--	--	--	SPACE	26	
27	SPACE	--	--	--		0.00		--	--	--	SPACE	28	
29	SPACE	--	--	--			0.00	--	--	--	SPACE	30	
	TOTAL CONNECTED LOAD				2.47	0.00	2.47	TOTAL = 4.94					

EM_PANEL

DESIGNATION: PANEL "AM" LOCATION: VOLTAGE: 480/277 VOLTS PHASE: 3 PHASE, 4 WIRE							MAIN: BUS RATING: 400 AMP PANEL MOUNTING: SURFACE AIC RATING:					
CKT. NO.	LOAD DESCRIPTION	KVA	CKT. BKR.		KVA			CKT. BKR.		KVA	LOAD DESCRIPTION	CKT. NO.
			AMPS	POLE	A	B	C	AMPS	POLE			
1	"BE" VIA XFMR 45KVA	E	70	3	E	B	C	---	---	---	SPACE	2
3						E	30	3	E	TRASH COMPACTOR	4	
5											E	6
7	TAXIWAY B EDGE LIGHTS	E	90	2	E			70	2	E	R/W 17-35 CENTERLINE	8
9						E						10
11	TAXIWAY A EDGE LIGHTS	E	90	2			E	70	2	E	R/W 17-35 TOUCHDOWN LIGHTS	12
13					E							14
15	TAXIWAY C EDGE LIGHTS	E	60	2		E		---	---	---	SPACE	16
17							E					---
	TOTAL CONNECTED LOAD:				0.00	0.00	0.00	TOTAL = 0.00				

AM_PANEL

DESIGNATION: PANEL "CE" LOCATION: VOLTAGE: 208/120 VOLTS PHASE: 3 PHASE, 4 WIRE							MAIN: 300 AMP MAIN CIRCUIT BREAKER BUS RATING: 400 AMP PANEL MOUNTING: SURFACE AIC RATING:					
CKT. NO.	LOAD DESCRIPTION	KVA	CKT. BKR.		KVA			CKT. BKR.		KVA	LOAD DESCRIPTION	CKT. NO.
			AMPS	POLE	A	B	C	AMPS	POLE			
1	SPARE	E	90	2	E			20	1	E	ALPHA CONTROL	2
3						E		20	1	E	BRAVO CONTROL	4
5	ALCS COMPUTER	E	20	1			E	20	1	E	CHARLIE CONTROL	6
7	17E CONTROL	E	20	1	E			20	1	E	DELTA CONTROL	8
9	CAMERA	E	20	1		E		20	2	E	HEATER GEN BLOCK +BATT CHARGER	10
11	SPARE	E	20	1			E					12
13	RECEPTACLE REGULATOR RM	E	20	1	E			30	2	E	AC-1	14
15	SPARE	E	20	1		E						16
17	EXTERIOR LIGHT	E	20	1			E	30	2	E	AC-2	18
19	SPARE	E	20	1	E							20
21	SURGE PROTECTION	E	30	3		E		30	2	E	AC-3	22
23							E					
25								0.01			20	1
27	RVR RLIM	E	20	1		E		20	2	E	AC-4	28
29	TAS1 CONTROL	E	20	1			E					30
	TOTAL CONNECTED LOAD				0.01	0.00	0.00	TOTAL =		0.01		

CE_PANEL

DESIGNATION: PANEL "BE" LOCATION: VOLTAGE: 208/120 VOLTS PHASE: 3 PHASE, 4 WIRE								MAIN: BUS RATING: 400 AMP PANEL MOUNTING: SURFACE AIC RATING:					
CKT. NO.	LOAD DESCRIPTION	KVA	CKT. BKR.		KVA			CKT. BKR.		KVA	LOAD DESCRIPTION	CKT. NO.	
			AMPS	POLE	A	B	C	AMPS	POLE				
1	SPARES	E	90	2	E			--	--	--	SPACE	2	
3						E		20	1	E	UNKNOWN	4	
5							E	20	2	E	1-3 GATE	6	
7					E							8	
9	GEN RM LGT	E	20	1		E		20	1	E	SPARE	10	
11	WIND CONE LIGHTS	E	20	1			E	20	1	E	RADIO CONTROL	12	
13	RECEPTACLES	E	20	1	E			20	1	E	DAY TANK, BATT. CHG	14	
15	LIGHTS REG. ROOM	E	20	1		E		20	1	E	I-3 GATE CONTROL	16	
17	EXIT LIGHT	E	20	1			E	20	1	E	TDZ CONTROL	18	
TOTAL CONNECTED LOAD					0.00	0.00	0.00	TOTAL =		0.00			

BE_PANEL

NOTES:

1. NO DEMOLITION WORK REQUIRED FOR PANELS CE, AM AND BE. PANELS SHOWING FOR REFERENCE ONLY.
2. TO VERIFY EXISTING CONDITIONS BEFORE CONSTRUCTION.
3. UPDATE AND REPLACE PANEL SCHEDULE AND ADHESIVE SLEEVE WITHIN EXISTING EM PANEL.
4. SEE SHEET E702 FOR NEW CCR LOCATION.

EXISTING PANEL SCHEDULES



AVCON, INC.
ENGINEERS & PLANNERS
3298 SUMMIT BLVD., SUITE 26
PENSACOLA, FL 32503
OFFICE: (850) 688-3526
CORPORATE CERTIFICATE OF AUTHORIZATION NUMBER: 5057
WWW.AVCONINC.COM

N:\359 CITY OF PENSACOLA-AIRPORT\2024-0359.01-PNS RUNWAY 8-26\000 CAD\24035901_E704.DWG

TRANSFORMING TODAY'S IDEAS
INTO TOMORROW'S REALITY

SAH

ADDENDUM 3

4/25

NO.

DATE

REVISION

BY

EXISTING PANEL
SCHEDULES

ISSUED FOR BID DRAWINGS

RUNWAY 8-26
REHABILITATION

PREPARED FOR
PENSACOLA INTERNATIONAL AIRPORT

DESIGNED BY: SAH
DRAWN BY: KJF
CHECKED BY: MAG
APPROVED BY: VCL
PROJECT NO: 24.0359.01
DATE: MARCH 28, 2025

SHEET NUMBER
E704

N:\359 CITY OF PENSACOLA-AIRPORT\2024-0359.01-PNS RUNWAY 8-26\000 CAD\24035901_E705.DWG 4/11/2025 11:47 AM

DESIGNATION: PANEL "EM" LOCATION: VOLTAGE: 480/277 VOLTS PHASE: 3 PHASE, 4 WIRE								MAIN: 300 AMP MAIN CIRCUIT BREAKER BUS RATING: PANEL MOUNTING: SURFACE AIC RATING:				
CKT. NO.	LOAD DESCRIPTION	KVA	CKT. BKR.		KVA			CKT. BKR.		KVA	LOAD DESCRIPTION	CKT. NO.
			AMPS	POLE	A	B	C	AMPS	POLE			
1	R/W 17-35 EDGE LIGHTS "17E1"	E	100	2	E				2		CCR RW 8-26 SIGN (R826S)	2
3						E						4
5							E					6
7	"CE" VIA XFMR 75KVA	E	125	3	E			20	3	E	SPARE	8
9						E						10
11							E					12
13	TAXIWAY A SIGN "TAS1"	E	70	2	E			100	2	E	TAXIWAY D EDGE LIGHTS	14
15	MAYBE SPARE	E	50	2		E		50	2	E	R/W 17-35 SIGN "17S1"	16
17							E					18
19	CCR RW 8-26 (R826E)			2	E			--	--	--	SPACE	20
21						E		--	--	--	SPACE	22
23	CCR "RGL"	4.94	20	2			2.47	--	--	--	SPACE	24
25					2.47			--	--	--	SPACE	26
27	SPACE	--	--	--			0.00	--	--	--	SPACE	28
29	SPACE	--	--	--			0.00	--	--	--	SPACE	30
TOTAL CONNECTED LOAD					2.47	0.00	2.47	TOTAL = 4.94				

EM PANEL

DESIGNATION: PANEL "AM" LOCATION: VOLTAGE: 480/277 VOLTS PHASE: 3 PHASE, 4 WIRE							MAIN: BUS RATING: 400 AMP PANEL MOUNTING: SURFACE AIC RATING:					
CKT. NO.	LOAD DESCRIPTION	KVA	CKT. BKR.		KVA			CKT. BKR.		KVA	LOAD DESCRIPTION	CKT. NO.
			AMPS	POLE	A	B	C	AMPS	POLE			
1	"BE" VIA XFMR 45KVA	E	70	3	E	B	C	---	---	---	SPACE	2
3						E		30	3	E	TRASH COMPACTOR	4
5							E					6
7	TAXIWAY B EDGE LIGHTS	E	90	2	E			70	2	E	R/W 17-35 CENTERLINE	8
9						E						10
11							E					12
13	TAXIWAY A EDGE LIGHTS	E	90	2	E			70	2	E	R/W 17-35 TOUCHDOWN LIGHTS	14
15	TAXIWAY C EDGE LIGHTS	E	60	2		E						16
17								E	---	---	---	SPACE
	TOTAL CONNECTED LOAD:				0.00	0.00	0.00	TOTAL =		0.00		

AM PANEL

DESIGNATION: PANEL "CE" LOCATION: VOLTAGE: 208/120 VOLTS PHASE: 3 PHASE, 4 WIRE								MAIN: 300 AMP MAIN CIRCUIT BREAKER BUS RATING: 400 AMP PANEL MOUNTING: SURFACE AIC RATING:				
CKT. NO.	LOAD DESCRIPTION	KVA	CKT. BKR.		KVA			CKT. BKR.		KVA	LOAD DESCRIPTION	CKT. NO.
			AMPS	POLE	A	B	C	AMPS	POLE			
1	SPARE	E	90	2	E			20	1	E	ALPHA CONTROL	2
3						E		20	1	E	BRAVO CONTROL	4
5	ALCS COMPUTER	E	20	1			E	20	1	E	CHARLIE CONTROL	6
7	17E CONTROL	E	20	1	E			20	1	E	DELTA CONTROL	8
9	CAMERA	E	20	1		E		20	2	E	HEATER GEN BLOCK +BATT CHARGER	10
11	SPARE	E	20	1			E					12
13	RECEPTACLE REGULATOR RM	E	20	1	E			30	2	E	AC-1	14
15	SPARE	E	20	1		E						16
17	EXTERIOR LIGHT	E	20	1			E	30	2	E	AC-2	18
19	SPARE	E	20	1	E							20
21	SURGE PROTECTION	E	30	3		E		30	2	E	AC-3	22
23							E					24
25								0.01			20	1
27	RVR RLIM	E	20	1		E		20	2	E	AC-4	28
29	TAS1 CONTROL	E	20	1			E					30
	TOTAL CONNECTED LOAD				0.01	0.00	0.00	TOTAL =		0.01		

CE PANEL

DESIGNATION: PANEL "BE" LOCATION: VOLTAGE: 208/120 VOLTS PHASE: 3 PHASE, 4 WIRE								MAIN: BUS RATING: 400 AMP PANEL MOUNTING: SURFACE AIC RATING:				
CKT. NO.	LOAD DESCRIPTION	KVA	CKT. BKR.		KVA			CKT. BKR.		KVA	LOAD DESCRIPTION	CKT. NO.
			AMPS	POLE	A	B	C	AMPS	POLE			
1	SPARES	E	90	2	E			--	--	--	SPACE	2
3						E		20	1	E	UNKNOWN	4
5	SPARES	E	100	2			E	20	2	E	1-3 GATE	6
7					E							8
9	GEN RM LGT	E	20	1		E		20	1	E	SPARE	10
11	WIND CONE LIGHTS	E	20	1			E	20	1	E	RADIO CONTROL	12
13	RECEPTACLES	E	20	1	E			20	1	E	DAY TANK, BATT. CHG	14
15	LIGHTS REG. ROOM	E	20	1		E		20	1	E	I-3 GATE CONTROL	16
17	EXIT LIGHT	E	20	1			E	20	1	E	TDZ CONTROL	18
TOTAL CONNECTED LOAD					0.00	0.00	0.00	TOTAL =		0.00		

BE PANEL

NOTES:

- NO NEW WORK REQUIRED FOR PANELS CE, AM AND BE. PANELS SHOWING FOR REFERENCE ONLY.
- ARC FLASH HAZARD LABEL TYP. SEE NOTES AND DETAIL ON XXX. ARC FLASH TESTING SHALL BE INCIDENTAL TO THE HIGH MAST PAY ITEM.
- PHENOLIC NAMEPLATE 1/4" LETTERING TYP. FOR ALL NAMEPLATES. SEE NOTE 11 ON SHEET E511.
- PANEL SCHEDULE SHALL BE EATON CIRCUIT DIRECTORY OR ACCEPTED EQUIVALENT. CONTRACTOR SHALL UPDATE CIRCUIT DIRECTORY AND ADHESIVE SLEEVE WITHIN EXISTING PANEL.
- SEE SHEET E702 FOR NEW CCR LOCATION.

PROPOSED PANEL SCHEDULES

1

AVCON, INC.
ENGINEERS & PLANNERS
3298 SUMMIT BLVD., SUITE 26
PENSACOLA, FL 32503
OFFICE: (850) 688-3526
CORPORATE CERTIFICATE OF
AUTHORIZATION NUMBER: 5057
WWW.AVCONINC.COM

N:\359 CITY OF PENSACOLA-AIRPORT\2024-0359.01-PNS RUNWAY 8-26\000 CAD\24035901_E705.DWG

TRANSFORMING TODAY'S IDEAS
INTO TOMORROW'S REALITY

4/25 ADDENDUM 3

PROPOSED MDP
PANEL DIAGRAM

ISSUED FOR BID DRAWINGS

RUNWAY 8-26
REHABILITATION

PREPARED FOR
PENSACOLA INTERNATIONAL AIRPORT

DESIGNED BY: SAH
DRAWN BY: KJF
CHECKED BY: MAG
APPROVED BY: VCL
PROJECT NO: 24.0359.01
DATE: MARCH 28, 2025

SHEET NUMBER
E705

THIS DOCUMENT CONTAINS PRIVILEGED AND PROPRIETARY INFORMATION. ALL OF WHICH IS EXPRESSLY PROVIDED BY AVCON, INC., FOR USE BY THE INTENDED RECIPIENT, AND FOR A SPECIFIC PURPOSE. WITHOUT THE EXPRESS WRITTEN CONSENT OF AVCON, INC. ANY DISTRIBUTION, REPRODUCTION OR OTHER USE OF THIS DOCUMENT, IN WHOLE OR IN PART, IS STRICTLY PROHIBITED.