


N:\NICEVILLE-PROJECTS\359 CITY OF PENSACOLA-AIRPORT\2024-0359.01-PNS RUNWAY 8-26\000 CAD\24035901_OVERALL DRAINAGE PLAN.DWG 4/23/2025 2:45 PM

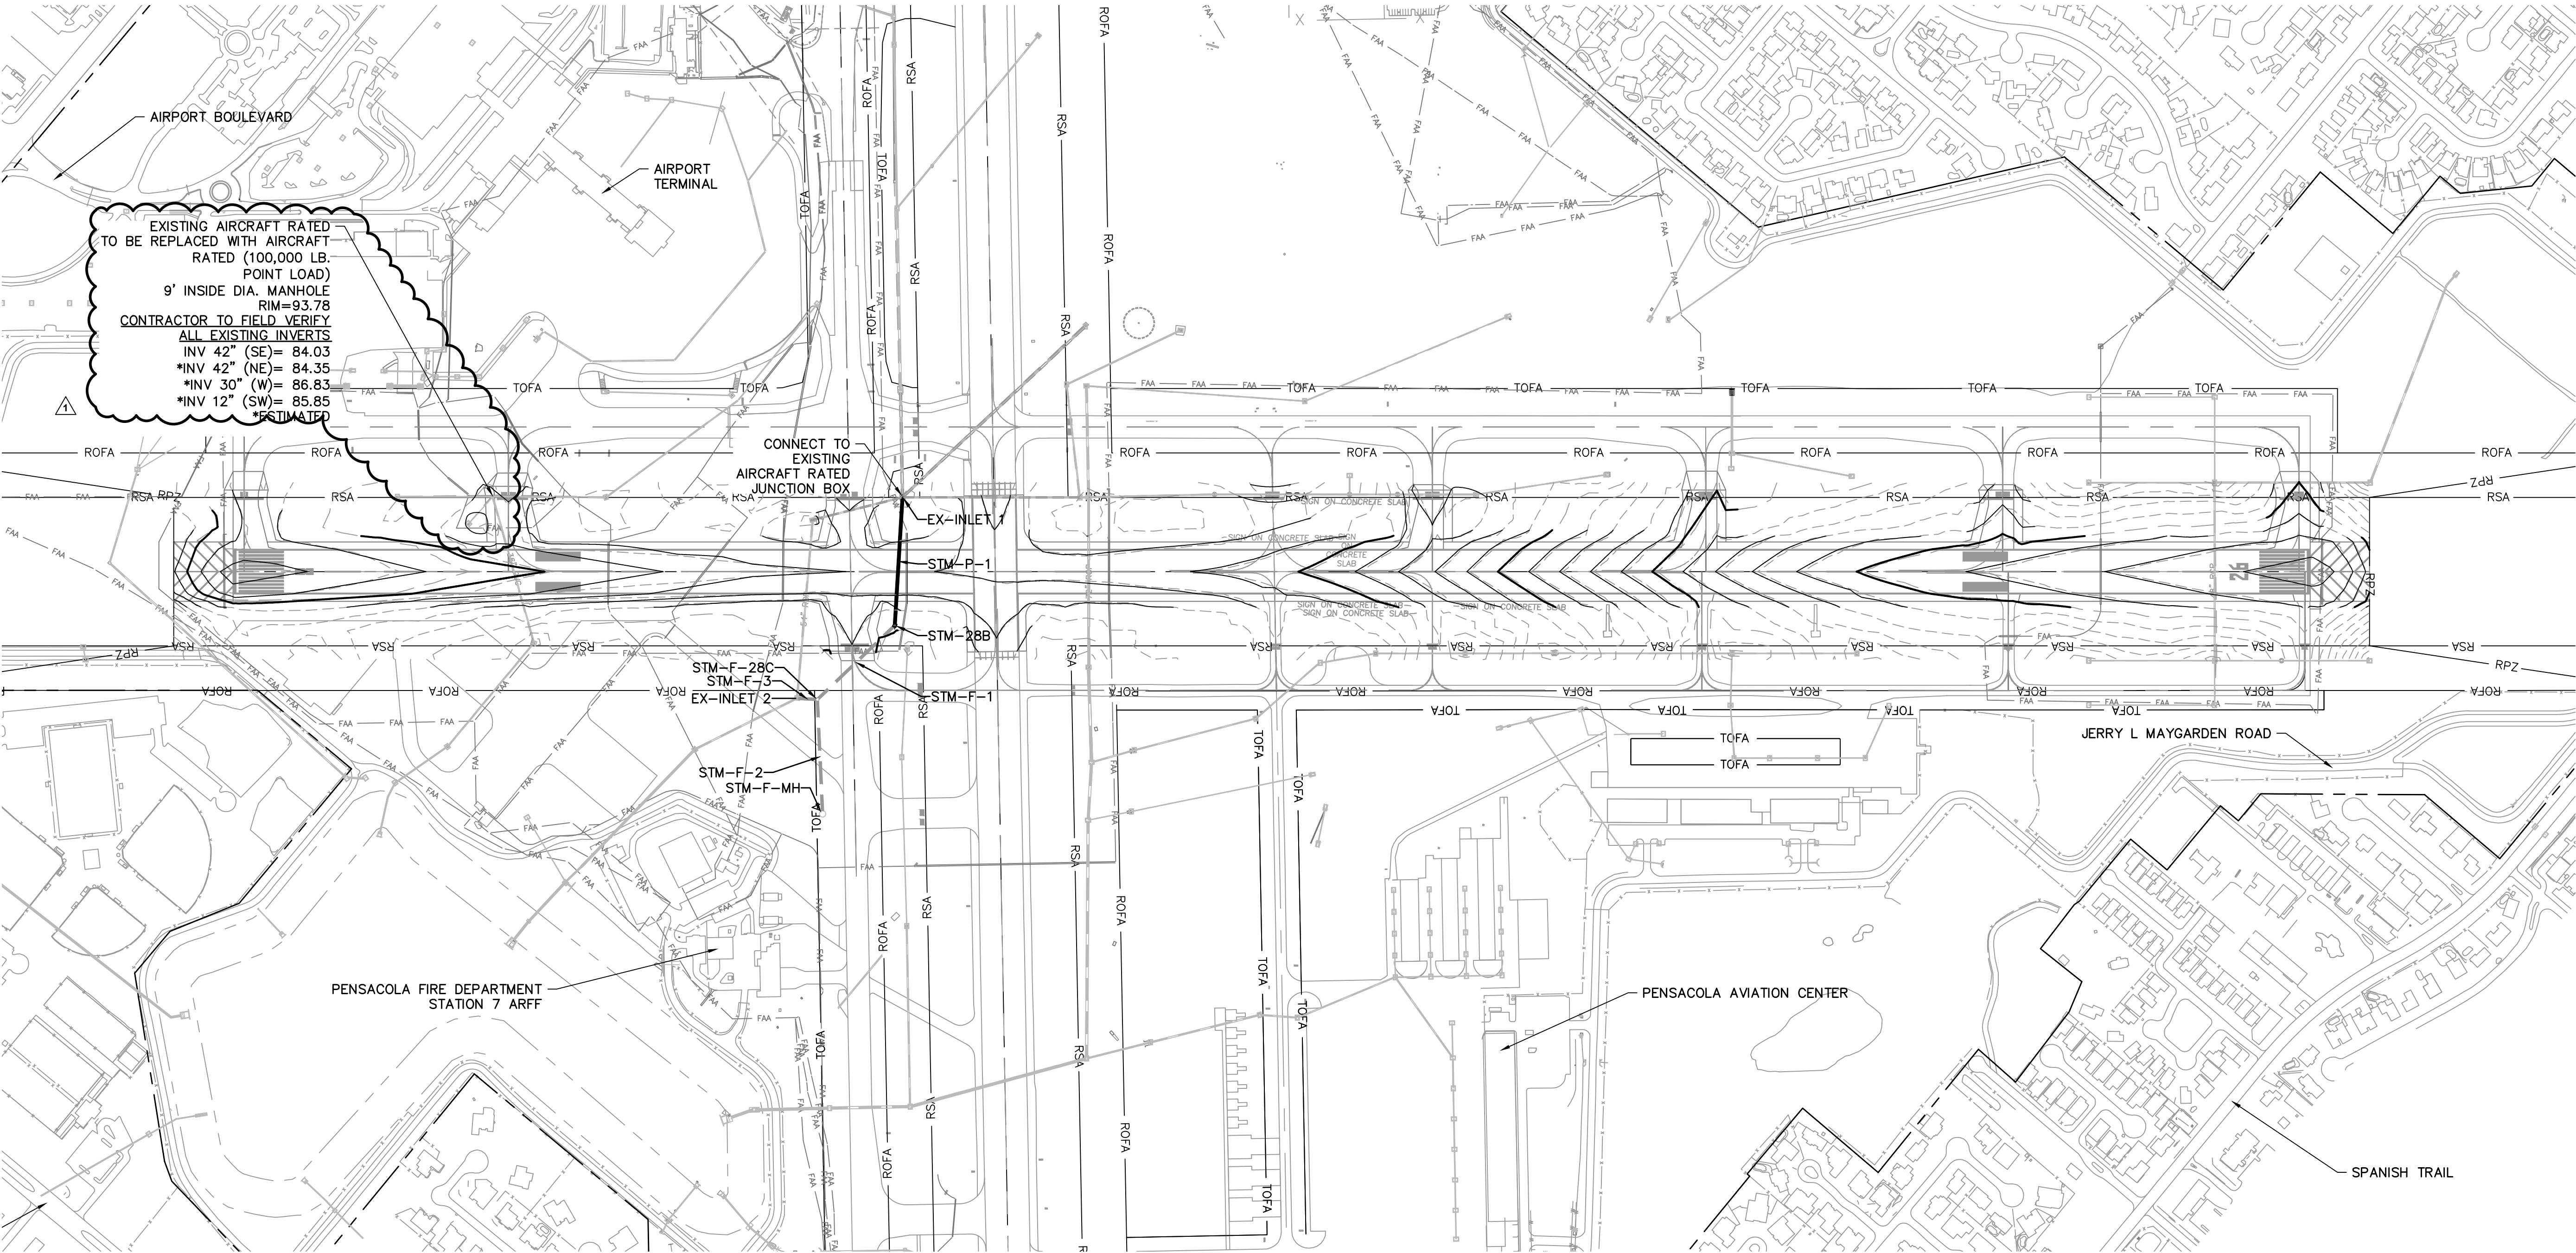

DRAINAGE NOTES:

- CONTRACTOR SHALL NOTIFY THE ENGINEER IF EROSION CONTROL ISSUES DEVELOP ONSITE.
- CONTRACTOR SHALL BE RESPONSIBLE FOR EROSION CONTROL MEASURES ON SITE 24 HOURS A DAY THROUGHOUT CONSTRUCTION.
- ALL DISTURBED AREAS (INCLUDING RE-GRADED AREA) SHALL BE RETURNED TO ORIGINAL CONDITION.
- EXCAVATION LIKELY TO DISLOCATE, DAMAGE, OR IMPAIR THE STRENGTH OF OTHER STRUCTURES ALREADY IN PLACE SHALL BE DONE ONLY AFTER ADEQUATE PROTECTION HAS BEEN PROVIDED FOR THE IN-PLACE STRUCTURES.
- UNPAVED AREAS SHALL BE GRADED TO PROMOTE POSITIVE DRAINAGE TO THE STORMWATER DETENTION AREA OR ASSOCIATED INLET.

STORMWATER STRUCTURE TABLE			
STRUCTURE NAME	STRUCTURE TYPE	DETAILS	NORTHING/EASTING
EX-INLET 1	EXISTING AIRCRAFT RATED INLET	RIM = 90.93 STM-EX-2 INV IN = 82.29 STM-EX-3 INV IN = 79.85 STM-EX-4 INV IN = 80.85 STM-P-1 INV OUT = 79.85 STM-EX-1 INV OUT = 82.00	N: 545788.88 E: 1121430.7019
EX-INLET 2	EXISTING 16.5'X16.5' MANHOLE W/ J BOTTOM	RIM = 86.40 STM-F-3 INV IN = 76.50	N: 545057.96 E: 1121206.5400
STM-28B	10'x10" MANHOLE W/J BOTTOM	RIM = 90.28 STM-P-1 INV IN = 78.34 STM-F-1 INV OUT = 78.34	N: 545360.07 E: 1121484.5600
STM-F-28C	FUTURE 16.5'X16.5' MANHOLE W/J BOTTOM	RIM = 86.50 STM-F-1 INV IN = 77.70 STM-F-3 INV OUT = 77.70 STM-F-2 INV OUT = 77.54	N: 545067.00 E: 1121273.8400
STM-F-MH	FUTURE 12' DIA. MANHOLE W/J BOTTOM	RIM = 84.67 STM-F-2 INV IN = 75.90	N: 544690.92 E: 1121362.1000

STORMWATER PIPE TABLE			
NAME	DESCRIPTION	LENGTH	SLOPE
STM-EX-1	EXISTING 48" CL V RCP	308.84'	0.68%
STM-EX-2	EXISTING 48" CL V RCP	595.84'	0.63%
STM-EX-3	EXISTING 84" CL V RCP	351.61'	1.18%
STM-EX-4	EXISTING 72" CL V RCP	839.40'	0.78%
STM-F-1	FUTURE 84" CL V RCP	360.96'	0.18%
STM-F-2	FUTURE 84" CL V RCP	386.30'	0.42%
STM-F-3	FUTURE 84" CL V RCP	67.90'	1.77%
STM-P-1	84" CL V RCP	432.18'	0.35%

CALL 2 WORKING
DAYS BEFORE YOU DIG


IT'S THE LAW!
DIAL 811

Know what's below.
Call before you dig.

SUNSHINE STATE ONE CALL OF FLORIDA, INC.

LEGEND

- RPZ — RUNWAY PROTECTION ZONE
- RSA — RUNWAY SAFETY AREA
- ROFA — RUNAWAY OBJECT FREE AREA
- TOFA — TAXIWAY/TAXILANE OBJECT FREE AREA
- FAA — EXISTING FAA FIBER OPTIC LINES PER RECORD DRAWINGS
- EXISTING PAVEMENT
- EXISTING STORM PIPE
- PROPOSED STORM PIPE
- EXISTING STORM INLET
- PROPOSED STORM JUNCTION BOX

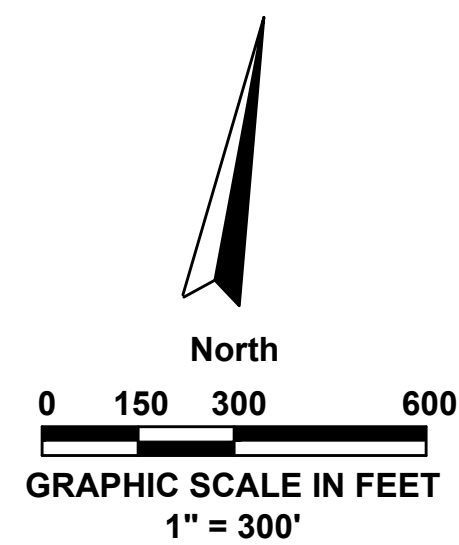

OVERALL DRAINAGE PLAN

ISSUED FOR BID DRAWINGS

RUNWAY 8-26 REHABILITATION



PREPARED FOR
PENSACOLA INTERNATIONAL AIRPORT

DESIGNED BY: THJ
DRAWN BY: JLW
CHECKED BY: THJ
APPROVED BY: VCL
PROJECT NO: 24.0359.01
DATE: MARCH 28, 2025

SHEET NUMBER

C-6

AVCON, INC.
ENGINEERS & PLANNERS
3298 SUMMIT BLVD., SUITE 26
PENSACOLA, FL 32503
OFFICE: (850) 688-3526
CORPORATE CERTIFICATE OF
AUTHORIZATION NUMBER: 5057
WWW.AVCONINC.COM

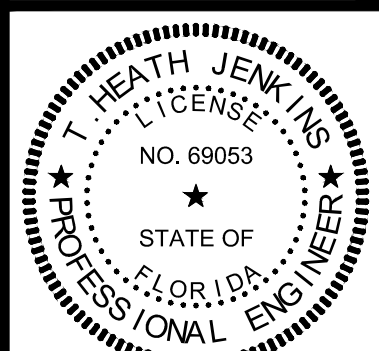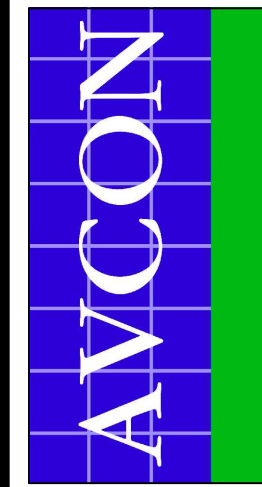

T. HEATH JENKINS
FL LICENSE NO.: 69053
FBPR CERTIFICATE OF
AUTHORIZATION NO. 5057

NO.	DATE	REVISION	BY
1	4-22-25		JLW

THIS DOCUMENT CONTAINS PRIVILEGED AND PROPRIETARY INFORMATION, ALL OF WHICH IS EXPRESSLY PROVIDED BY AVCON, INC., FOR USE BY THE INTENDED RECIPIENT, AND FOR A SPECIFIC PURPOSE. WITHOUT THE EXPRESS WRITTEN CONSENT OF AVCON, INC., ANY DISTRIBUTION, REPRODUCTION, OR OTHER USE OF THIS DOCUMENT, IN WHOLE OR IN PART, IS STRICTLY PROHIBITED.